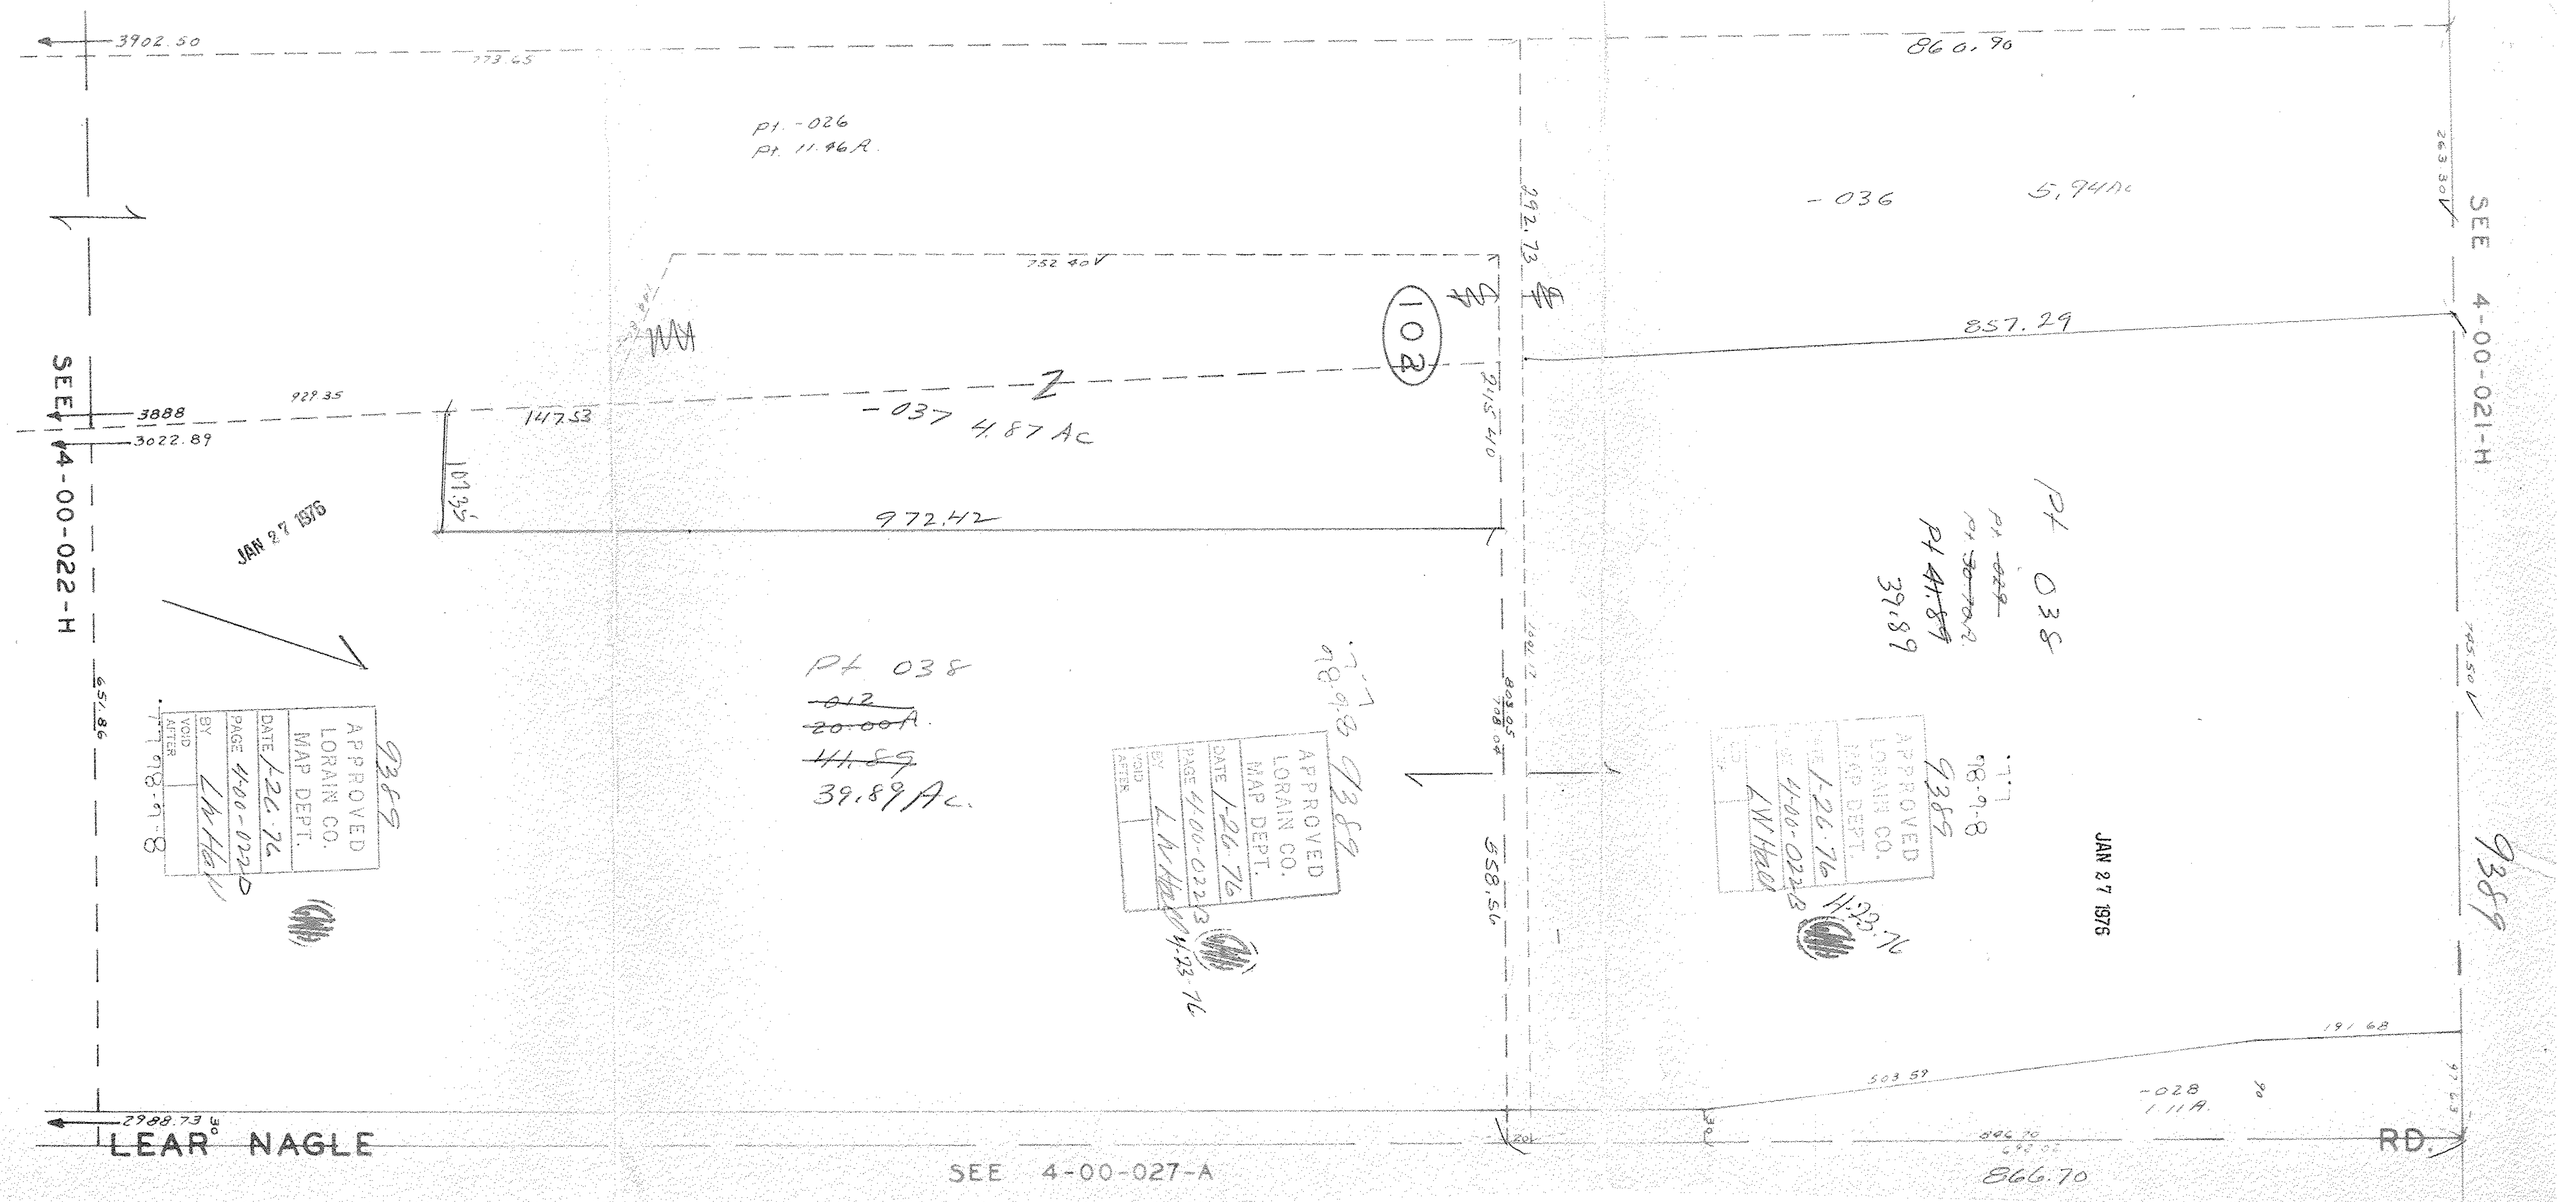

3902.50
773.65
860.90
Pt. -026
Pt. 11.46A.
-036
5.94Ac
292.73
752.40
102
857.29
SEE 4-00-021-H
SEE 4-00-022-H
3888
3022.89
929.35
147.53
-037 4.87 Ac
215.40
101.35
972.42
JAN 27 1976
Pt 038
~~-012~~
~~20.00A.~~
~~41.89~~
39.89 Ac.
Pt 038
~~Pt. -029~~
~~Pt. 30.70A.~~
Pt ~~41.89~~
39.89
9389
APPROVED
LORAIN CO.
MAP DEPT.
DATE 1-26-76
PAGE 4-00-022-D
BY LWHall
VOID AFTER
98-9-8
9389
APPROVED
LORAIN CO.
MAP DEPT.
DATE 1-26-76
PAGE 4-00-022-B
BY LWHall
VOID AFTER
4-23-76
9389
APPROVED
LORAIN CO.
MAP DEPT.
DATE 1-26-76
PAGE 4-00-022-B
BY LWHall
VOID AFTER
4-23-76
JAN 27 1976
9389
651.86
558.56
191.68
503.59
-028
1.11A.
2988.73
LEAR NAGLE
RD.
SEE 4-00-027-A
866.70