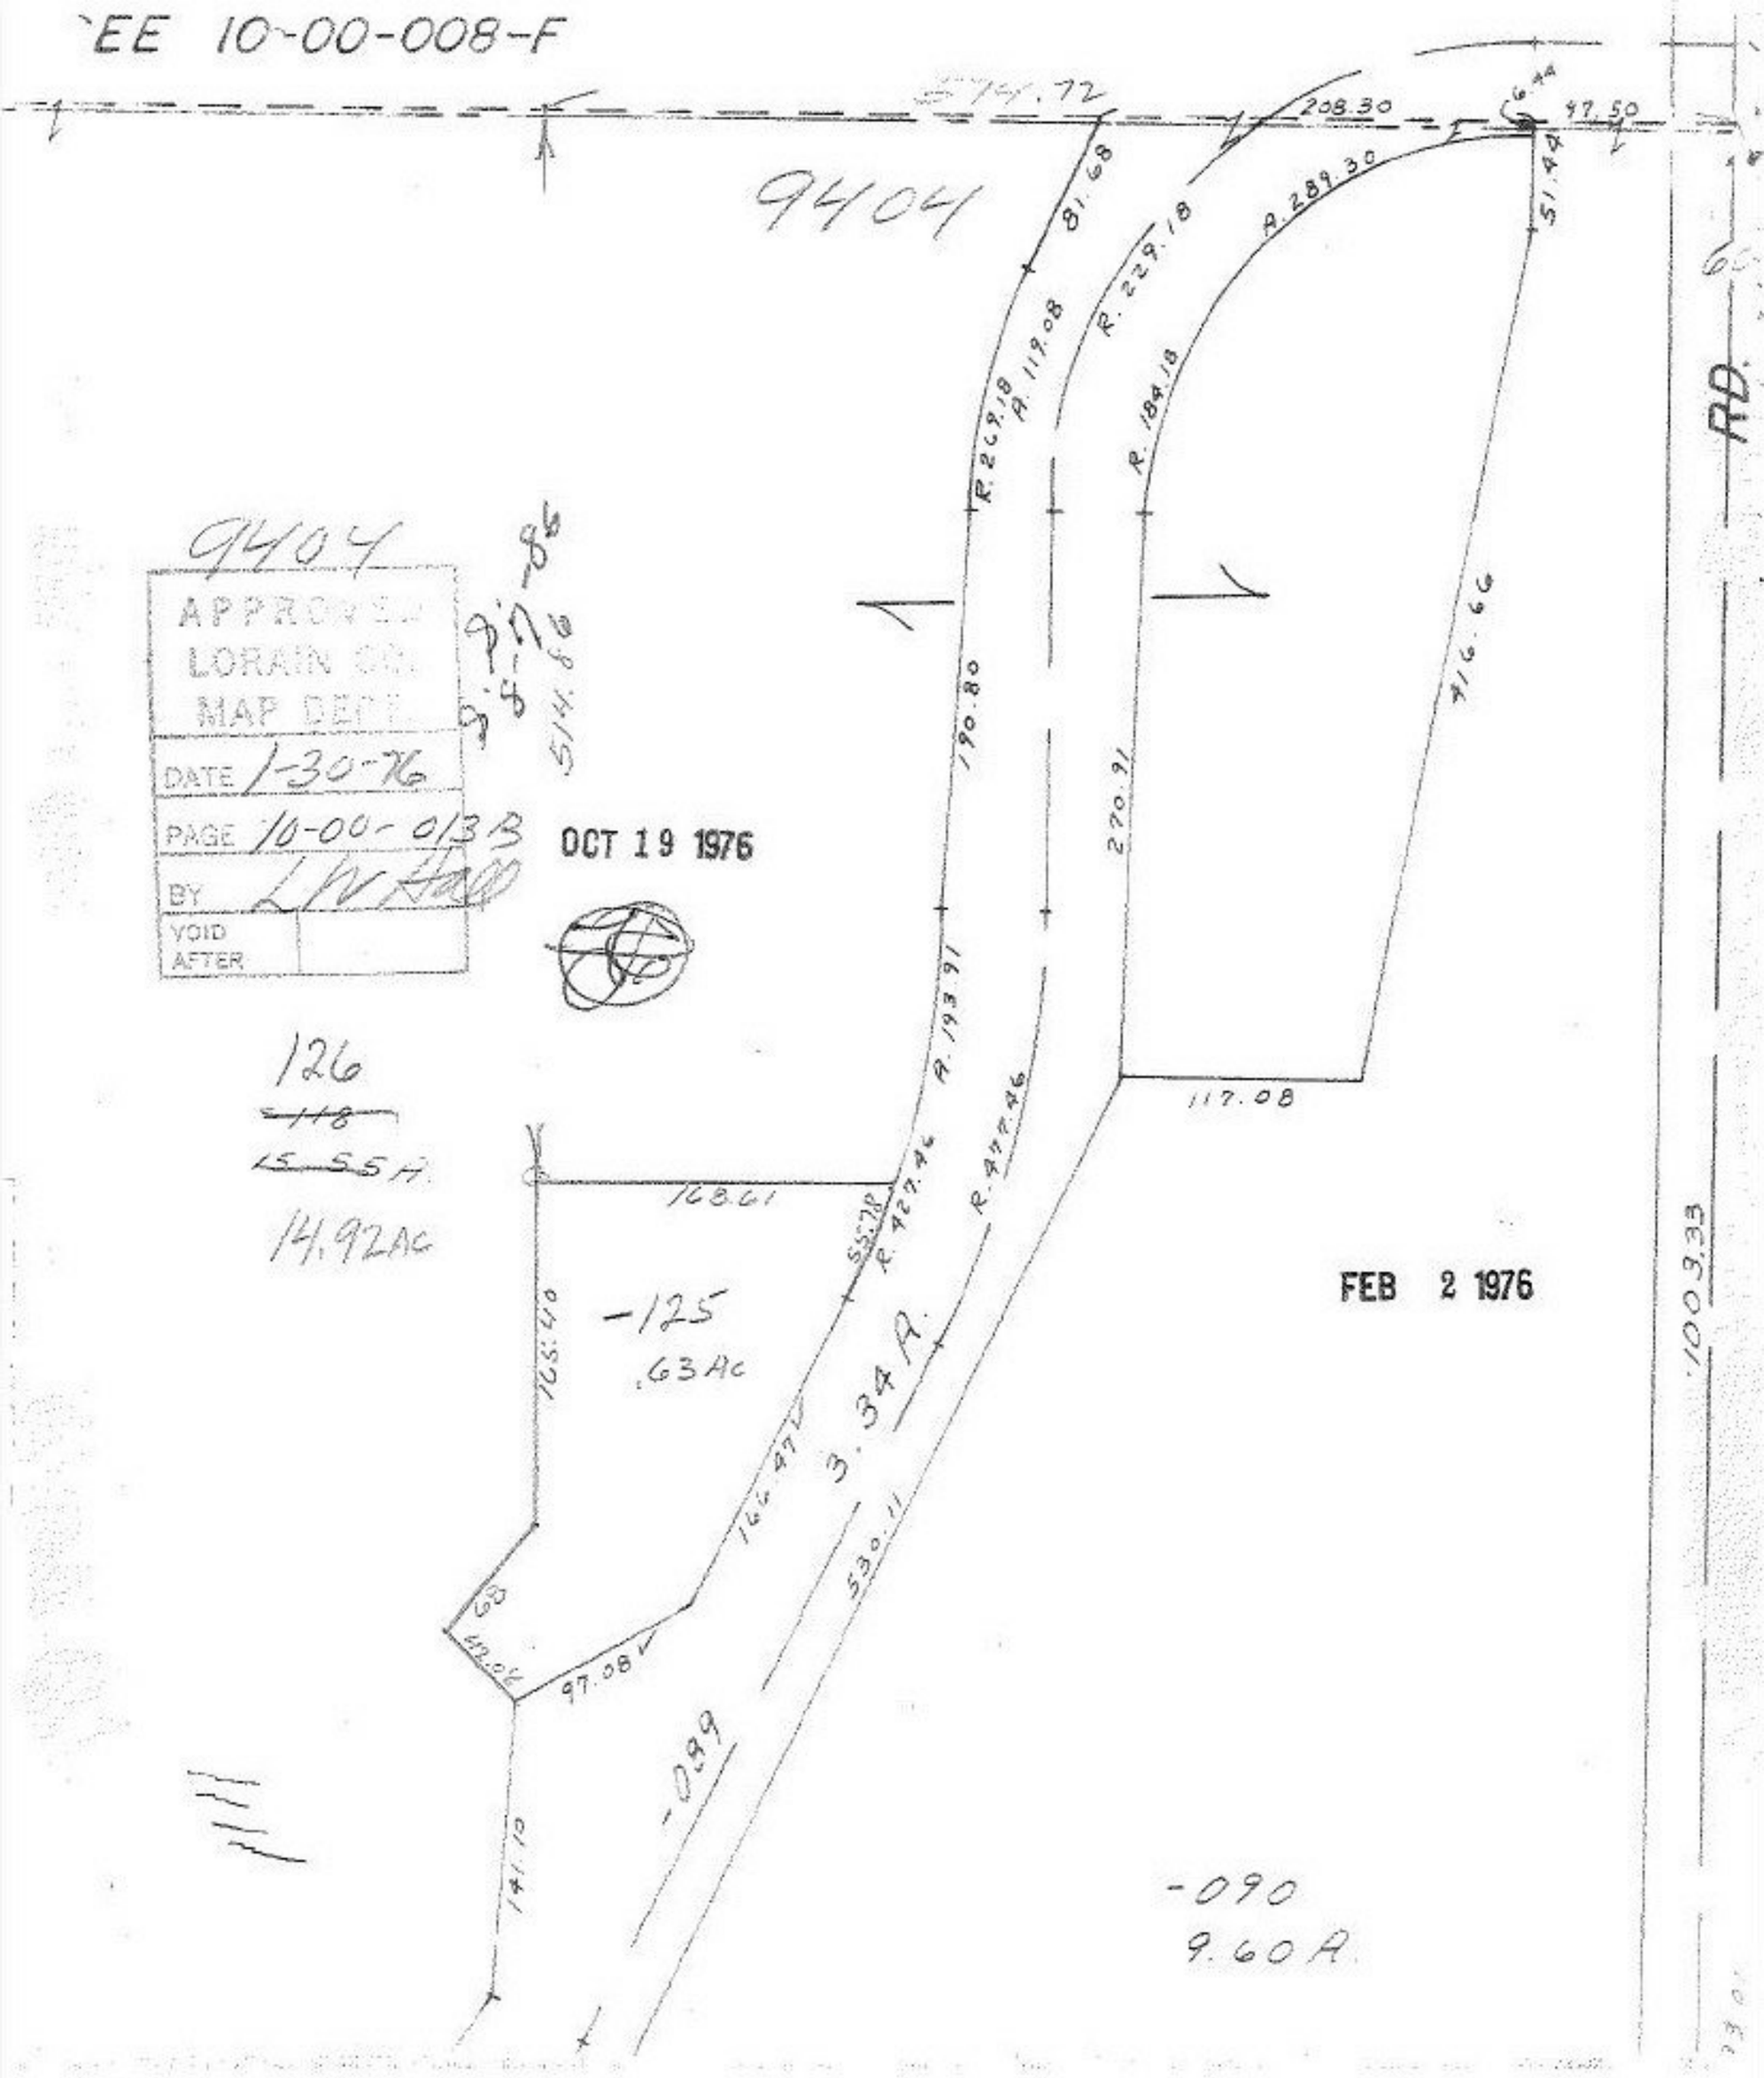

EE 10-00-008-F
9404
9404
APPROVED
LORAIN CO.
MAP DEPT.
DATE 1-30-76
PAGE 10-00-013B
BY
VOID AFTER
OCT 19 1976
126
~~118~~
~~15.55A~~
14.92Ac
-125
.63Ac
FEB 2 1976
3.34A.
-089
-090
9.60A.
RD.
208.30
47.50
81.68
R.229.18
A.289.30
51.44
R.269.18
A.119.08
R.184.18
190.80
270.91
416.66
A.193.91
117.08
168.61
R.427.46
R.477.46
165.40
166.47
530.11
97.08
141.10
1003.33