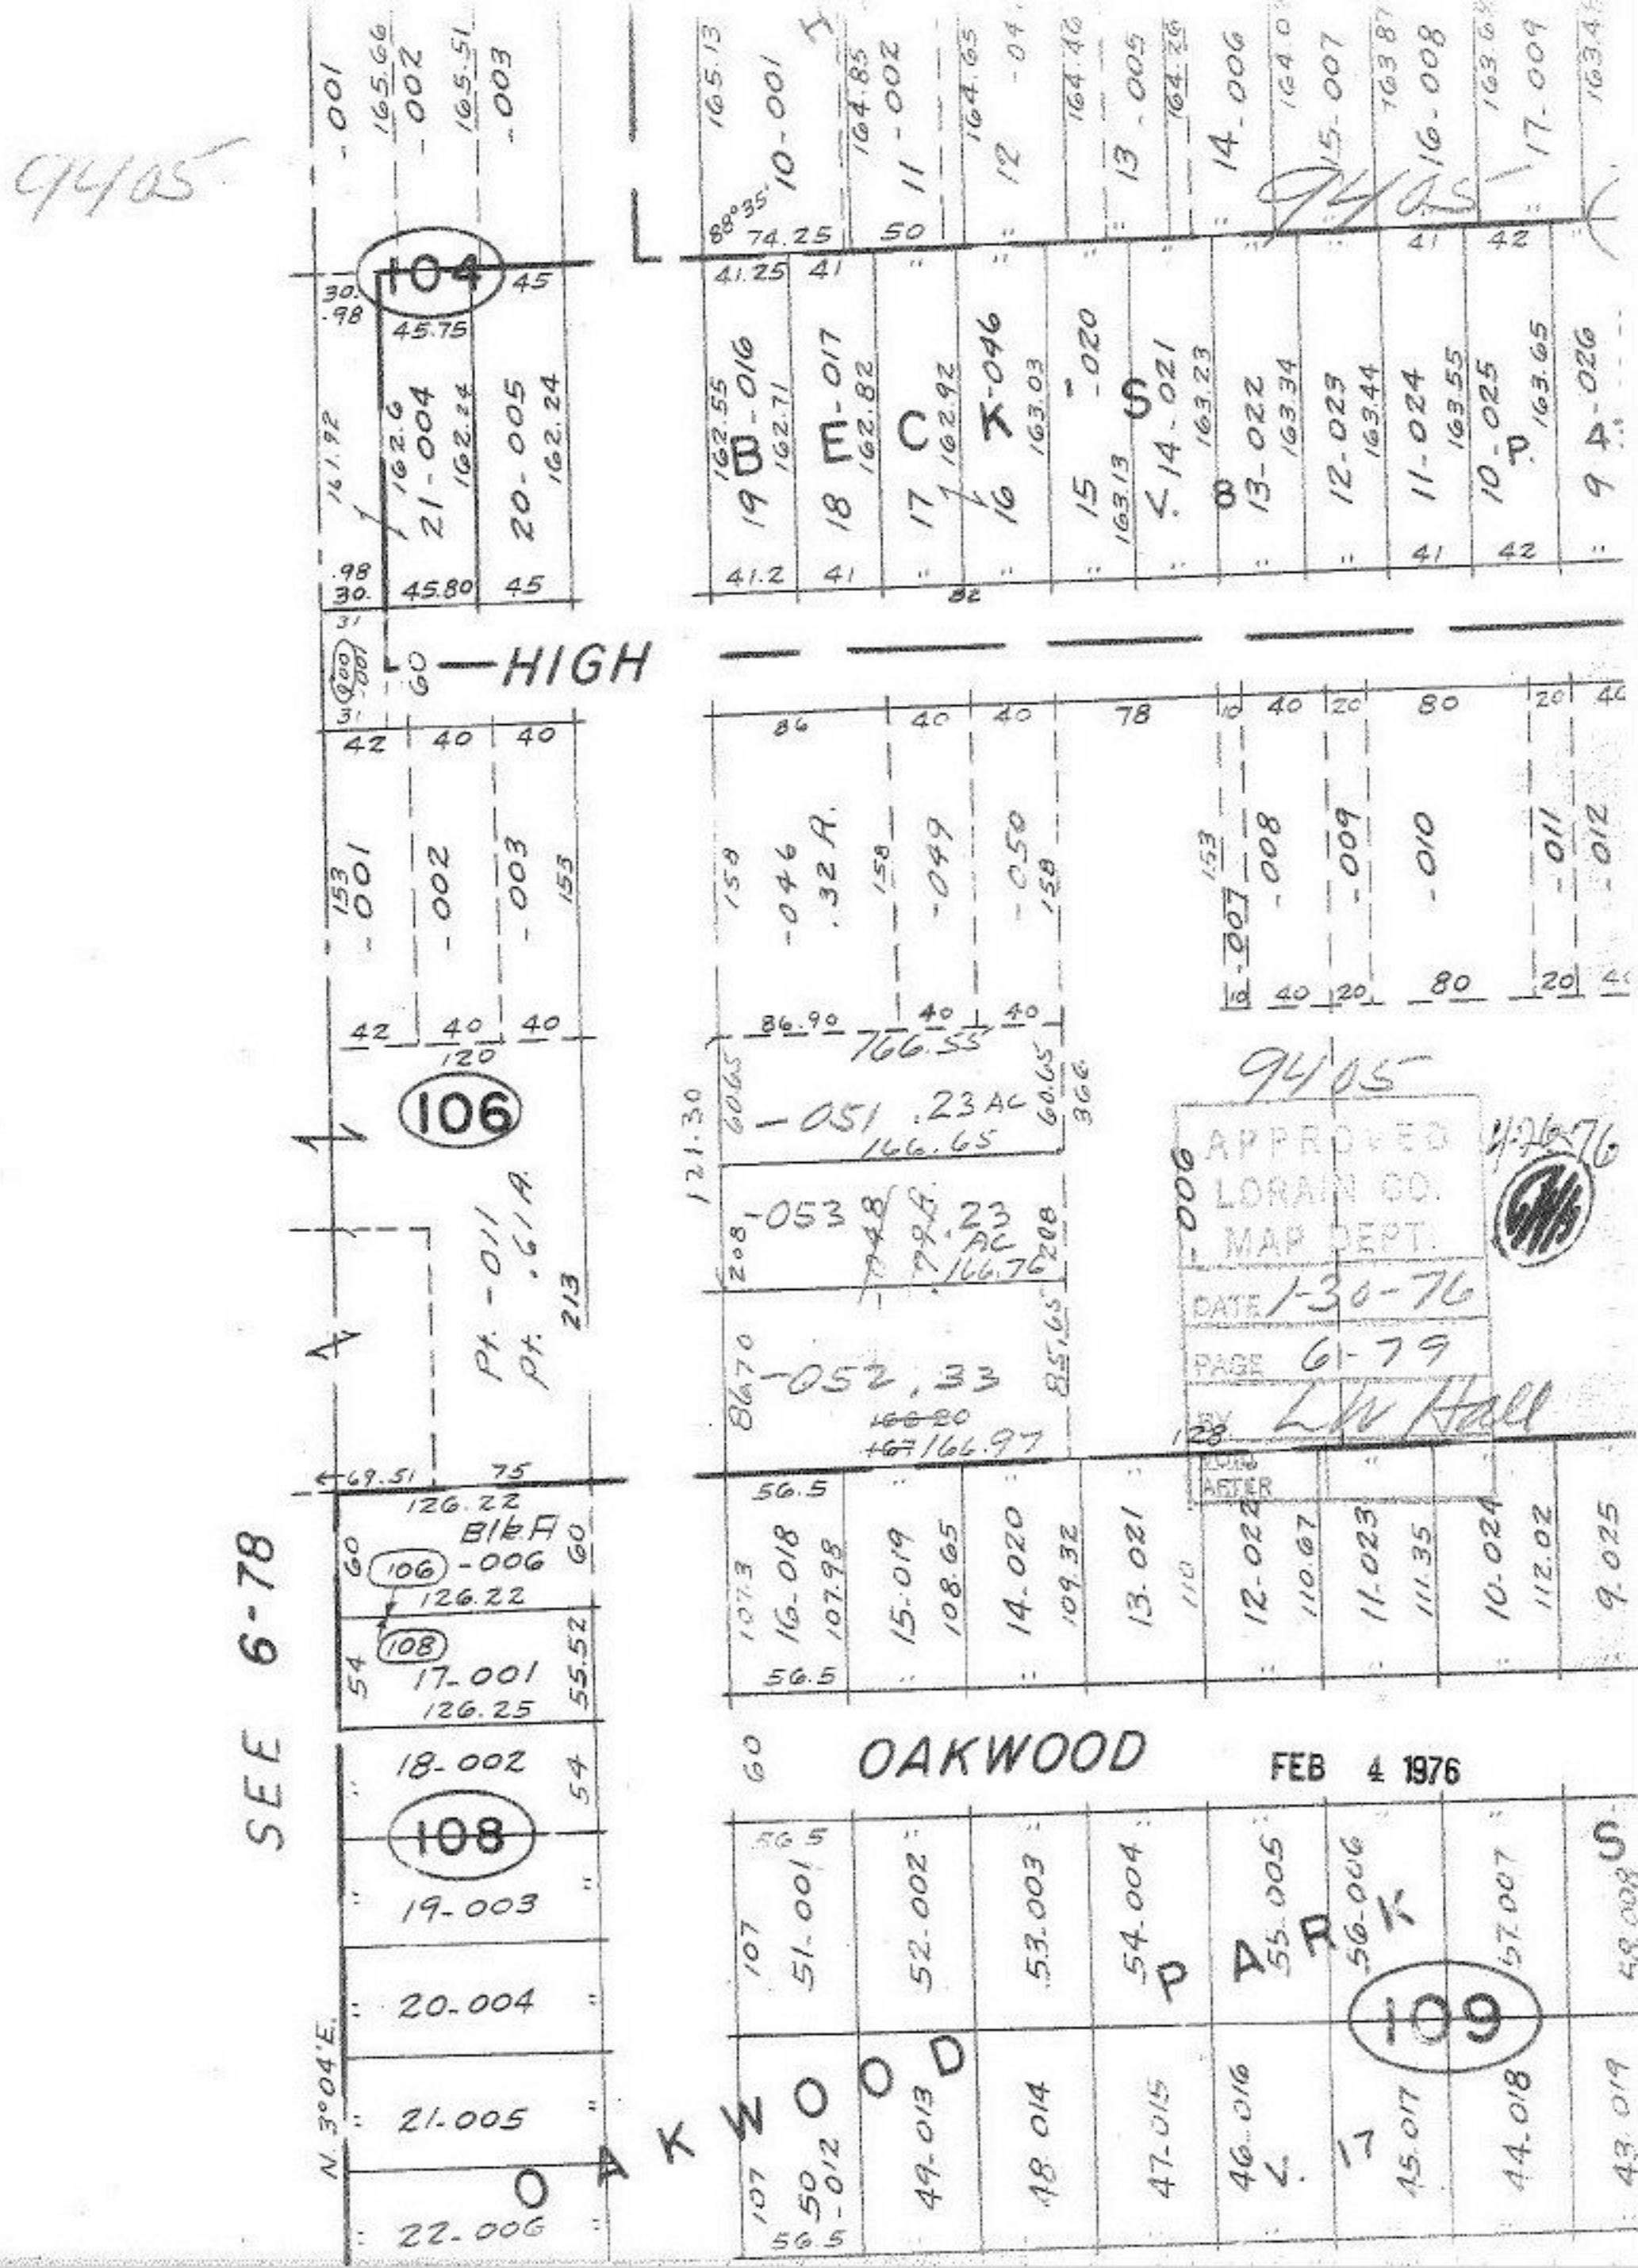
9405
104
106
108
109
HIGH
OAKWOOD
PARK
SEE 6-78
N. 3°04'E.
APPROVED
LORAIN CO.
MAP DEPT.
DATE 1-30-76
PAGE 6-79
BY Lh Hall
FEB 4 1976