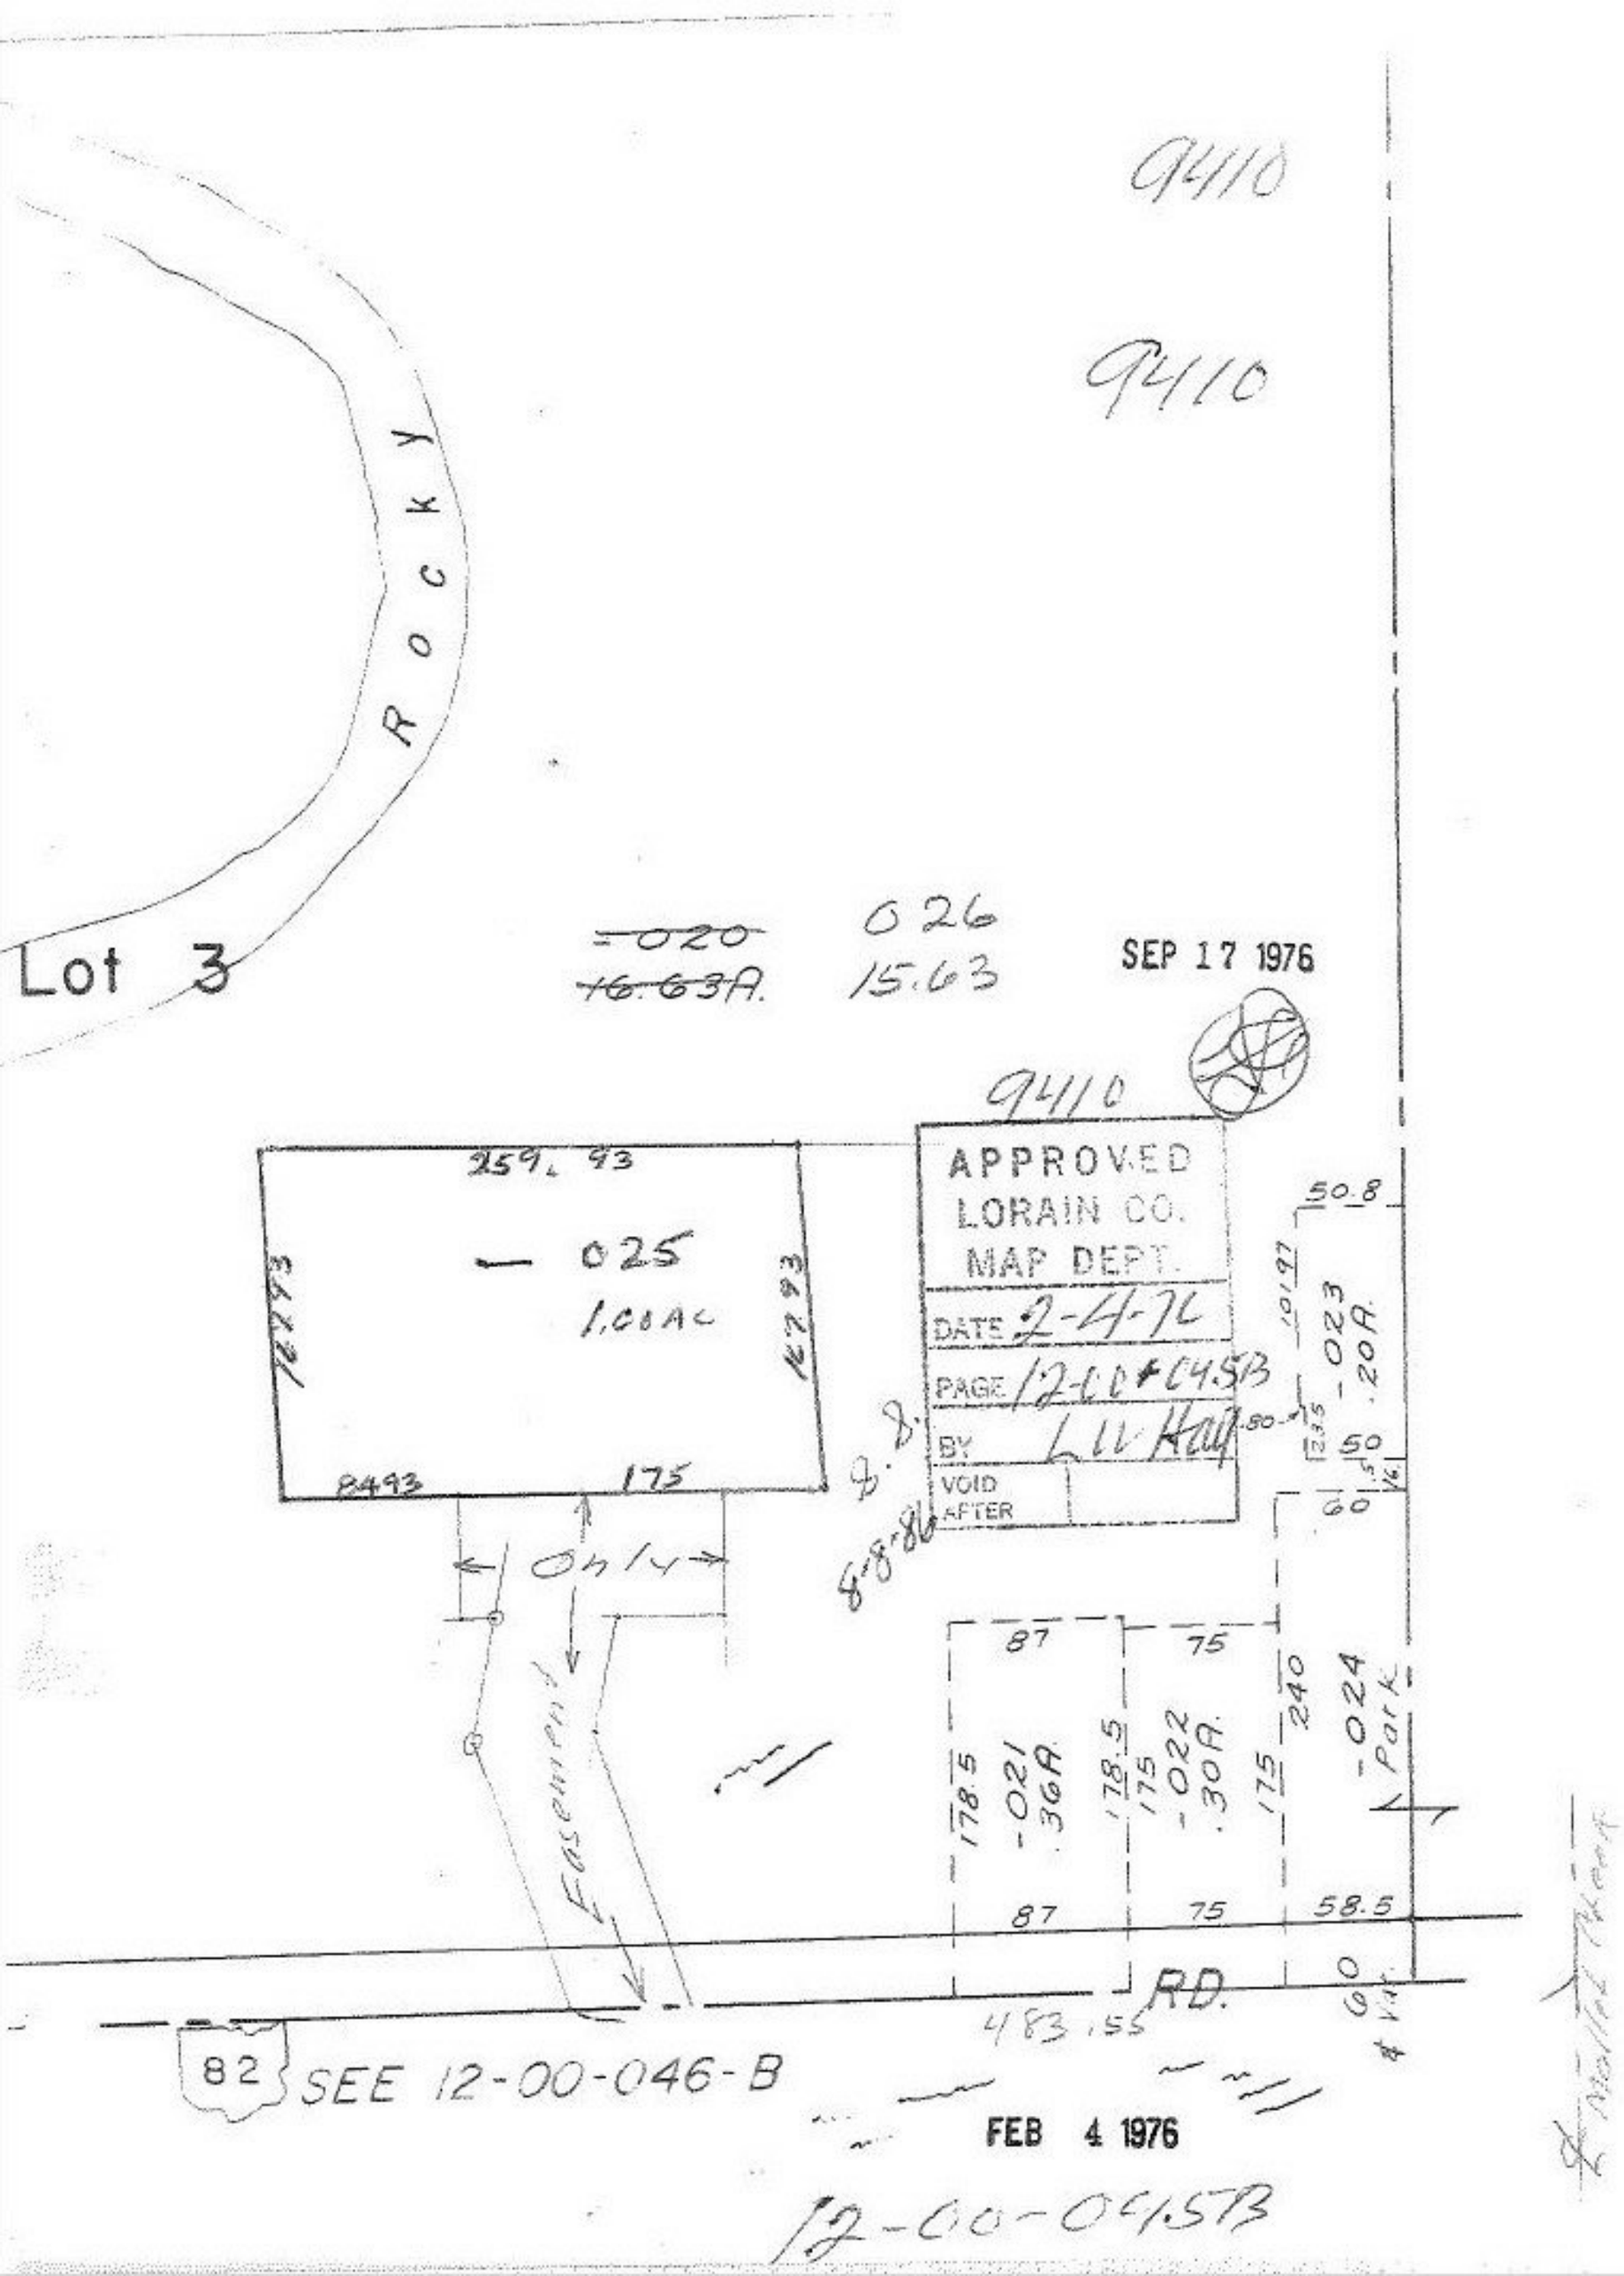
9410
9410
Rocky
Lot 3
~~020~~ 026
~~16.63A.~~ 15.63
SEP 17 1976
9410
APPROVED
LORAIN CO.
MAP DEPT.
DATE 2-4-76
PAGE 12-00-045B
BY L.W. Hay
VOID AFTER
259.93
025
1.00AC
127.93
127.93
84.93
175
Only
Easement
8.8.
8-8-86
50.8
101.97
-023
.20A.
50
60
87
75
178.5
-021
.36A.
178.5
175
-022
.30A.
175
240
-024
Park
87
75
58.5
RD.
483.55
60
82
SEE 12-00-046-B
FEB 4 1976
12-00-045B