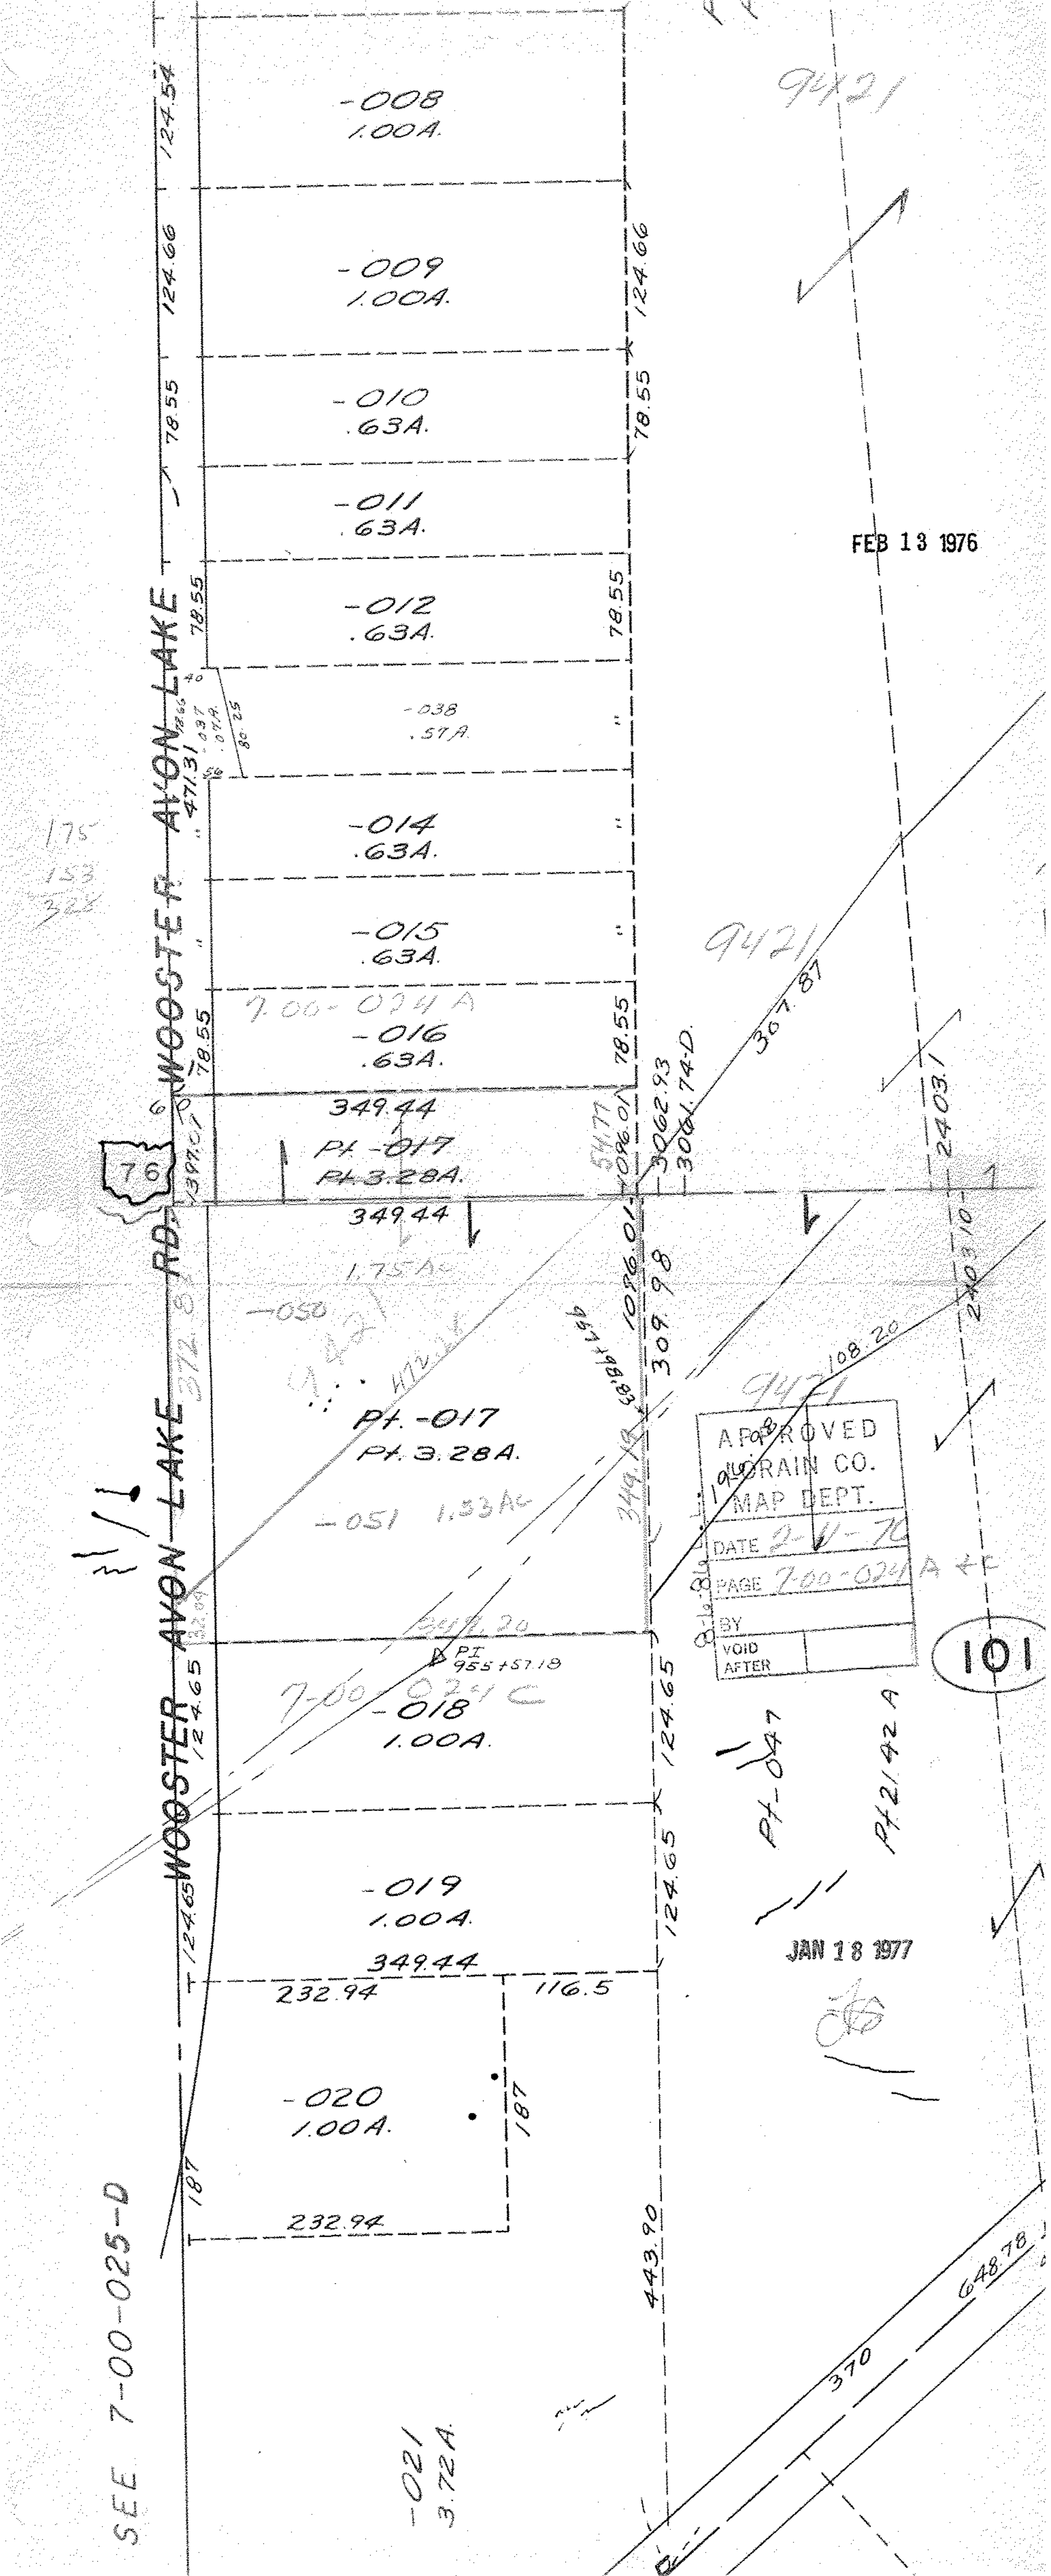

APPROVED
LORAIN CO.
MAP DEPT.
DATE 2-11-76
PAGE 7-00-024 A & C
BY
VOID
AFTER