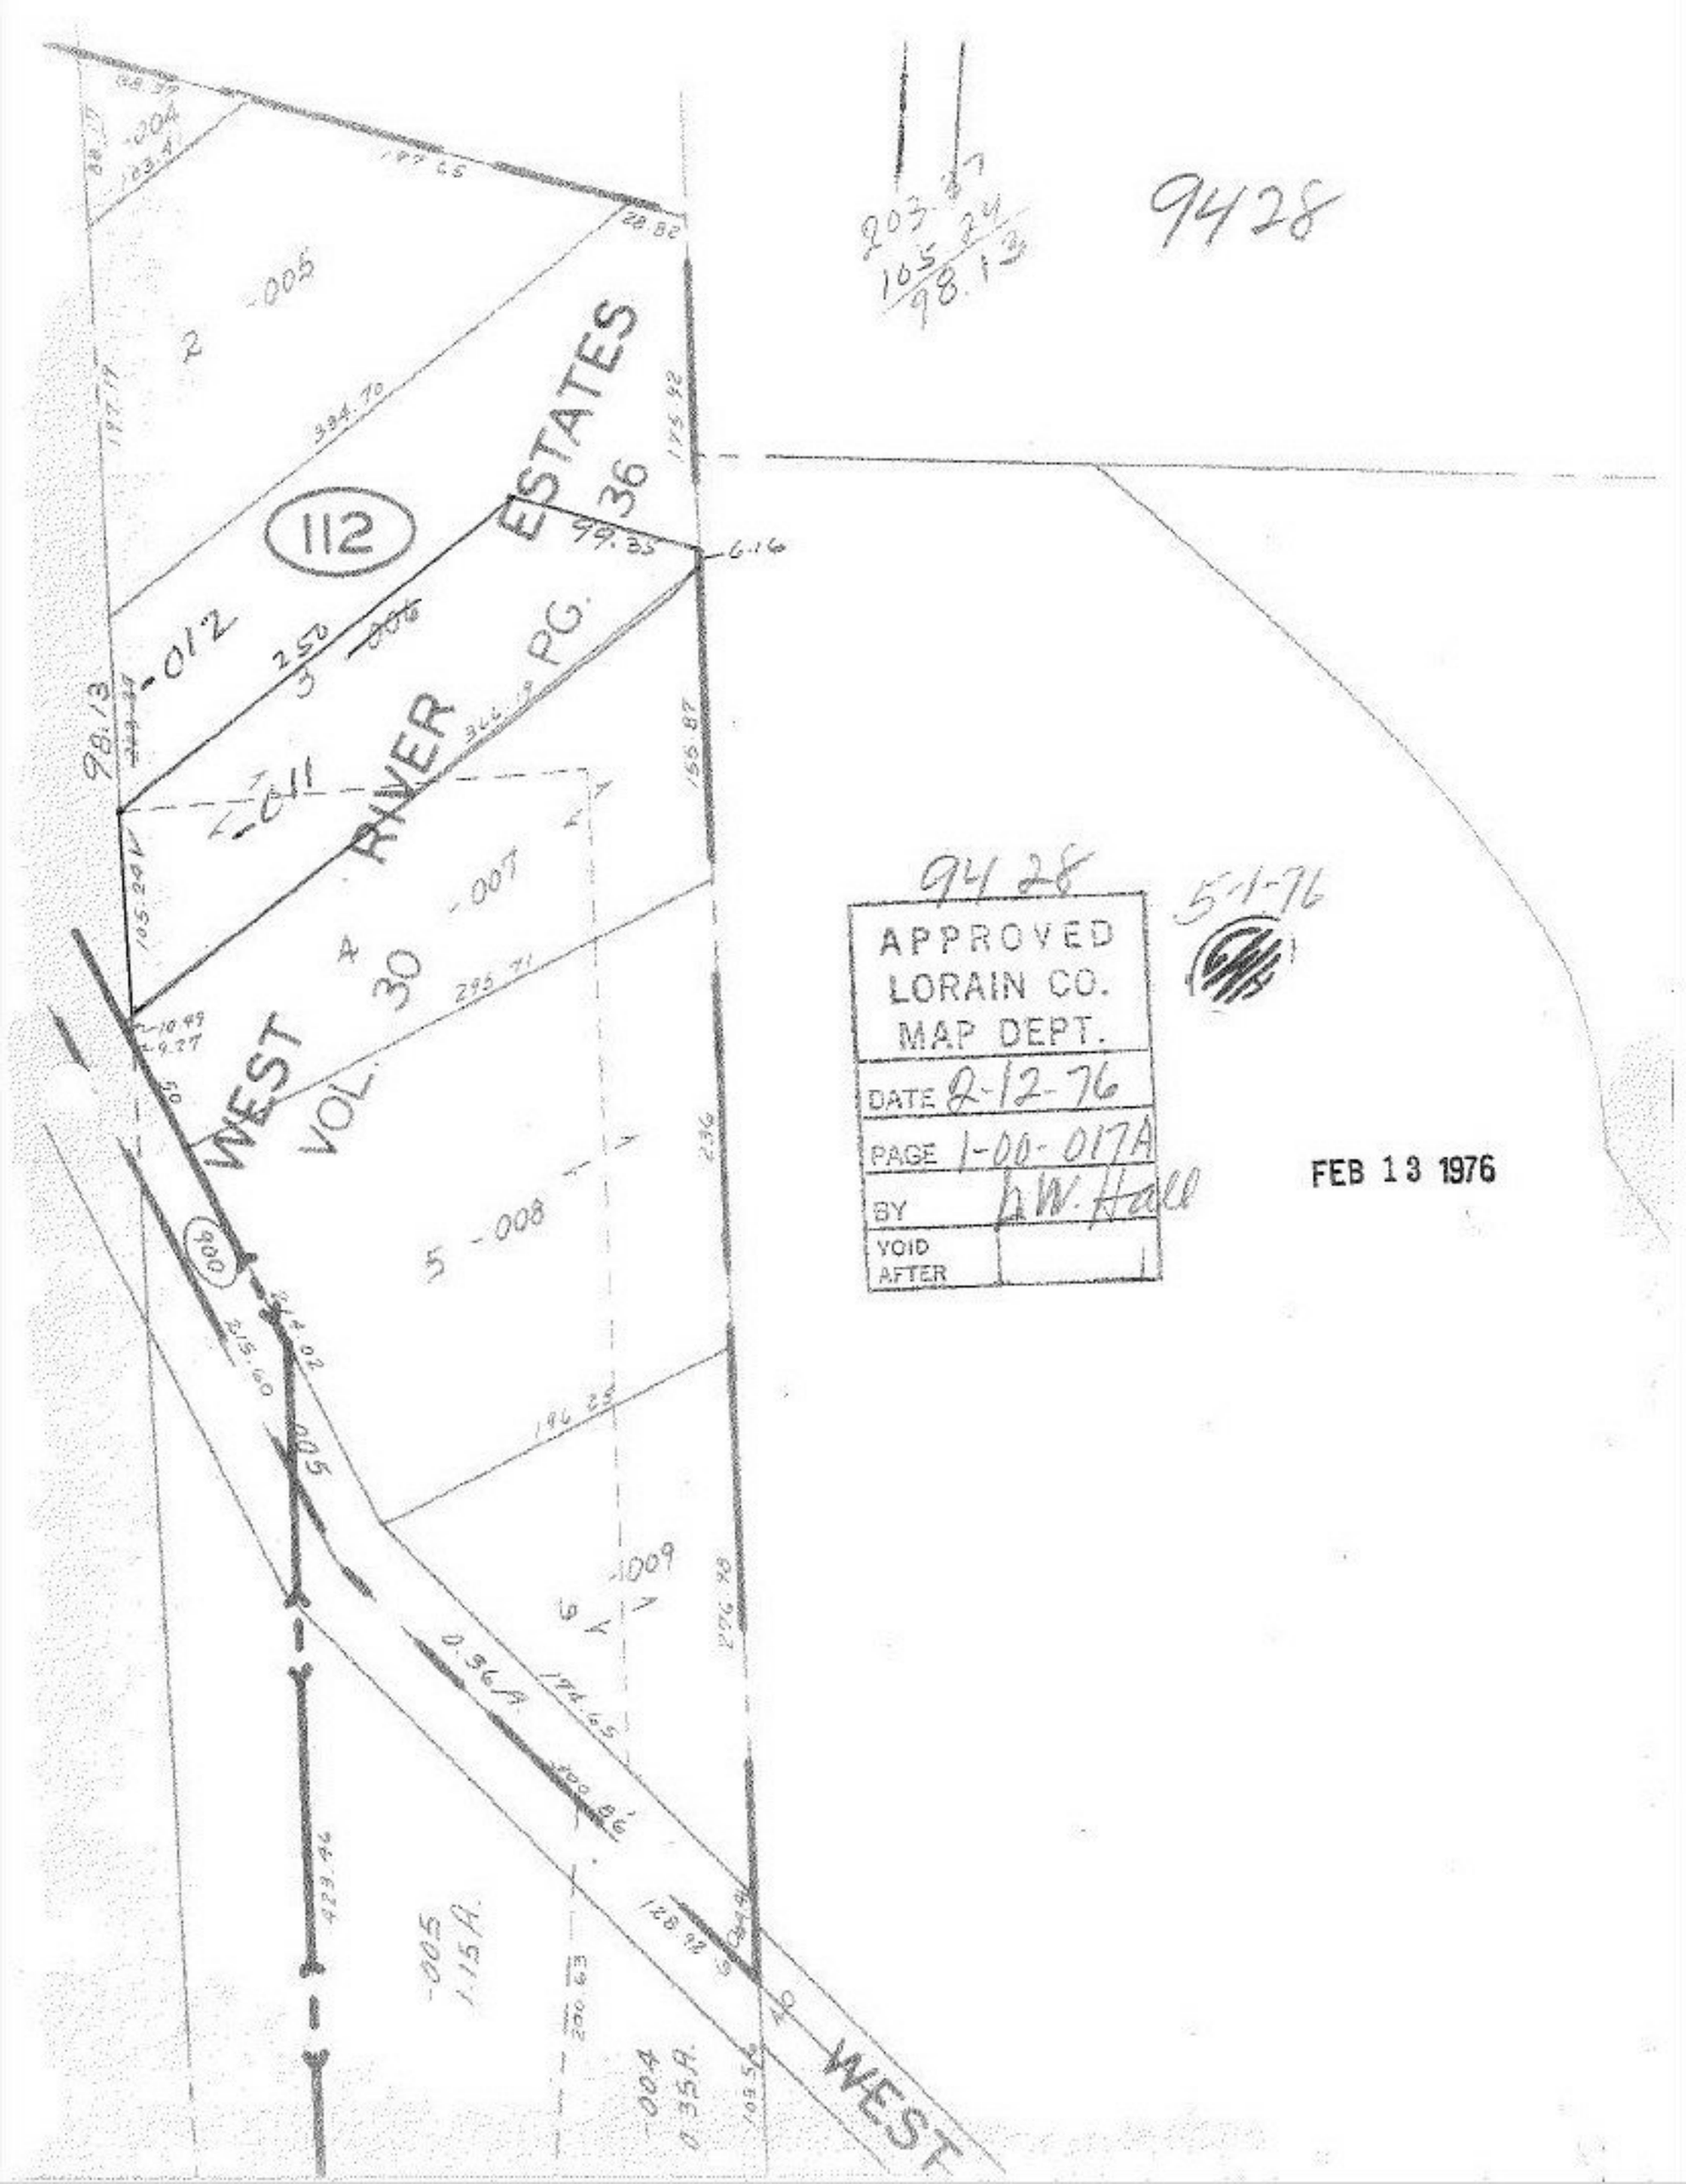

9428
203.37
105.24
98.13
112
ESTATES
36
RIVER
PG.
WEST
VOL. 30
-012
-011
-007
-008
-009
-005
1.15 A.
-004
0.35 A.
0.36 A.
WEST
9428
5-1-76
APPROVED
LORAIN CO.
MAP DEPT.
DATE 2-12-76
PAGE 1-00-017A
BY D.W. Hall
VOID
AFTER
FEB 13 1976