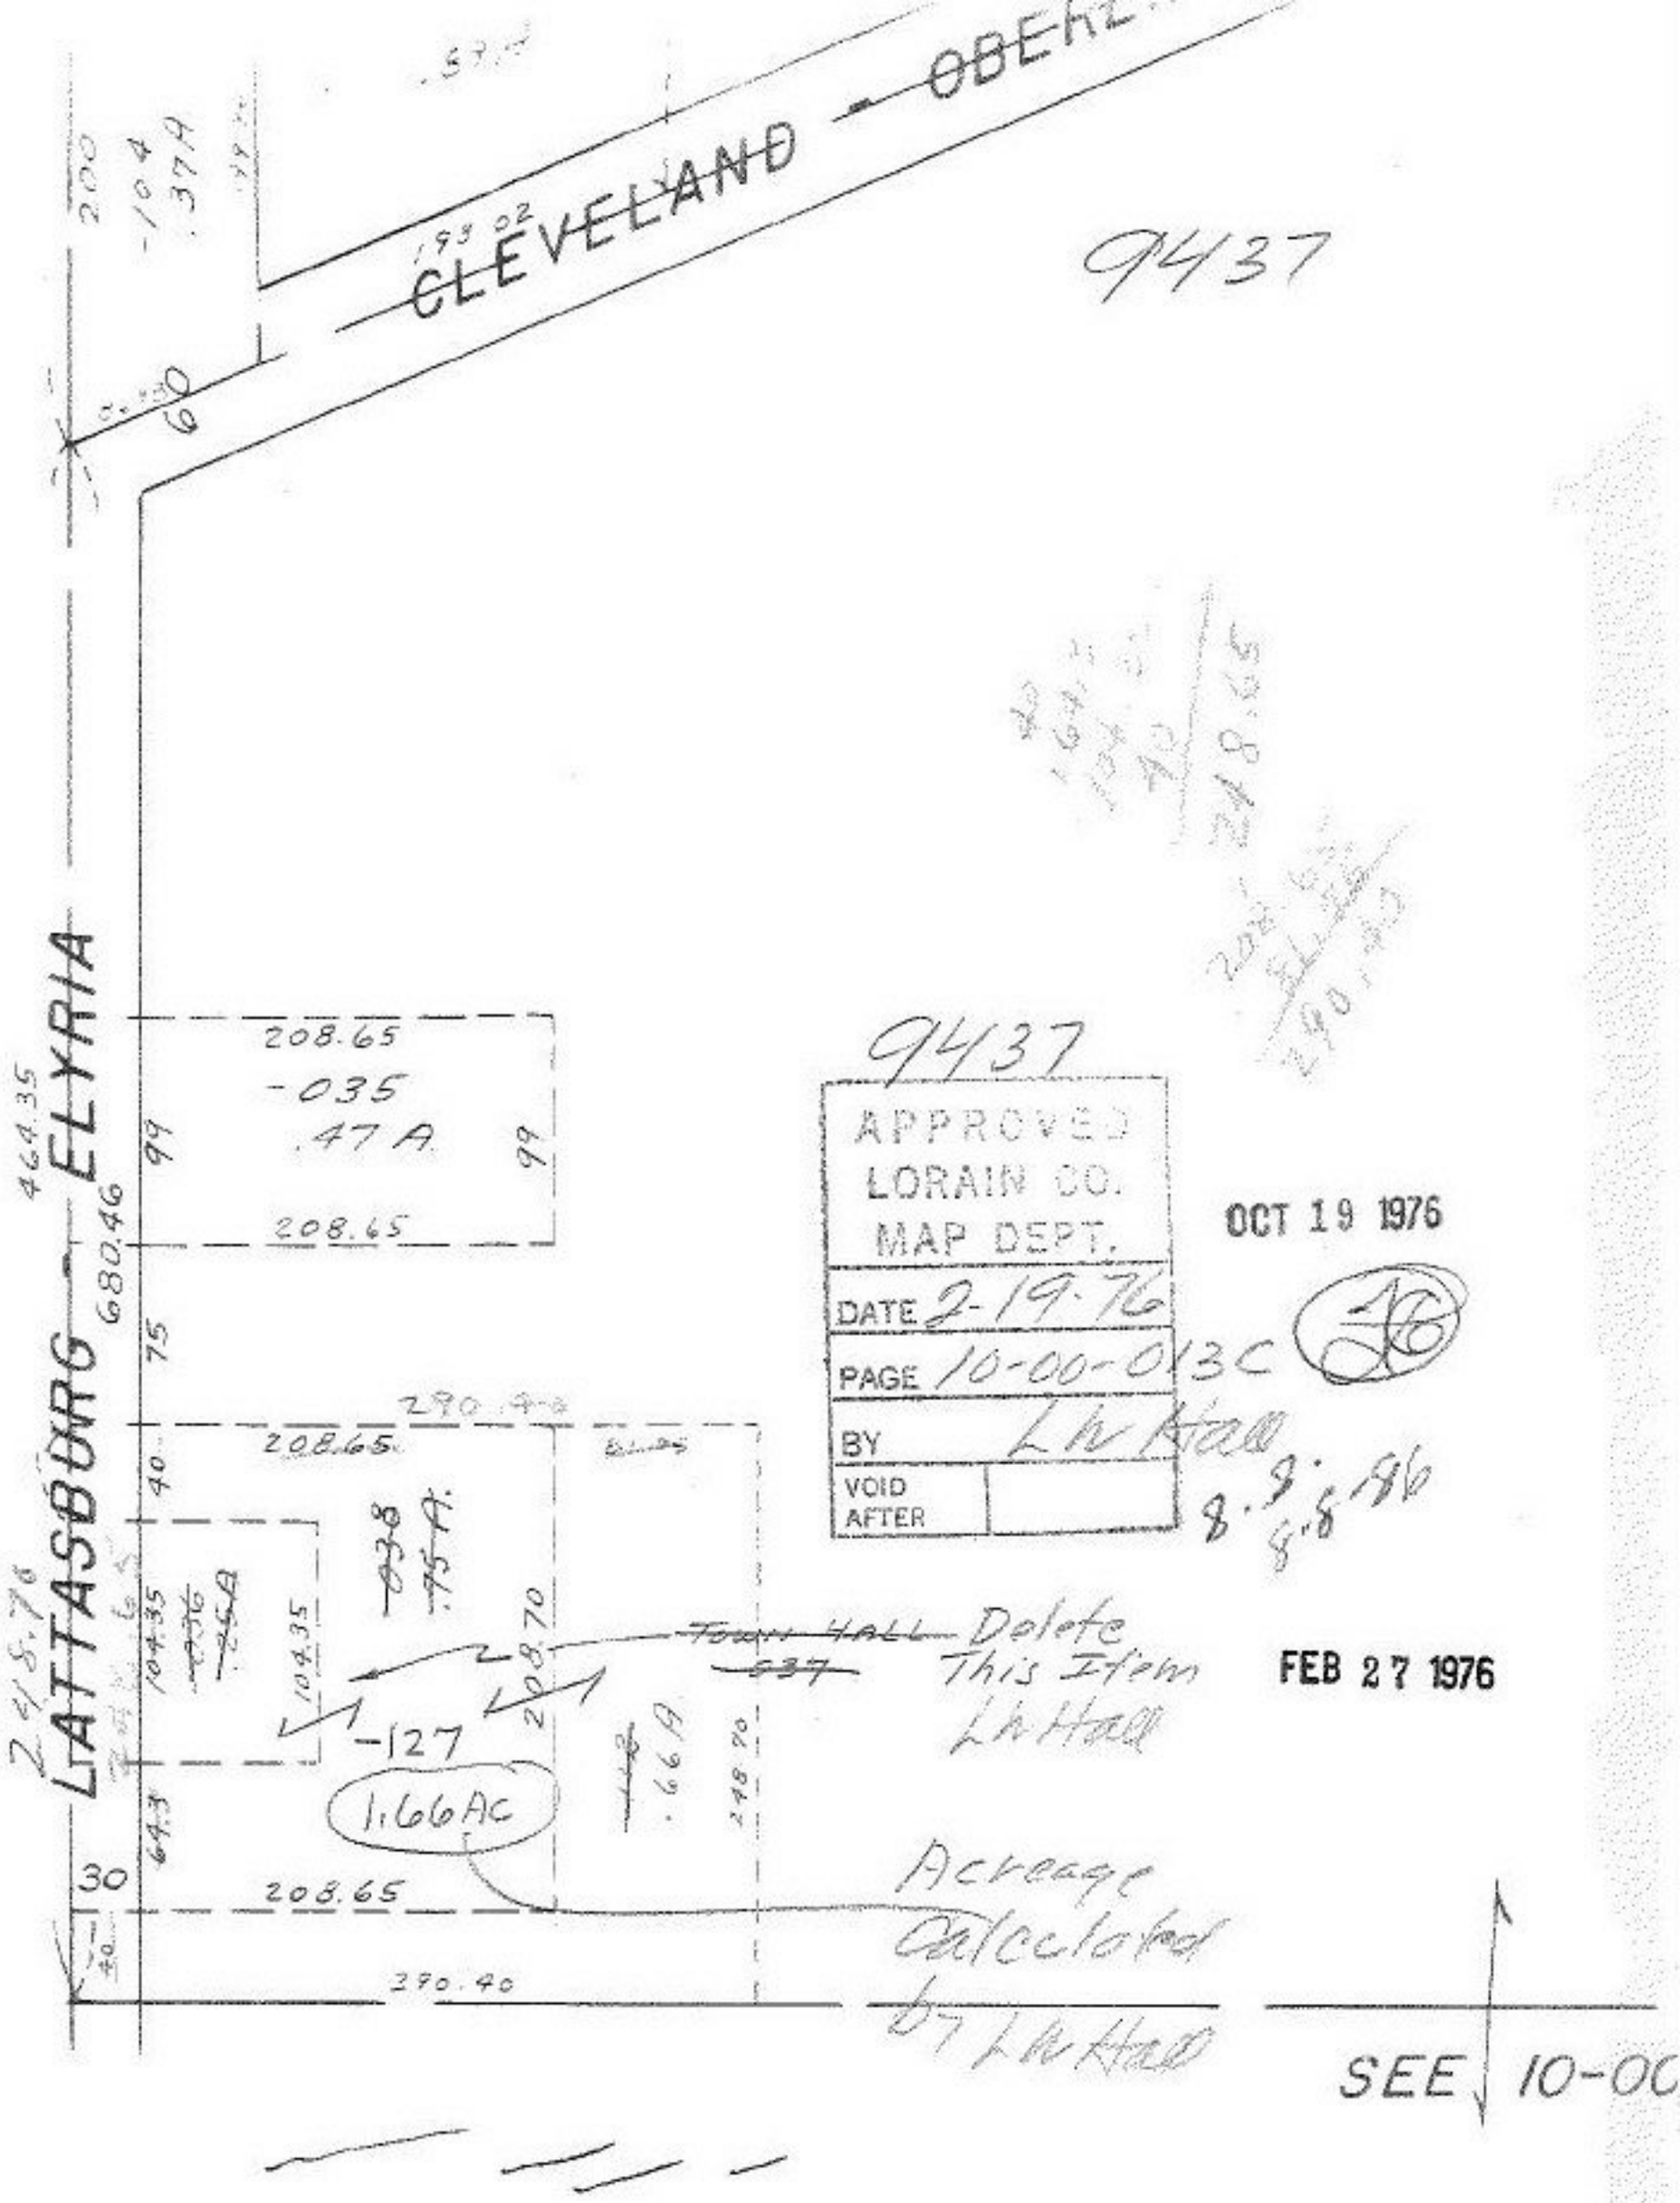

9437

APPROVED
LORAIN CO.
MAP DEPT.

DATE 2-19-76
PAGE 10-00-013C
BY Lh Hall
VOID AFTER

OCT 19 1976

FEB 27 1976

CARLISLE TWP.

SCALE: 1" = 100'