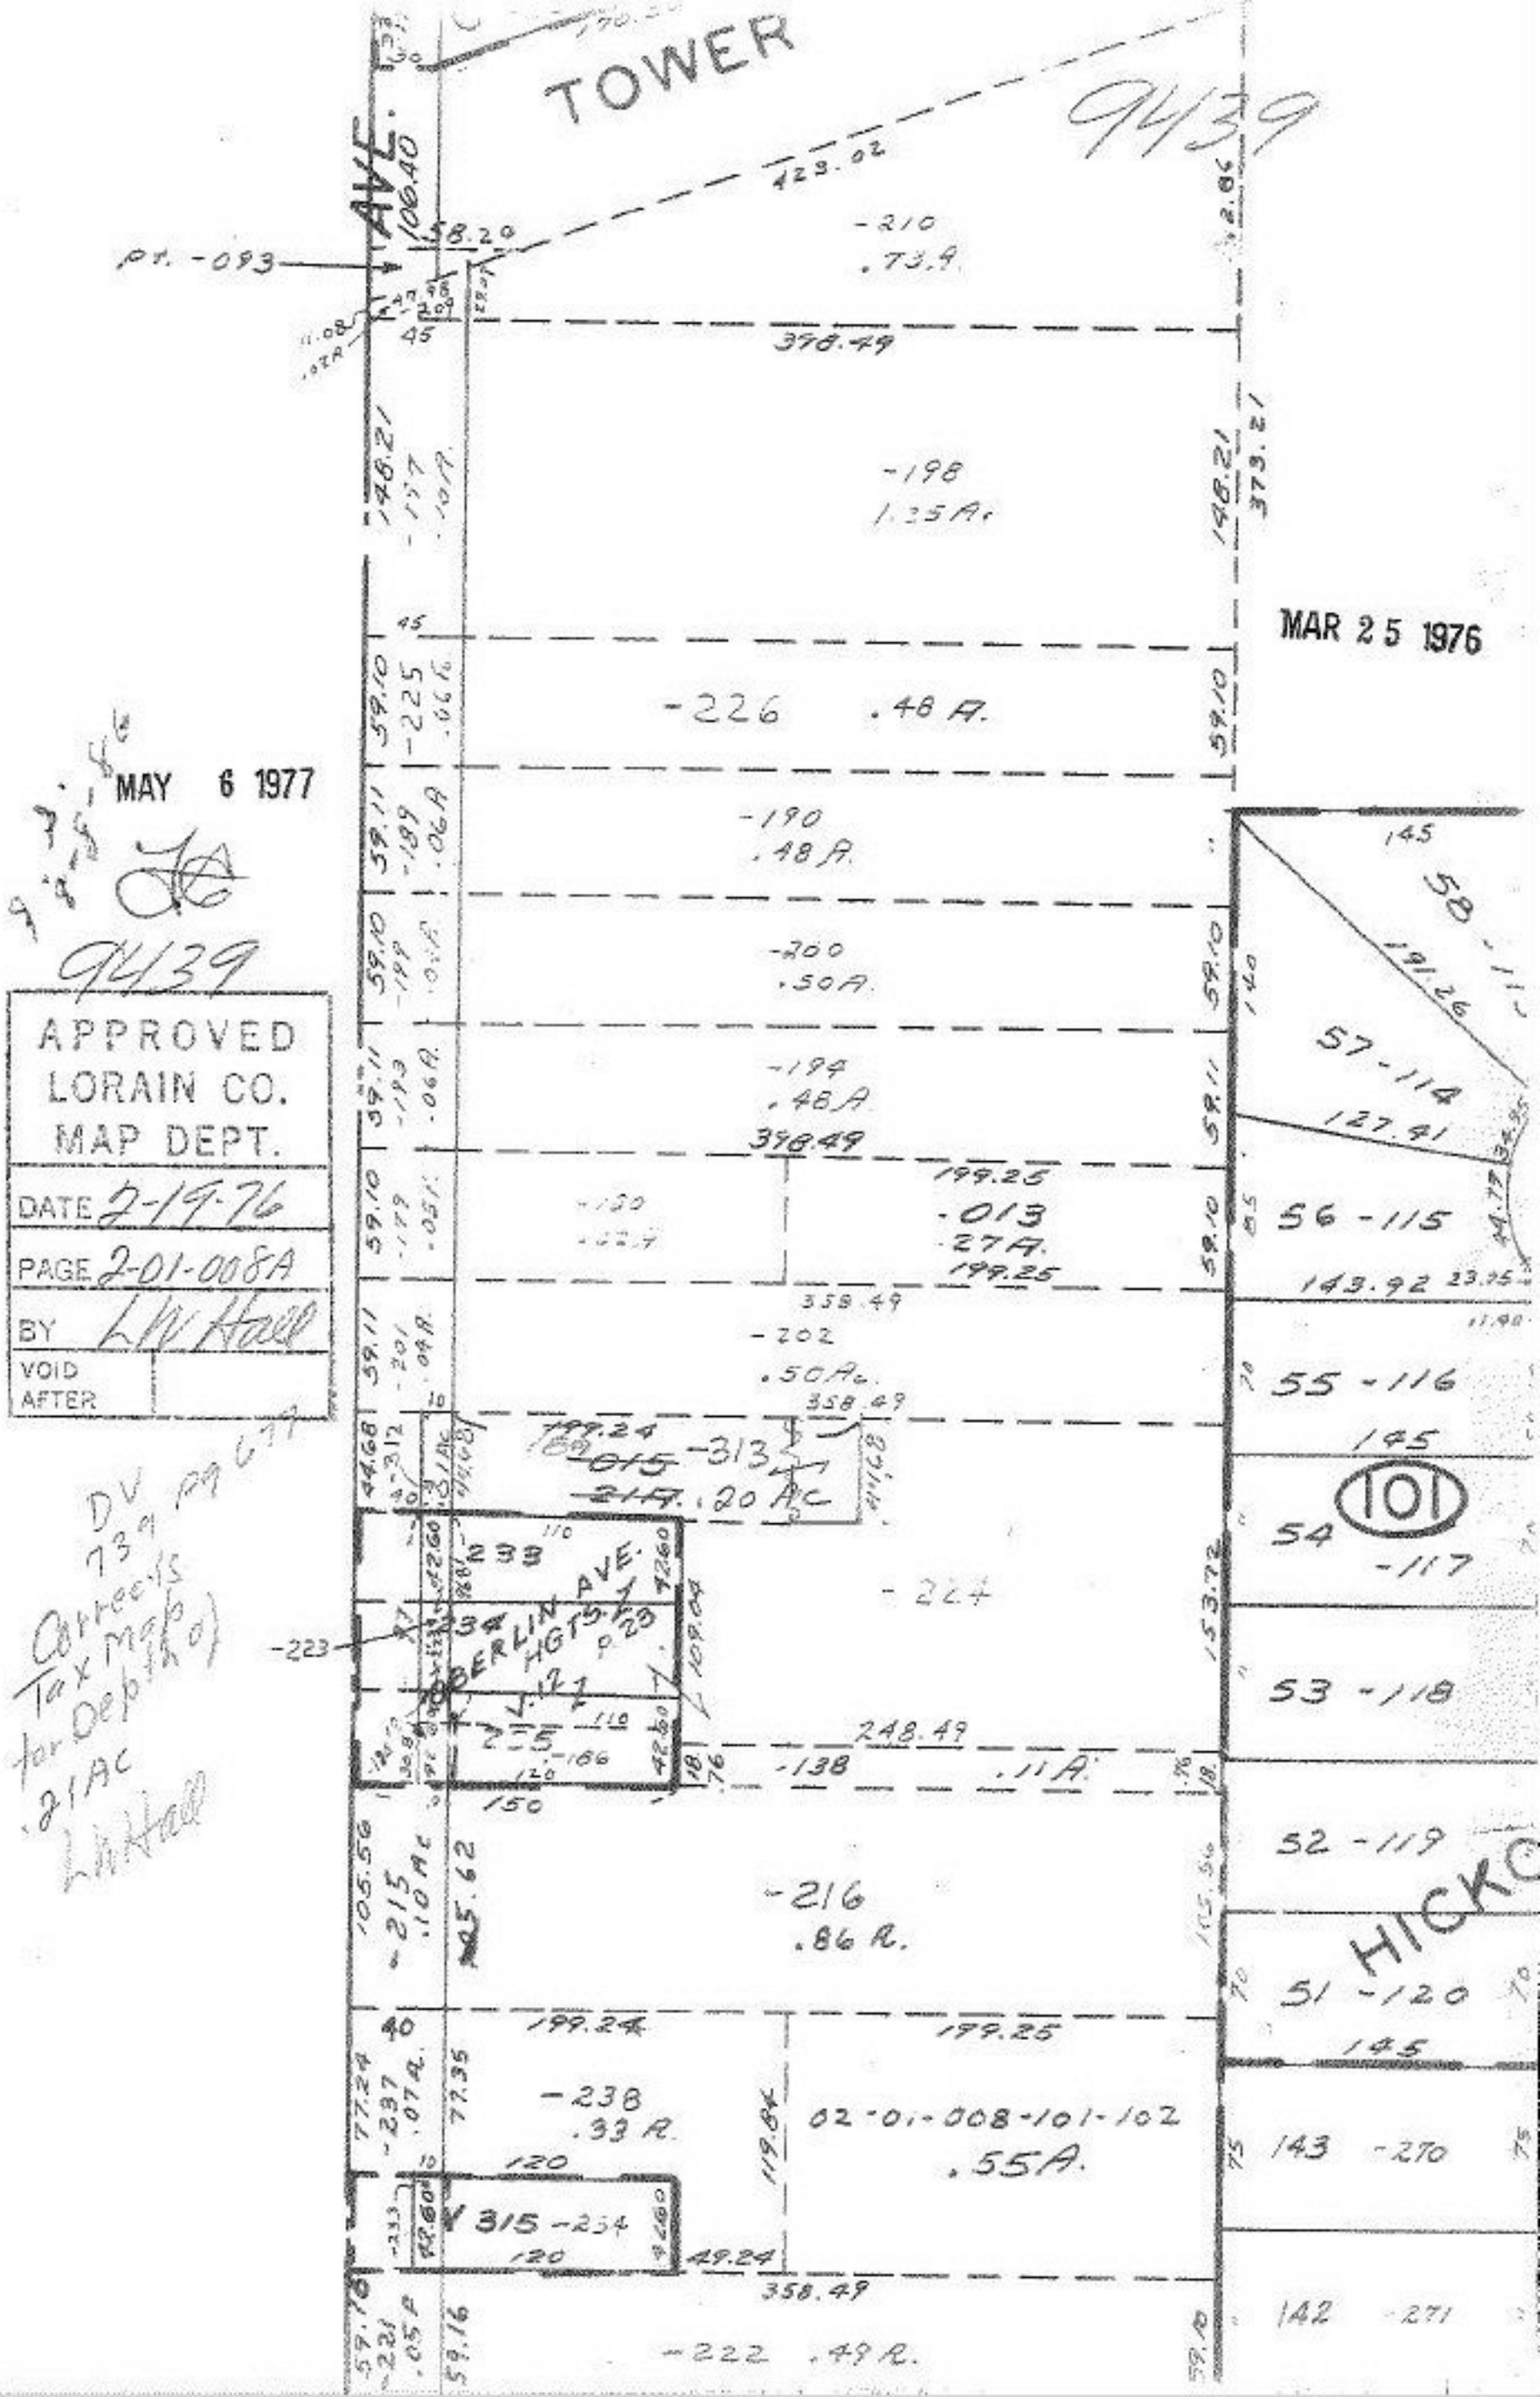

APPROVED
LORAIN CO.
MAP DEPT.

DATE 2-19-76

PAGE 2-01-008A

BY L.W. Hall

VOID AFTER

DV 739 pg 677
Corrects Tax Map for Depth of .21 AC
L.W. Hall