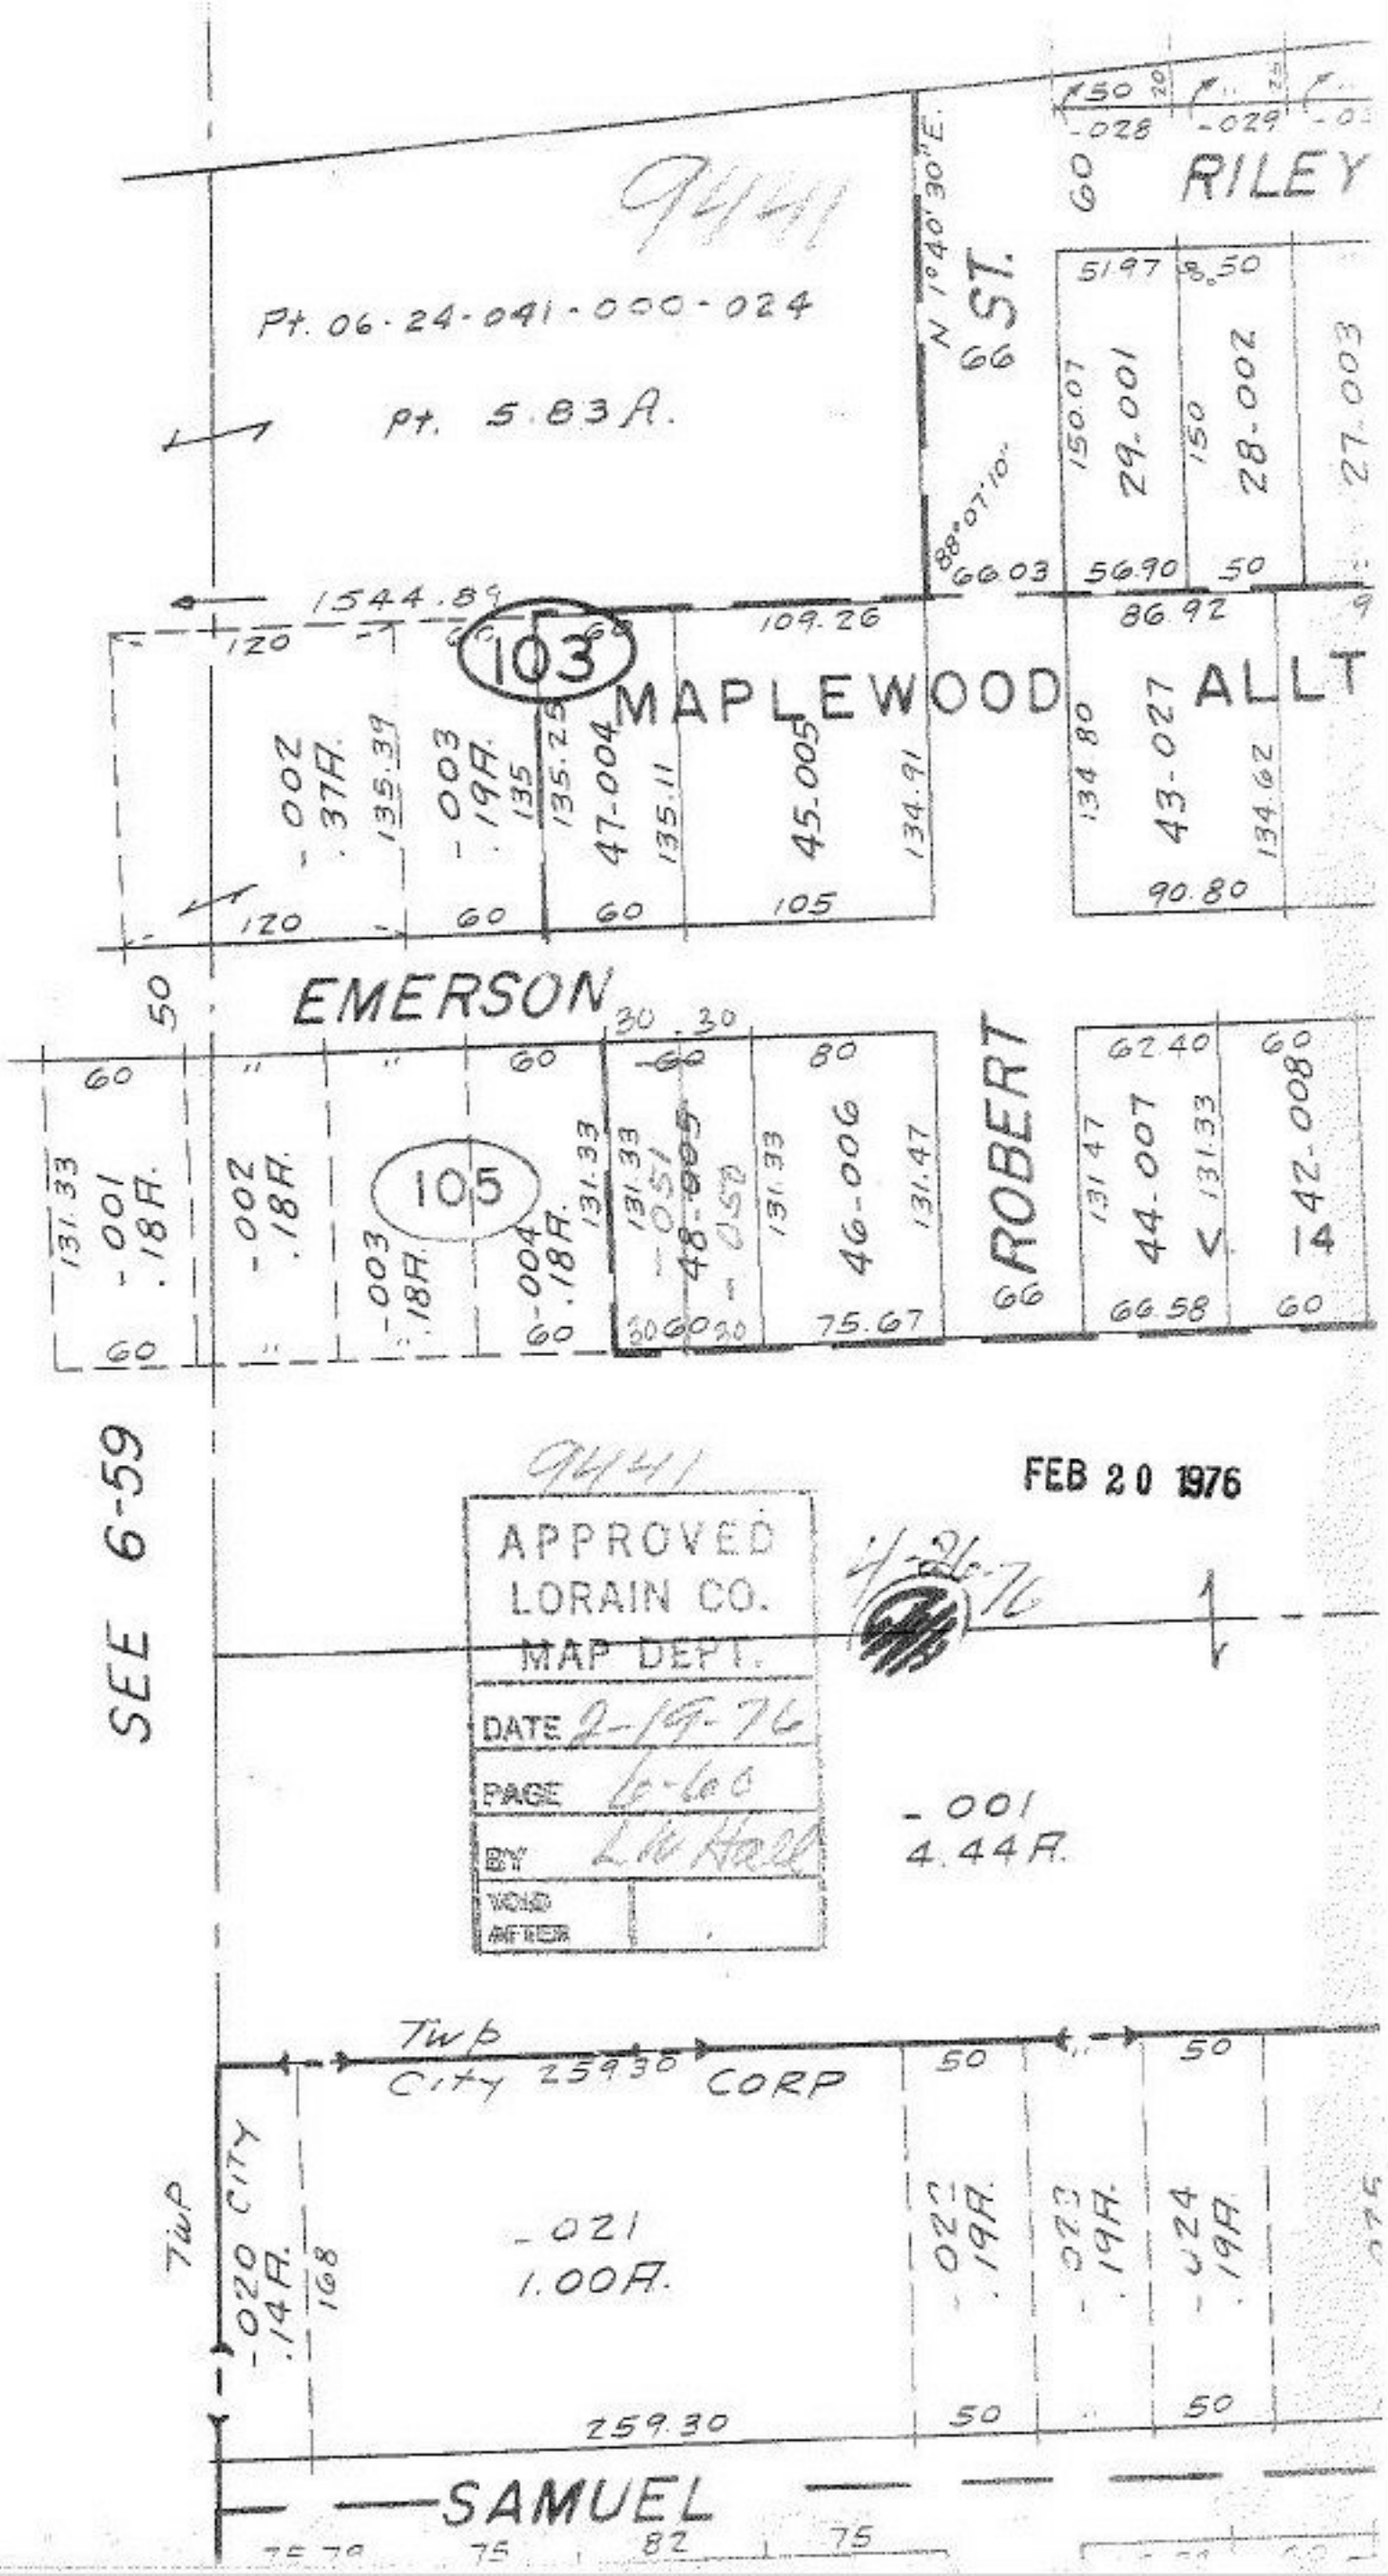
9441
Pt. 06-24-041-000-024
Pt. 5.83A.
N 1°40'30"E.
ST.
66
RILEY
-028
-029
51.97
8.50
150.07
29.001
150
28.002
27.003
88°07'10"
66.03
56.90
50
1544.89
120
109.26
86.92
103
MAPLEWOOD ALLT
-002
.37A.
135.39
-003
.19A.
135
135.25
47.004
135.11
45.005
134.91
134.80
43.027
134.62
120
60
60
105
90.80
EMERSON
50
30
30
60
80
62.40
60
131.33
-001
.18A.
-002
.18A.
105
-003
.18A.
-004
.18A.
131.33
131.33
-051
48.005
-050
131.33
46.006
131.47
ROBERT
66
131.47
44.007
131.33
42.008
14
66.58
60
60
60
60
30
60
30
75.67
SEE 6-59
9441
FEB 20 1976
APPROVED
LORAIN CO.
MAP DEPT.
DATE 2-19-76
PAGE 6-60
BY L.W. Hall
VOID AFTER
4-26-76
-001
4.44A.
Twp
City 259.30 CORP
50
50
TWP
-020 CITY
.14A.
168
-021
1.00A.
-022
.19A.
-023
.19A.
-024
.19A.
259.30
50
50
SAMUEL
75
82
75