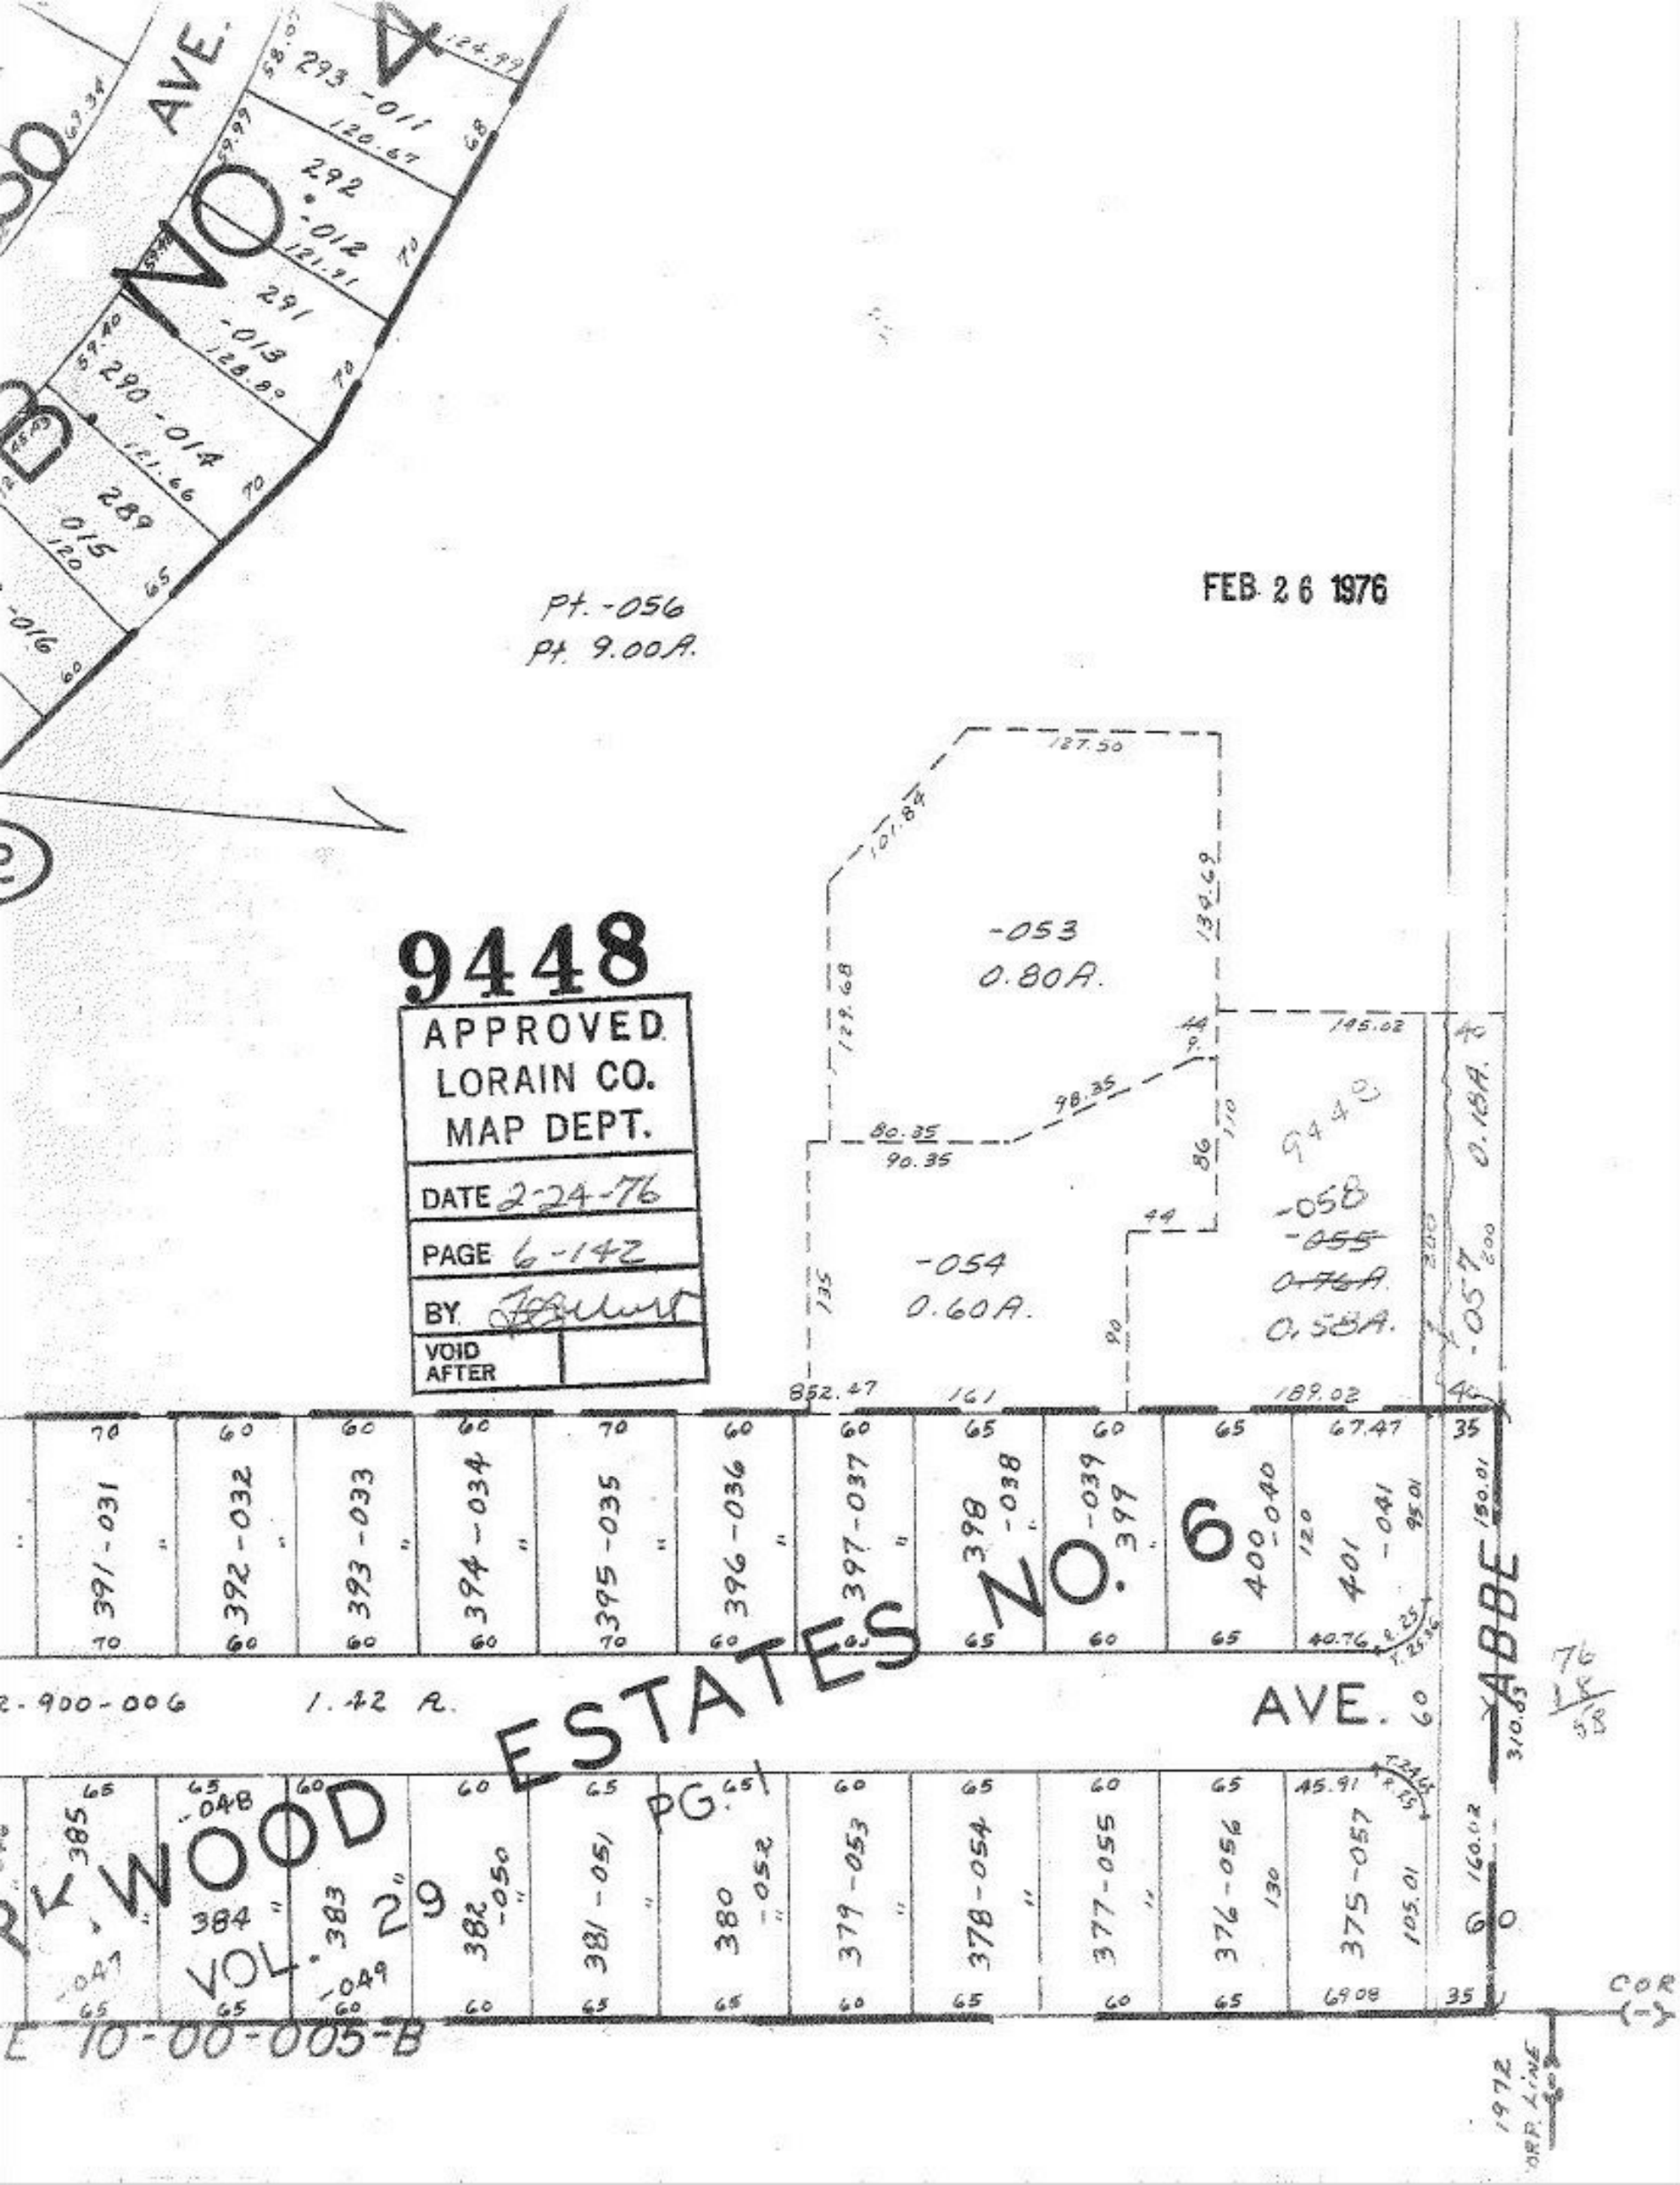

9448

APPROVED
LORAIN CO.
MAP DEPT.

DATE 2-24-76

PAGE 6-142

BY [signature]

VOID AFTER