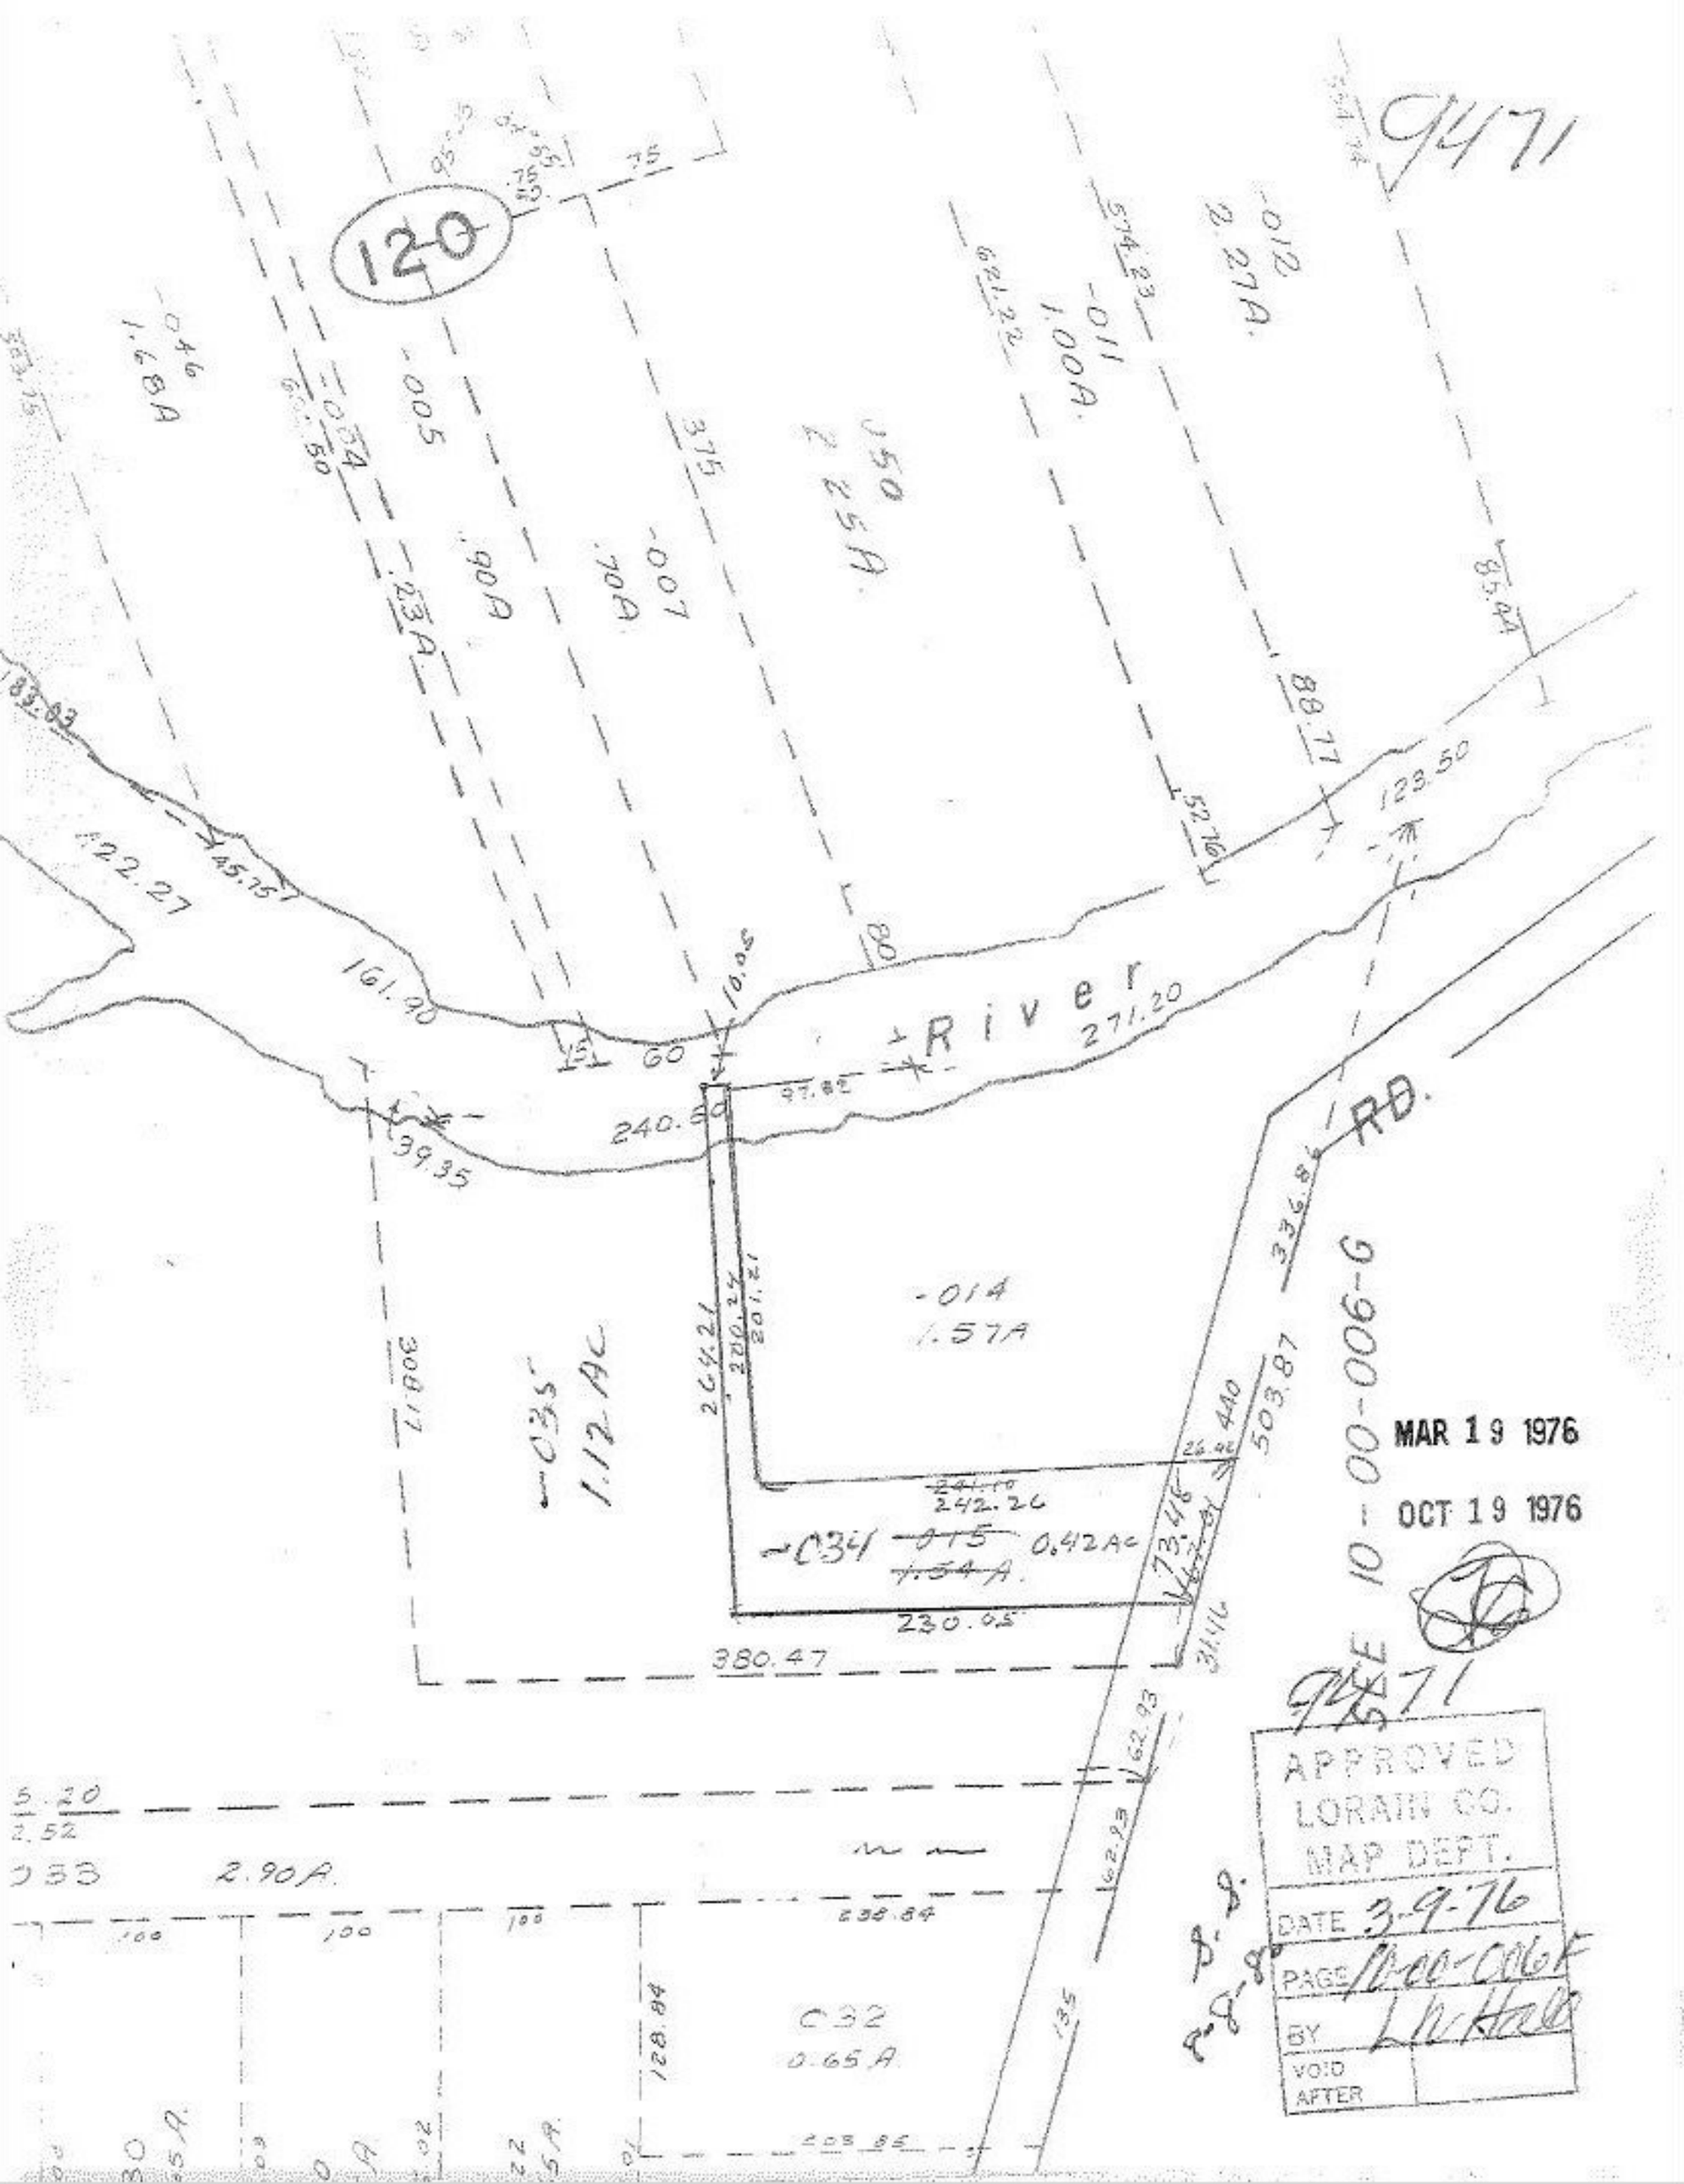
9471
120
-046
1.68A
-005
.90A
-007
.70A
375
-050
2.25A
-011
1.00A
-012
2.27A
574.23
621.22
88.77
85.44
52.76
123.50
183.03
122.27
145.75
161.90
10.05
80
River
271.20
60
240.50
97.82
39.35
RD.
336.86
-014
1.57A
264.21
200.24
201.21
308.17
-035
1.12 AC
503.87
440
26.42
242.26
-034
0.42AC
73.46
230.05
380.47
31.46
62.93
5.20
2.52
2.90A
238.84
100
128.84
C32
0.65A
135
203.85
SEE 10-00-006-G
MAR 19 1976
OCT 19 1976
APPROVED
LORAIN CO.
MAP DEPT.
DATE 3-9-76
PAGE 10-00-006F
BY
VOID
AFTER