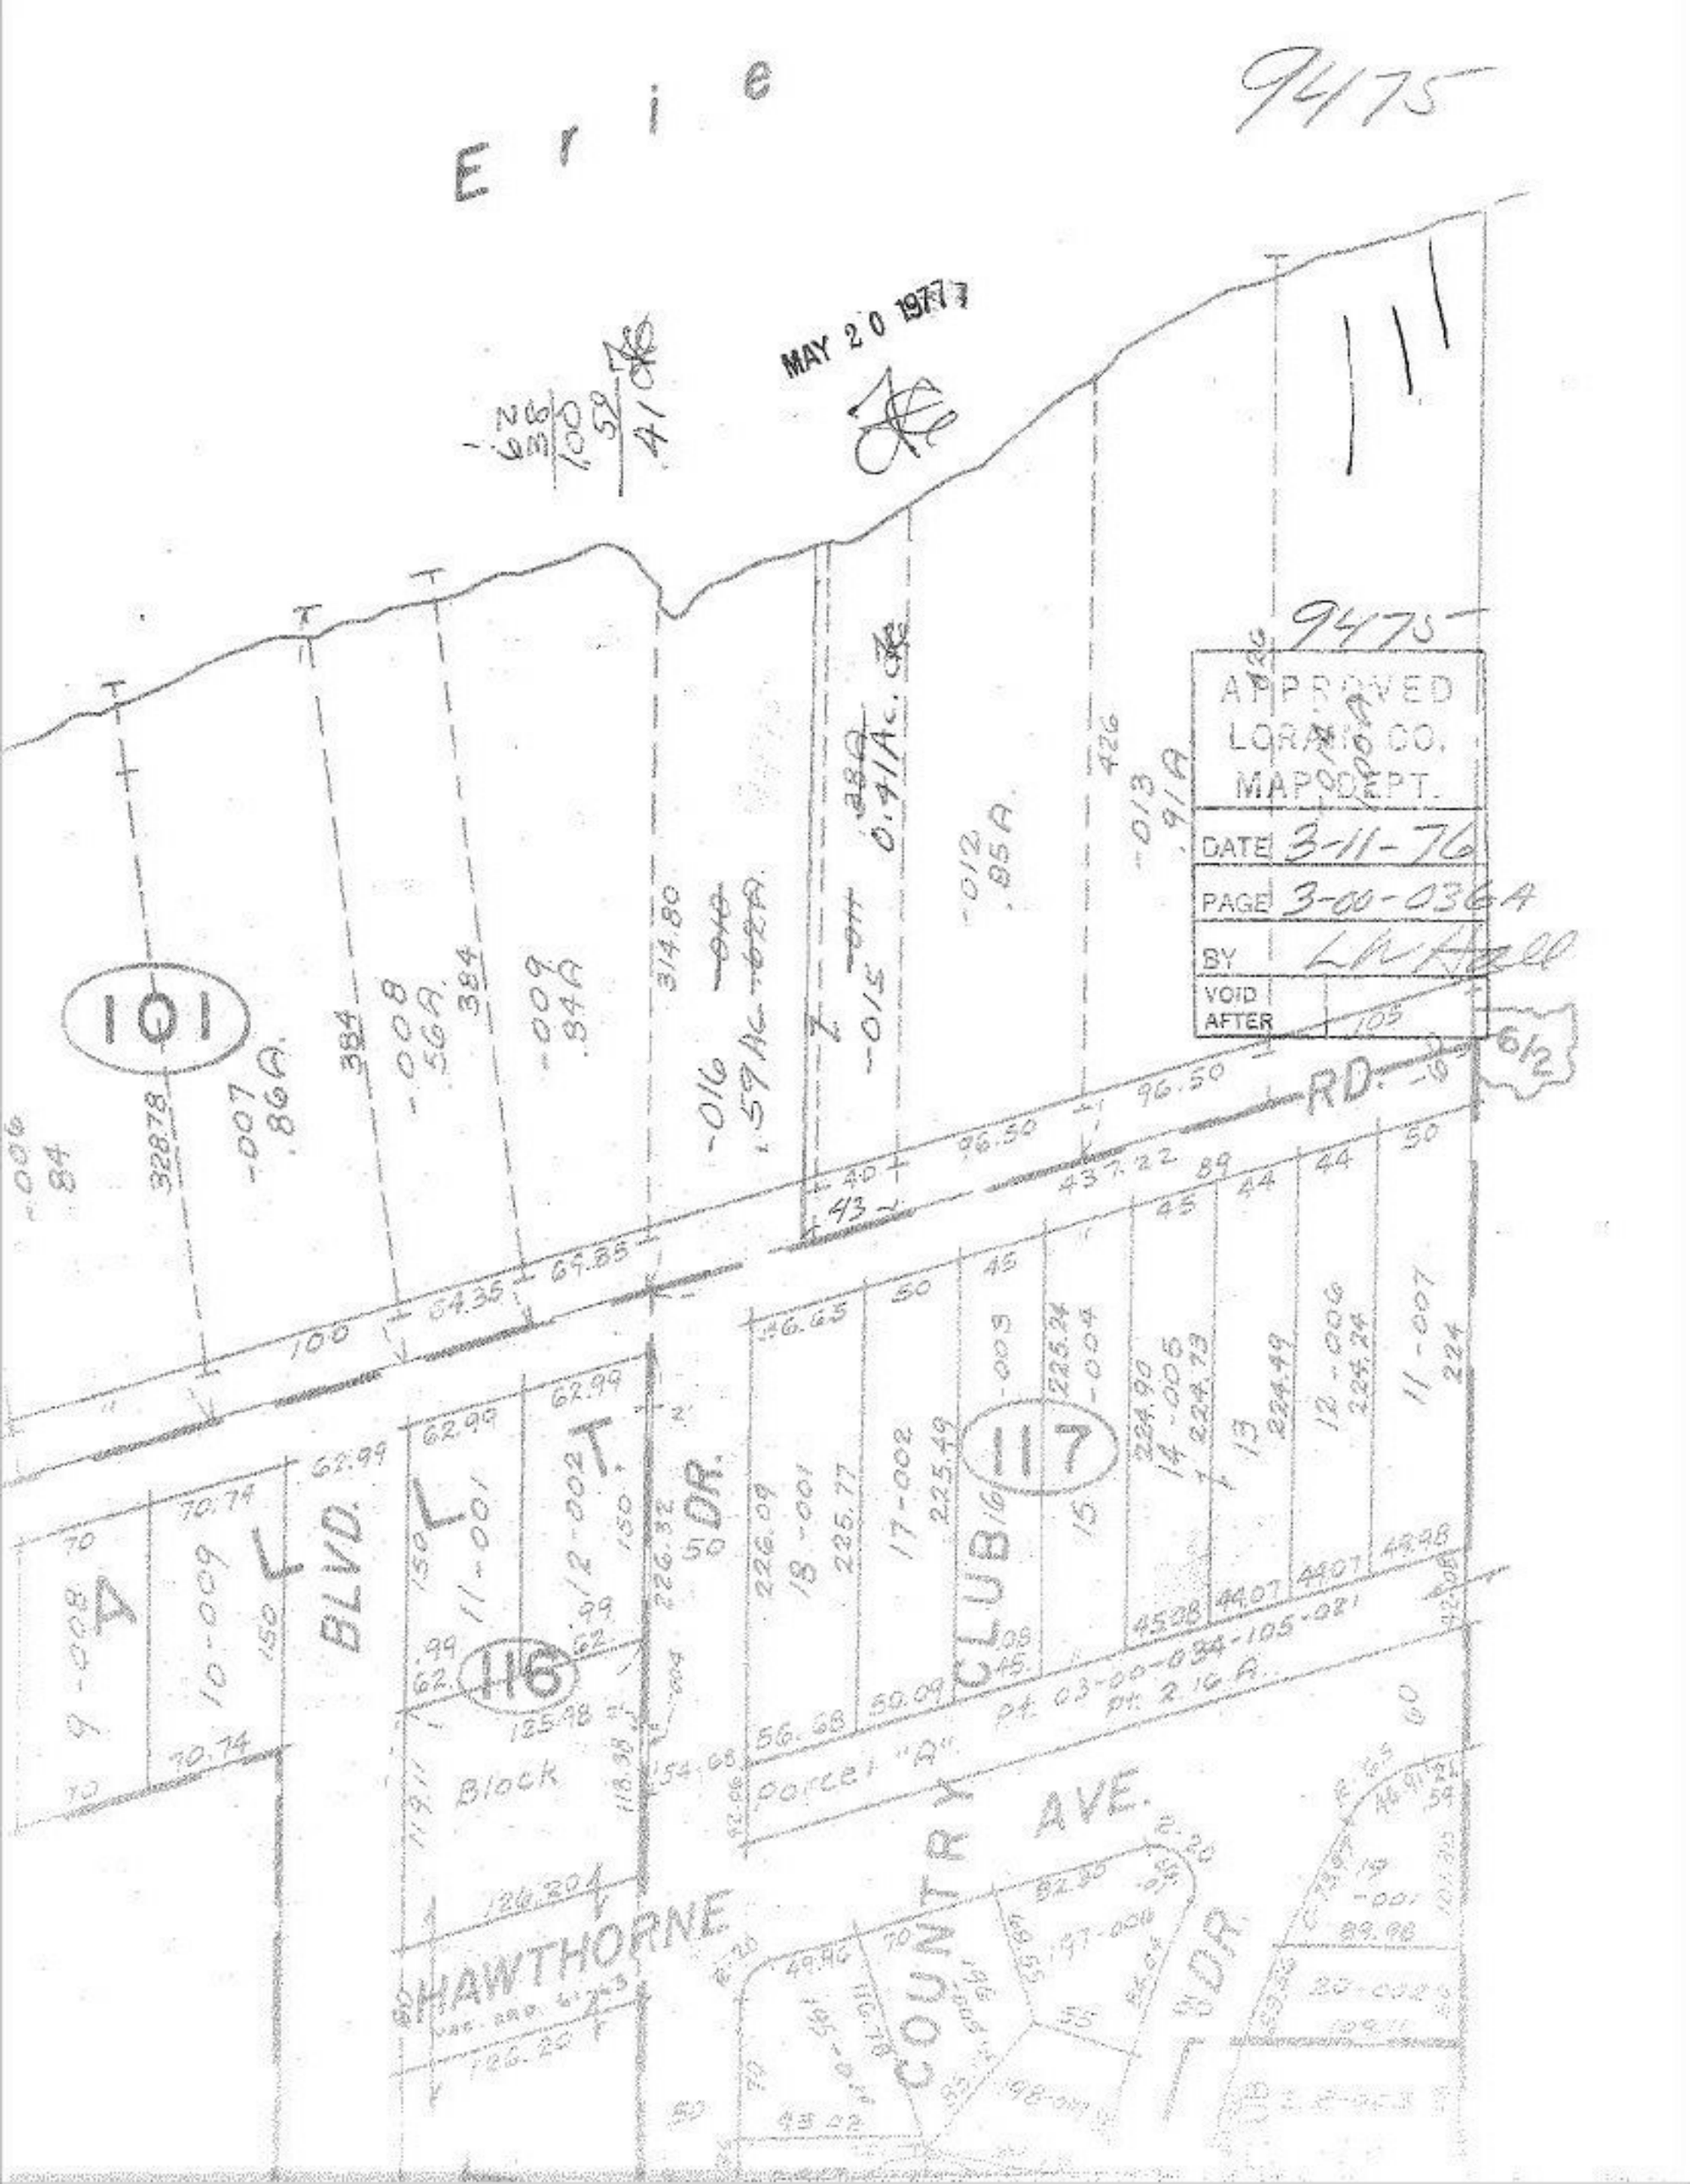

Erie
9475
MAY 20 1977
APPROVED
LORAIN CO.
MAP DEPT.
DATE 3-11-76
PAGE 3-00-036A
BY
VOID AFTER
101
116
117
RD.
BLVD.
DR.
CLUB
COUNTRY
AVE.
HAWTHORNE
Block
Parcel "A"
Pt. 03-00-034-105-021
Pt. 2.16 A.