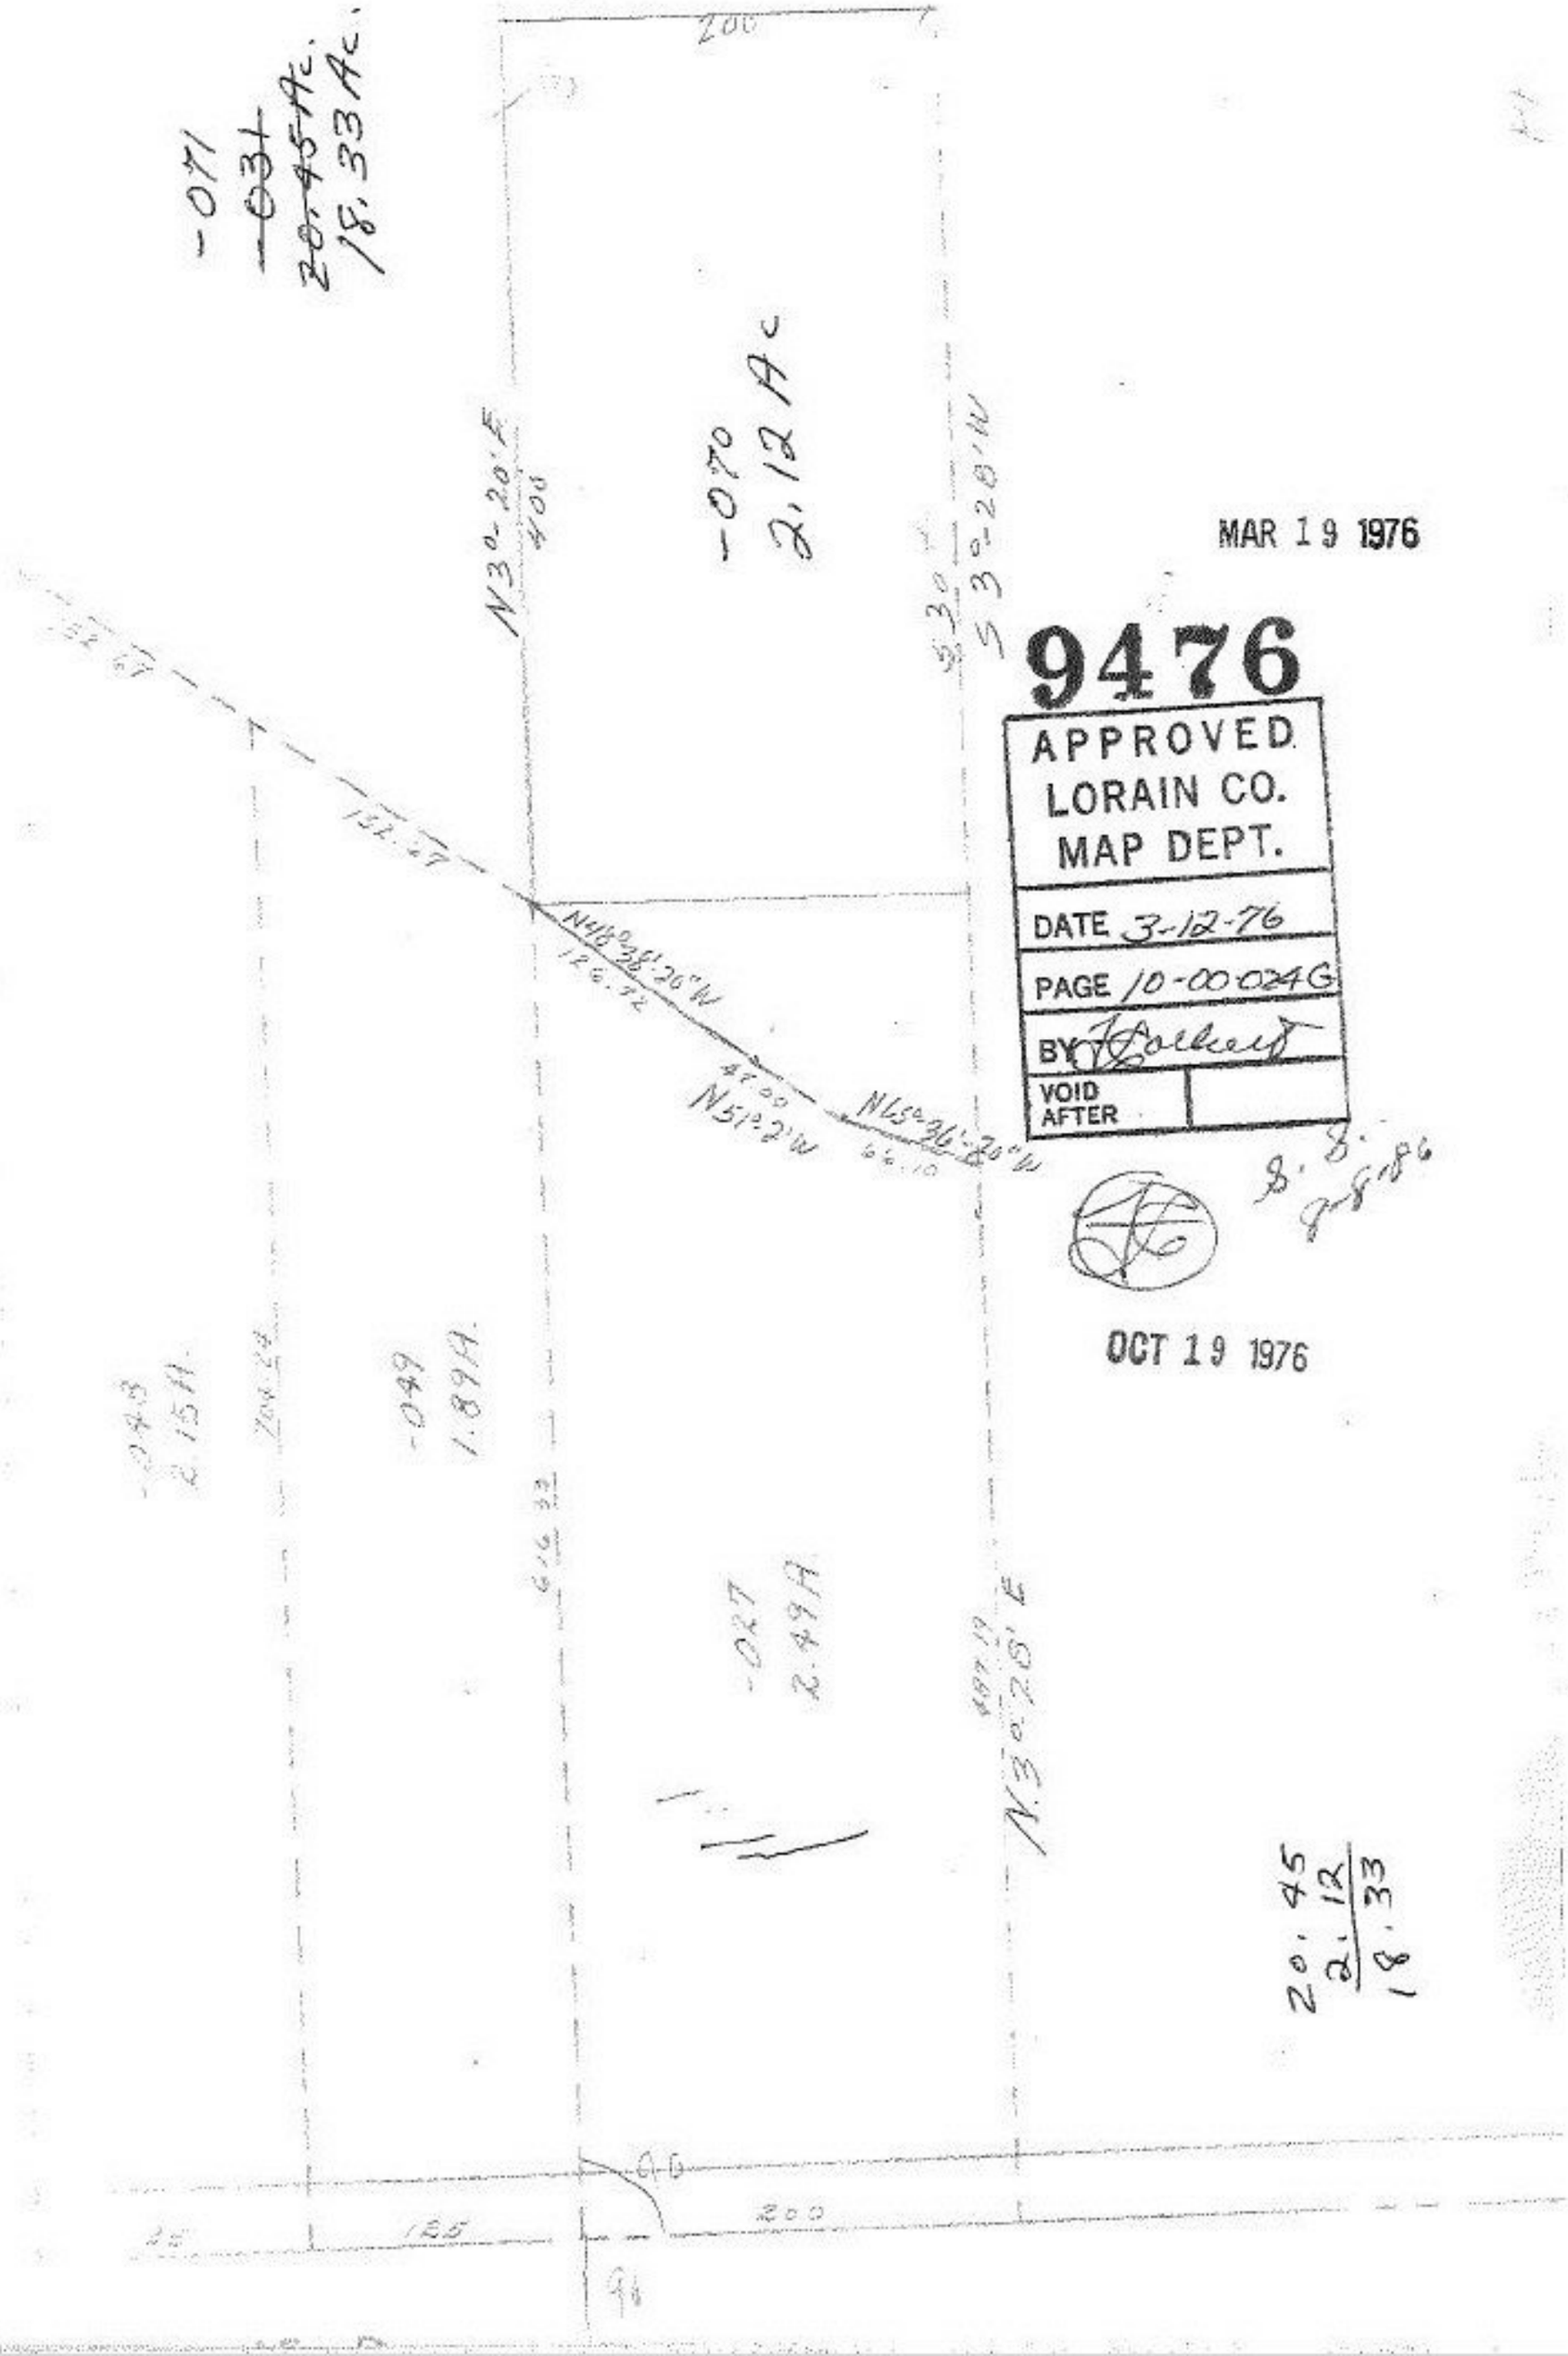

-071
~~-031~~
~~20.45 Ac.~~
18.33 Ac.
200
-070
2.12 Ac
N3°-20'E
400
S3°-28'W
MAR 19 1976
9476
APPROVED
LORAIN CO.
MAP DEPT.
DATE 3-12-76
PAGE 10-00-024G
BY
VOID AFTER
S. S.
8-8-86
OCT 19 1976
N48°38'20"W
126.72
N51°2'W
N65°36'20"W
66.10
-043
2.15A
-049
1.89A
-027
2.49A
N3°28'E
20.45
2.12
18.33
125
200