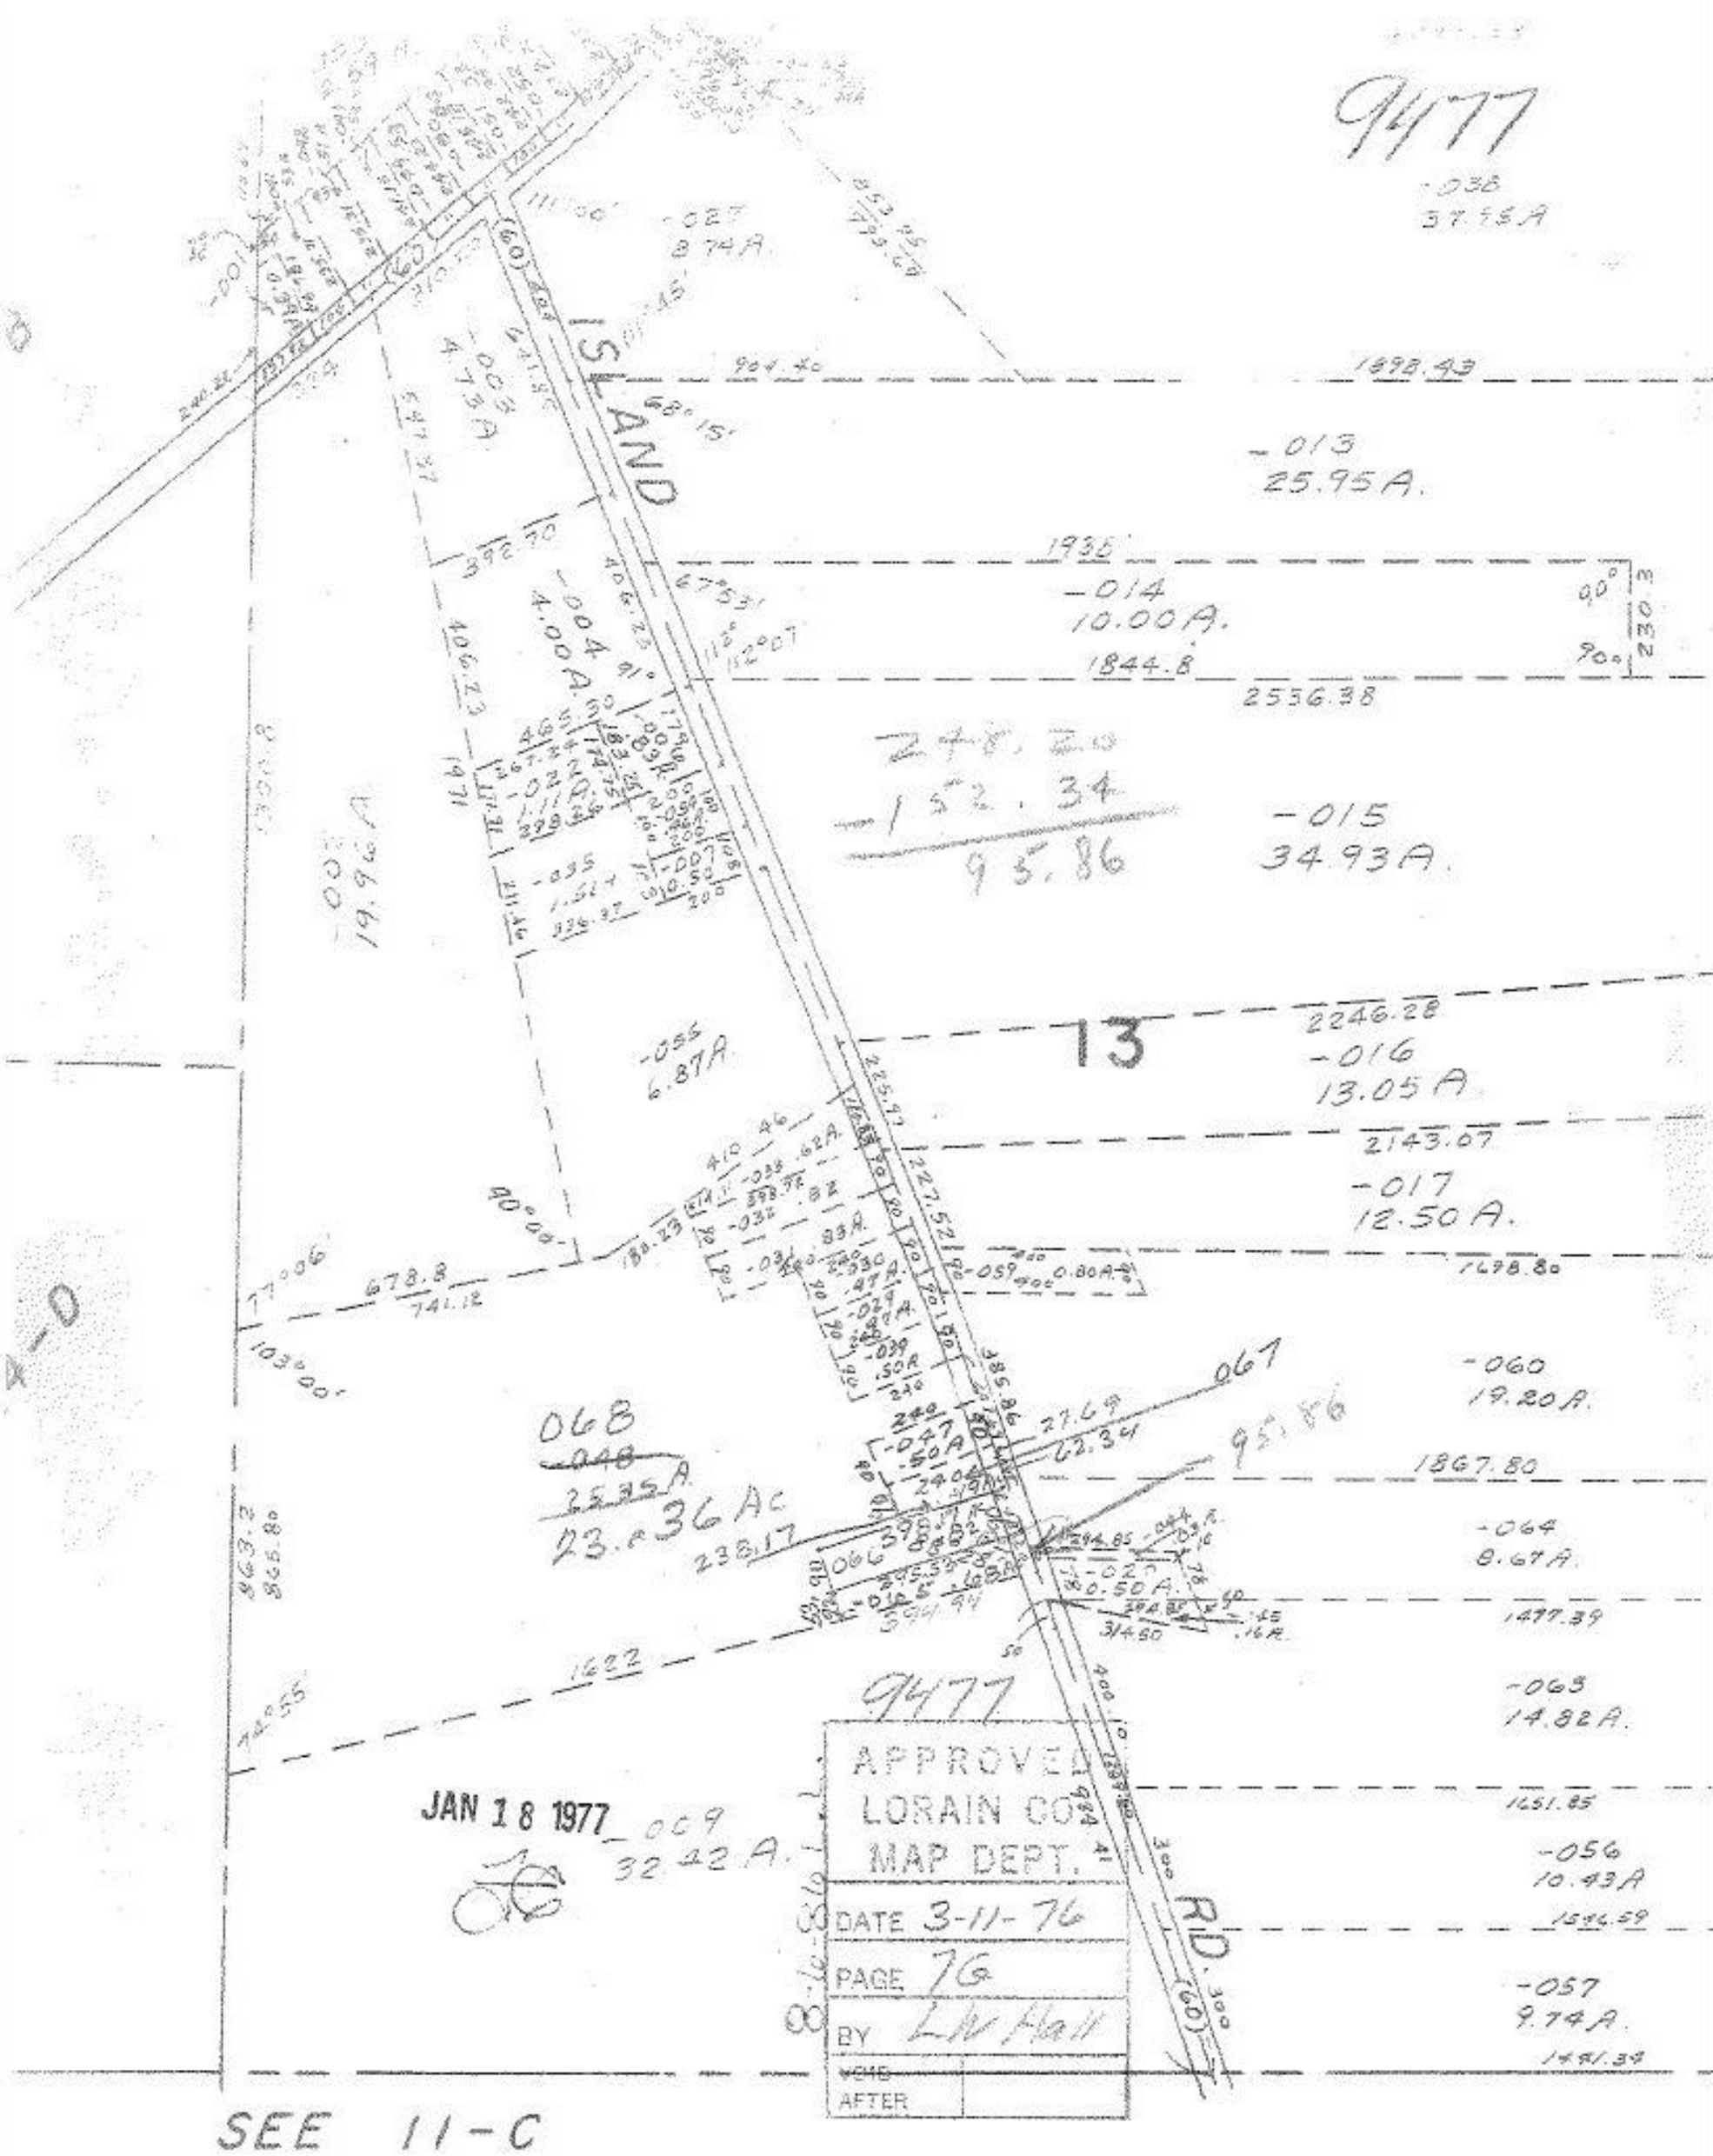
9477
-038
37.95A
-027
8.74A
ISLAND
904.40
1898.43
-013
25.95A.
1936
-014
10.00A.
1844.8
2536.38
-015
34.93A.
248.20
-152.34
95.86
13
2246.28
-016
13.05A
2143.07
-017
12.50A.
1698.80
-060
19.20A.
1867.80
-064
8.67A.
1477.39
-063
14.82A.
1651.85
-056
10.43A
1546.59
-057
9.74A.
1441.34
-004
4.00A.
-003
4.73A
-022
1.11A
-035
1.51A
-055
6.87A
-002
19.96A
068
-048
2535A
23.36Ac
238.17
067
95.86
1622
9477
-009
32.42A.
JAN 18 1977
APPROVED
LORAIN CO.
MAP DEPT.
DATE 3-11-76
PAGE 76
BY LW Hall
VOID
AFTER
RD.
SEE 11-C