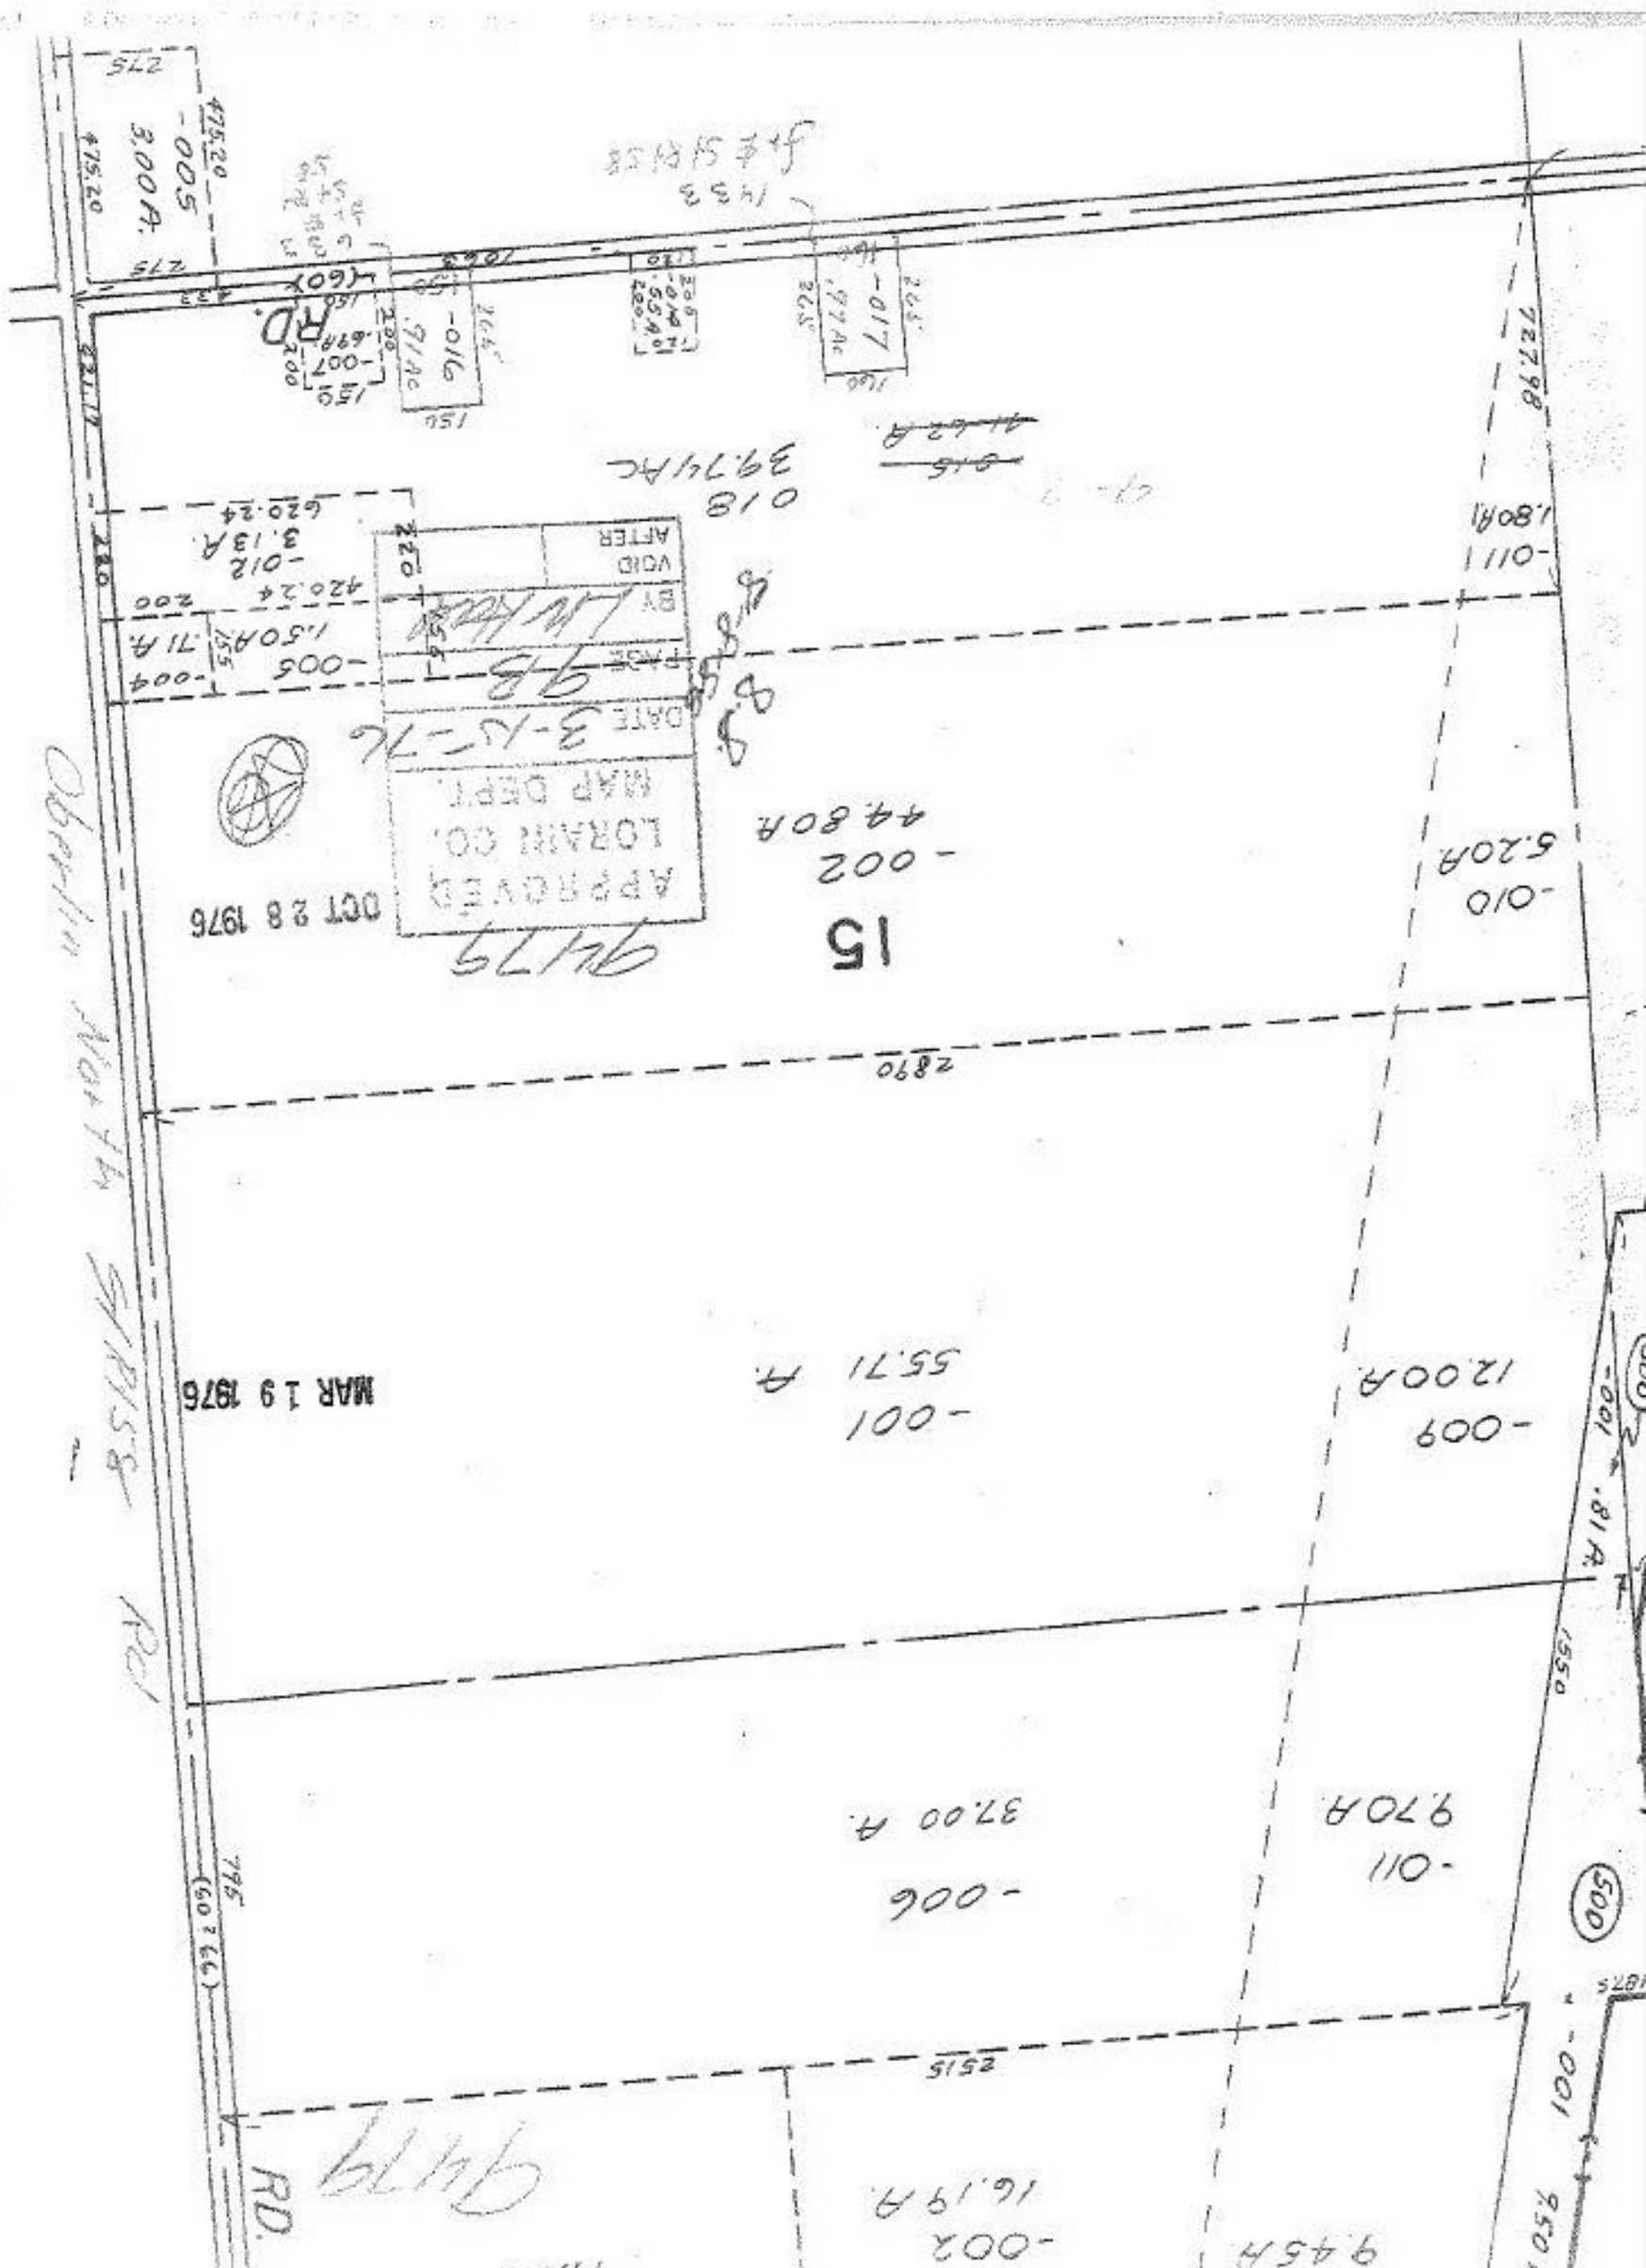
15
APPROVED
LORAIN CO.
MAP DEPT.
OCT 28 1976
MAR 19 1976
RD.
-002
44.80A
-010
6.20A
-011
1.80A
-005
1.50AC
.71 A.
-012
3.13A
-006
37.00 A.
-001
55.71 A.
-009
12.00A
-007
.49Ac.
-010
.91Ac.
-008
.47Ac.
-002
16.19 A.
-011
9.70A
-010
9.45A
018
39.74Ac
2890
2515
1550
1050
500
300
150
200
420.24
620.24
475.20
3.00A.
-005