9480

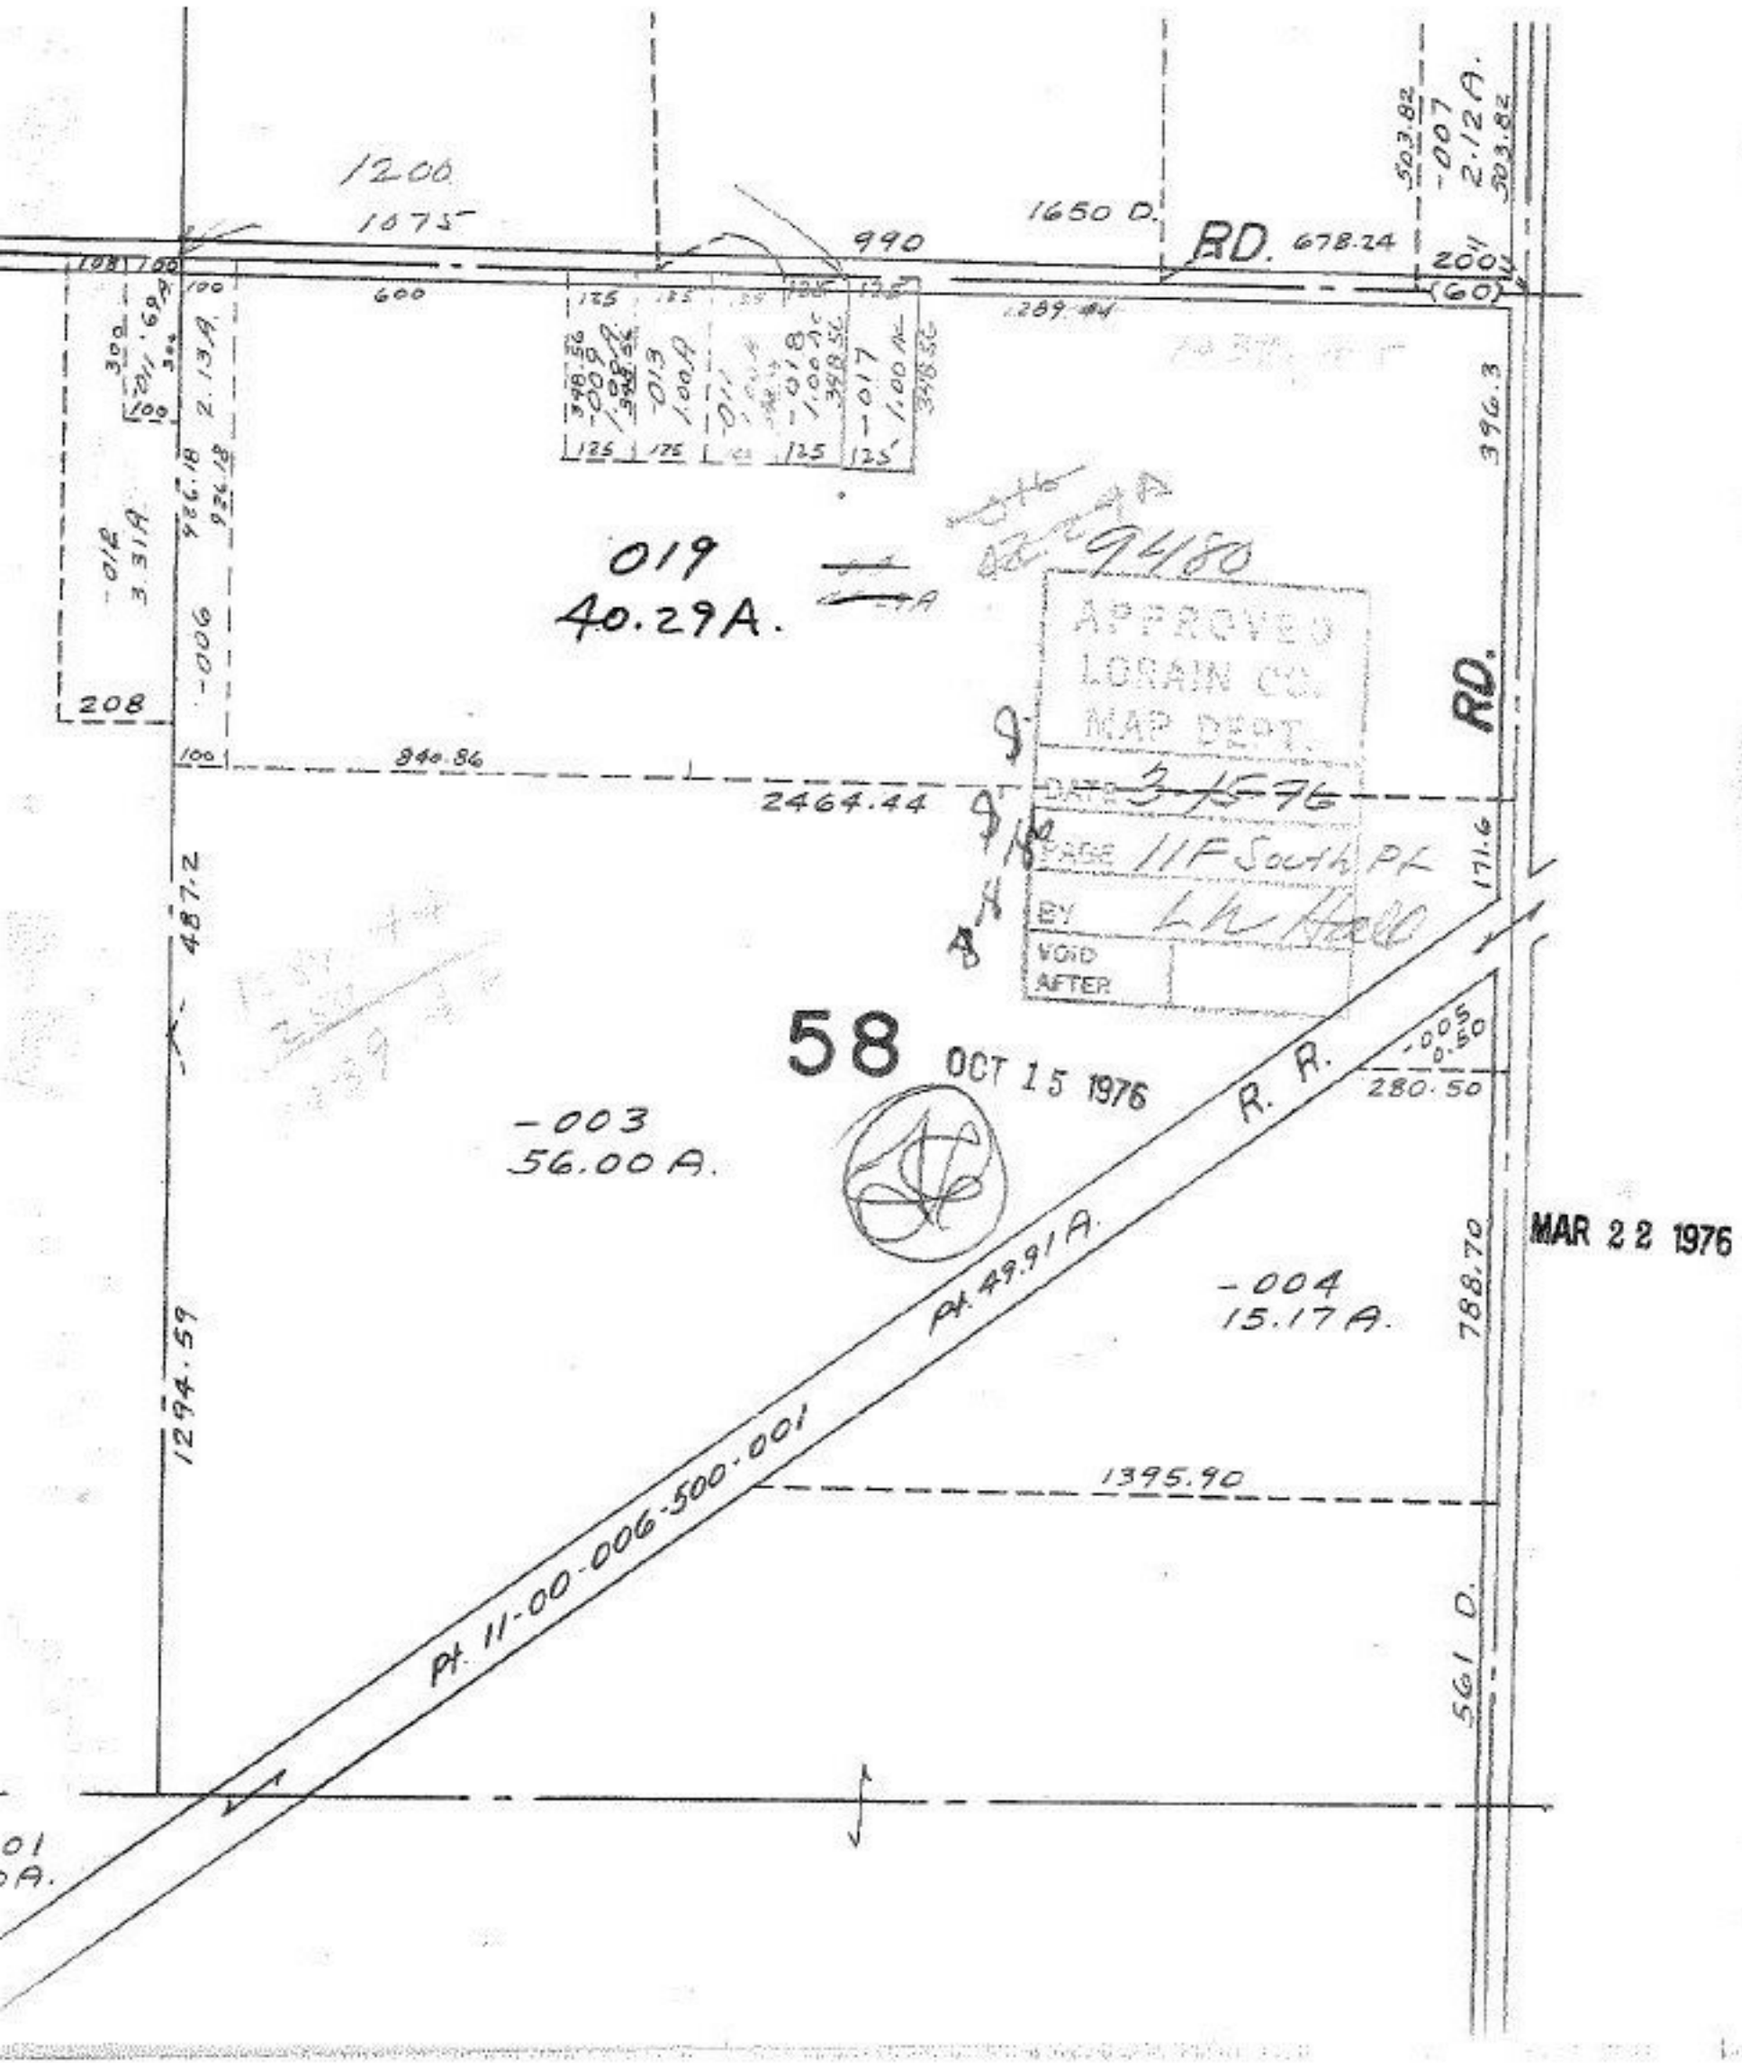

1200
1075
990
1650 D.
RD. 678.24
503.82
-007
2.12A.
503.82
200
(60)
600
1289.44
396.3
019
40.29A.
9480
APPROVED
LORAIN CO.
MAP DEPT.
DATE 3-15-76
PAGE 11F South PL
BY LH Hall
VOID
AFTER
RD.
208
840.86
2464.44
171.6
487.2
58
OCT 15 1976
R. R.
-005
0.50
280.50
-003
56.00 A.
MAR 22 1976
Pt. 49.91 A.
-004
15.17 A.
788.70
1294.59
1395.90
Pt. 11-00-006-500-001
561 D.