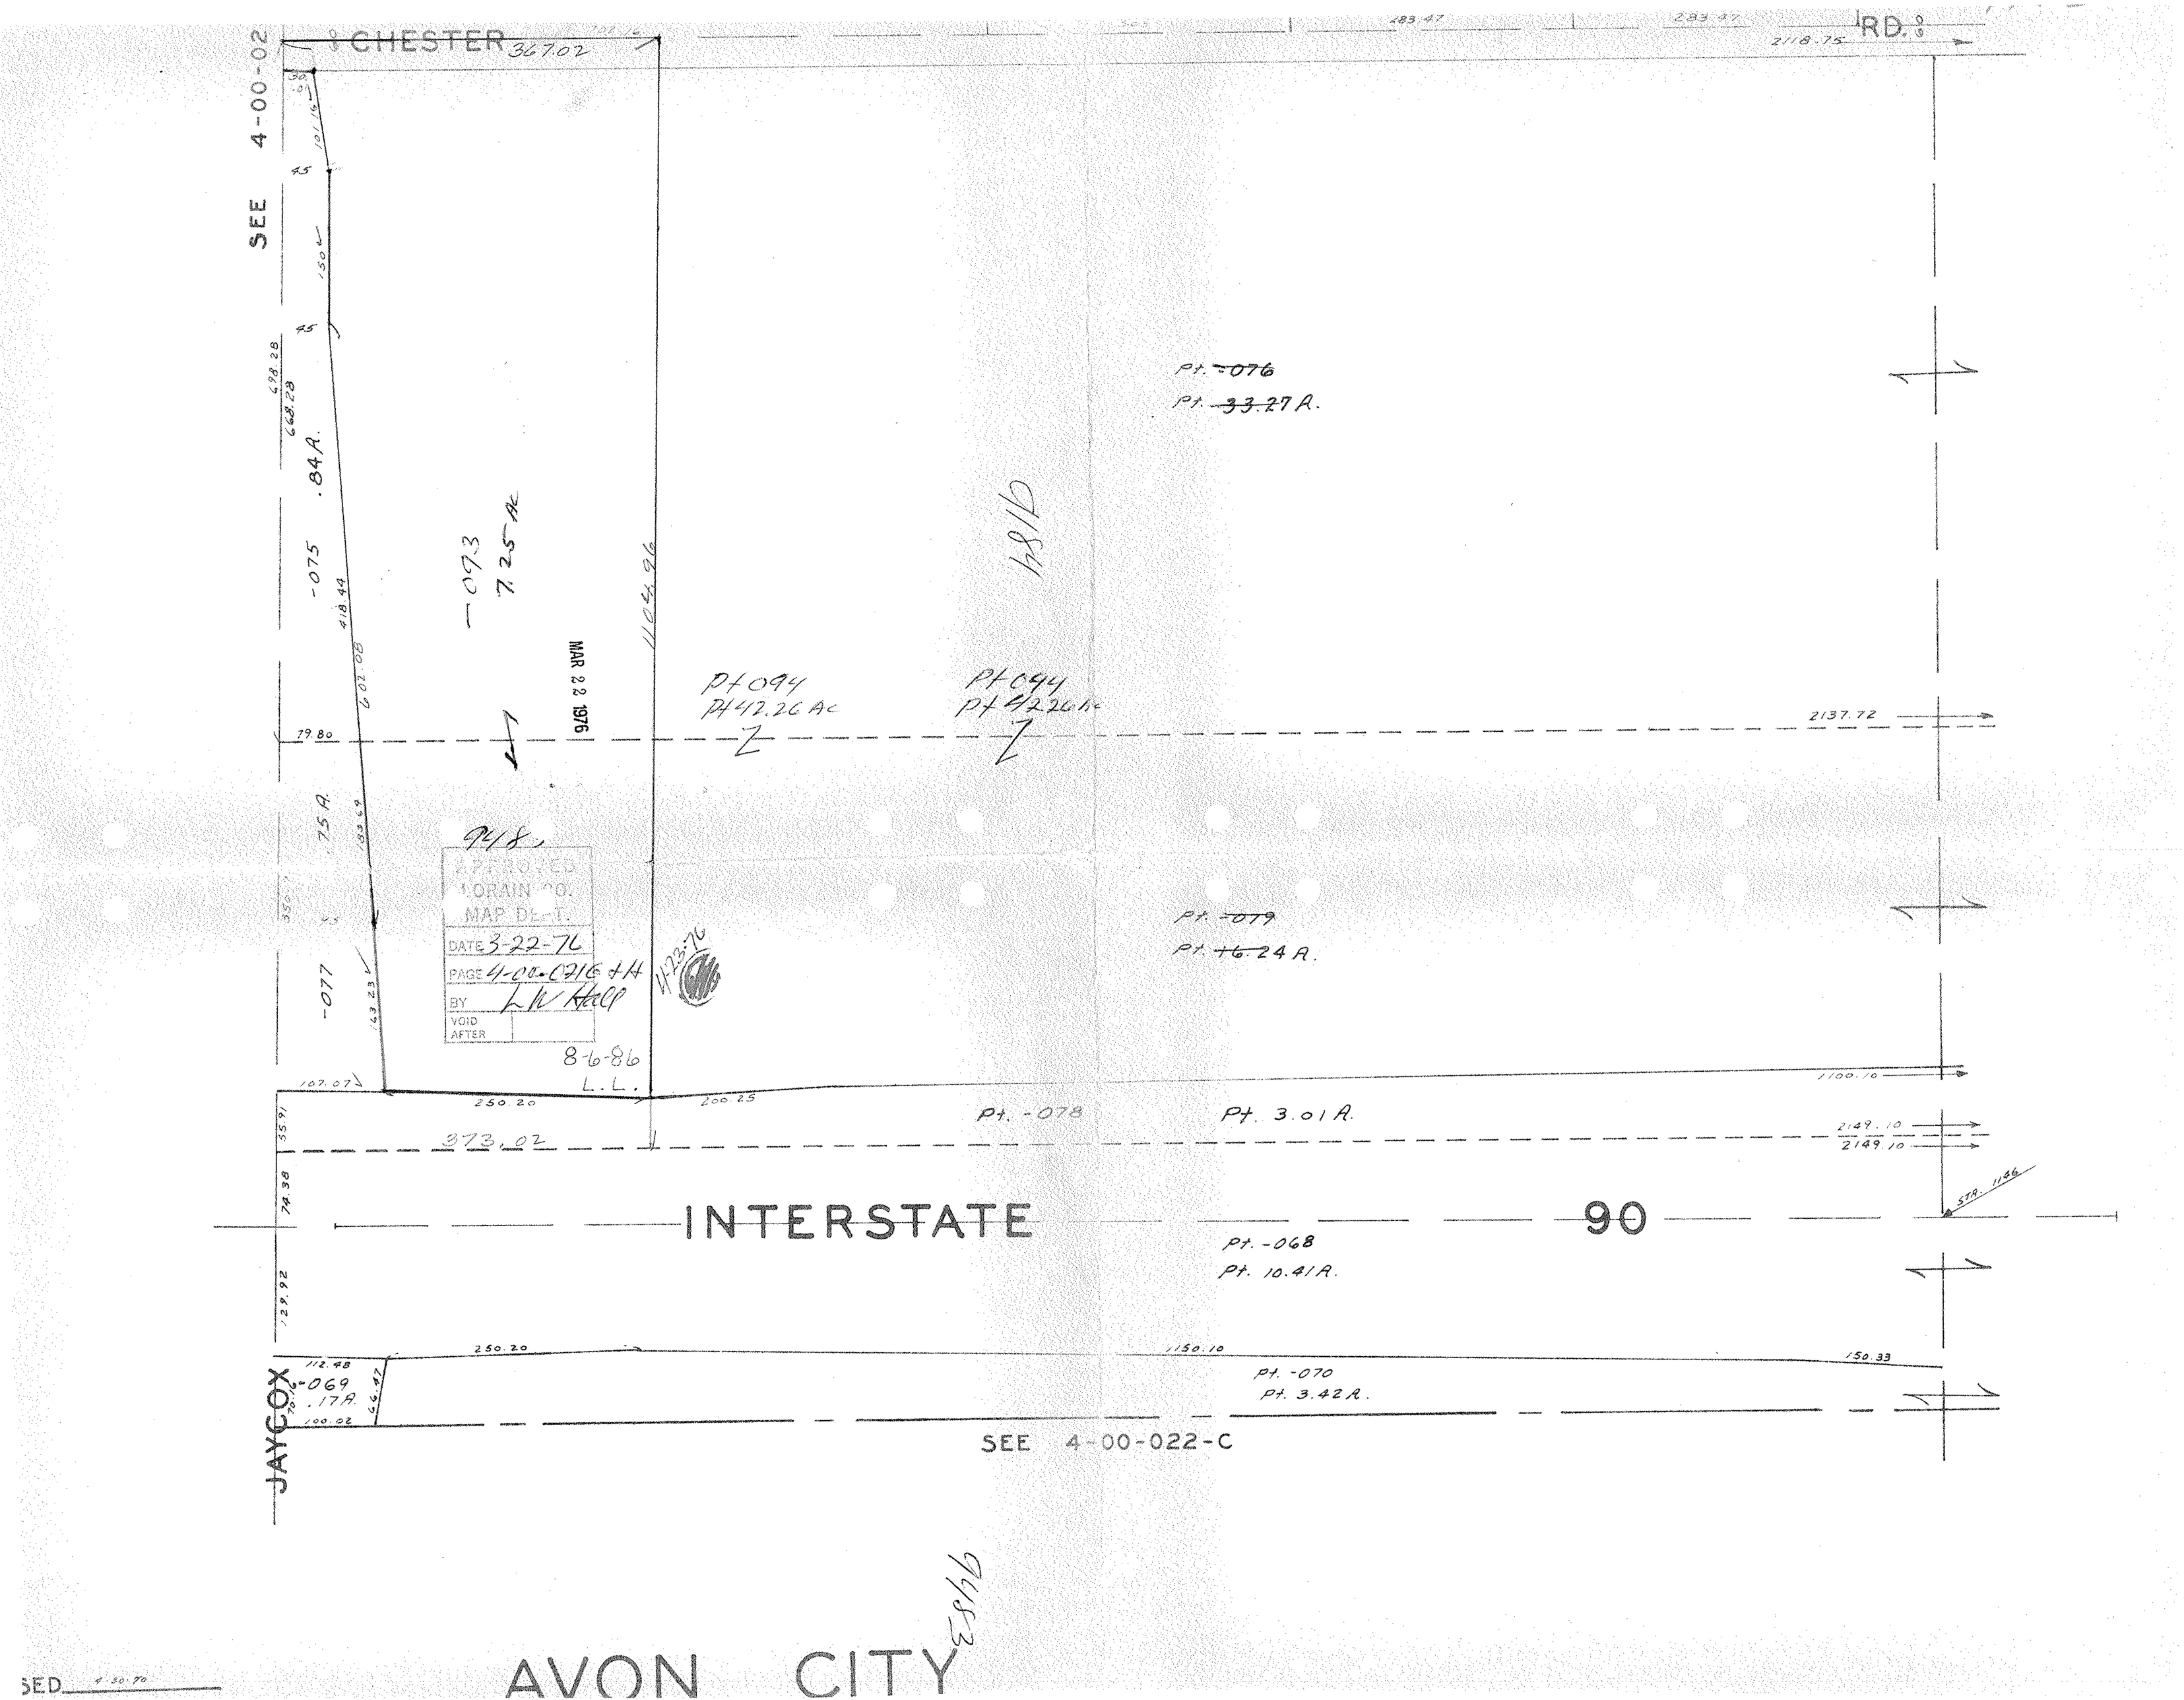
CHESTER
RD.
SEE 4-00-02
367.02
2118.75
Pt. -076
Pt. 33.27 A.
-075 .84 A.
-093 7.25 Ac
1104.96
MAR 22 1976
Pt 094
Pt 42.26 Ac
Pt 094
Pt 42.26 Ac
2137.72
79.80
.75 A.
-077
948
APPROVED
LORAIN CO.
MAP DEPT.
DATE 3-22-76
PAGE 4-00-021G + H
BY L W Hall
VOID AFTER
8-6-86
L.L.
Pt. -079
Pt. 16.24 A.
1100.10
250.20
200.25
Pt. -078
Pt. 3.01 A.
373.02
2149.10
2149.10
INTERSTATE
90
Pt. -068
Pt. 10.41 A.
250.20
1150.10
150.33
Pt. -070
Pt. 3.42 A.
-069 .17 A.
JAYCOX
SEE 4-00-022-C
AVON CITY