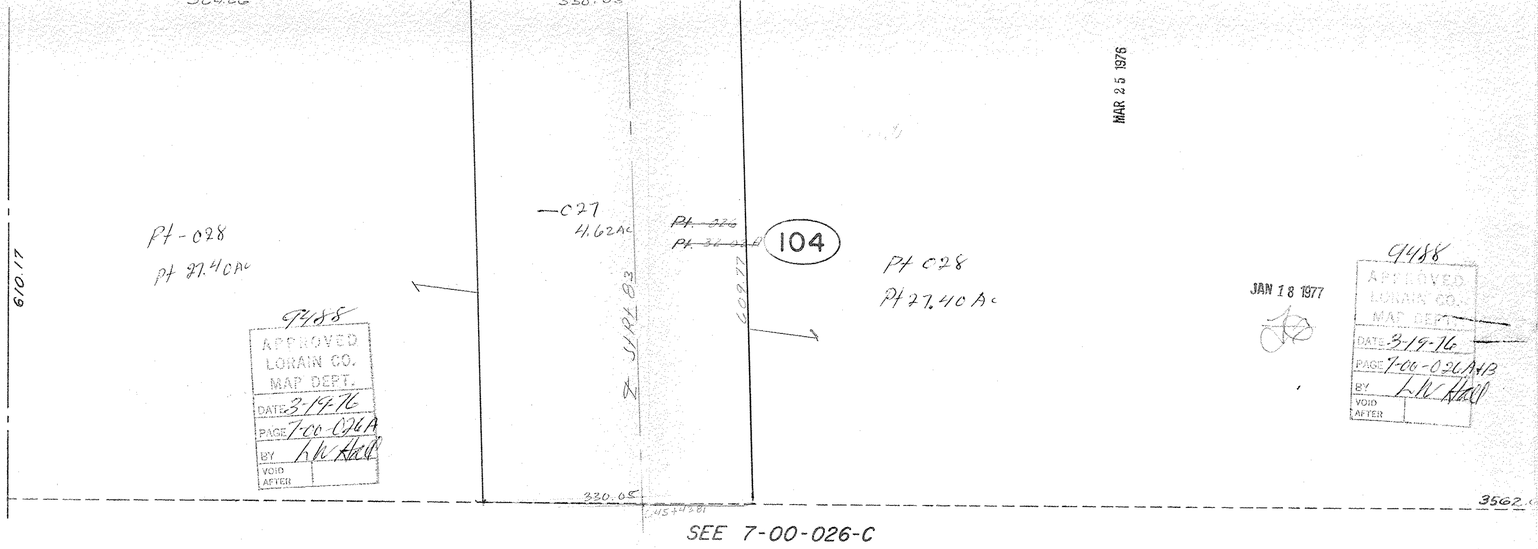

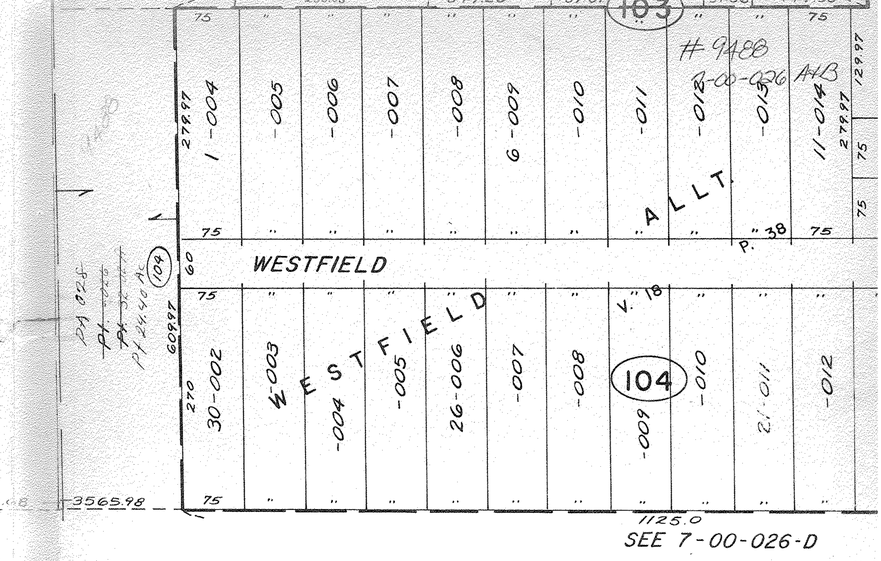

Copyright 1964
Revised 3-14-73

7-00-026-A

RIDGEVILLE TWP.

SCALE: 1" = 100'

NW 1/4 LOT 26

RIDGEVILLE TWP.

7-00-026B

SCALE 1" = 100'