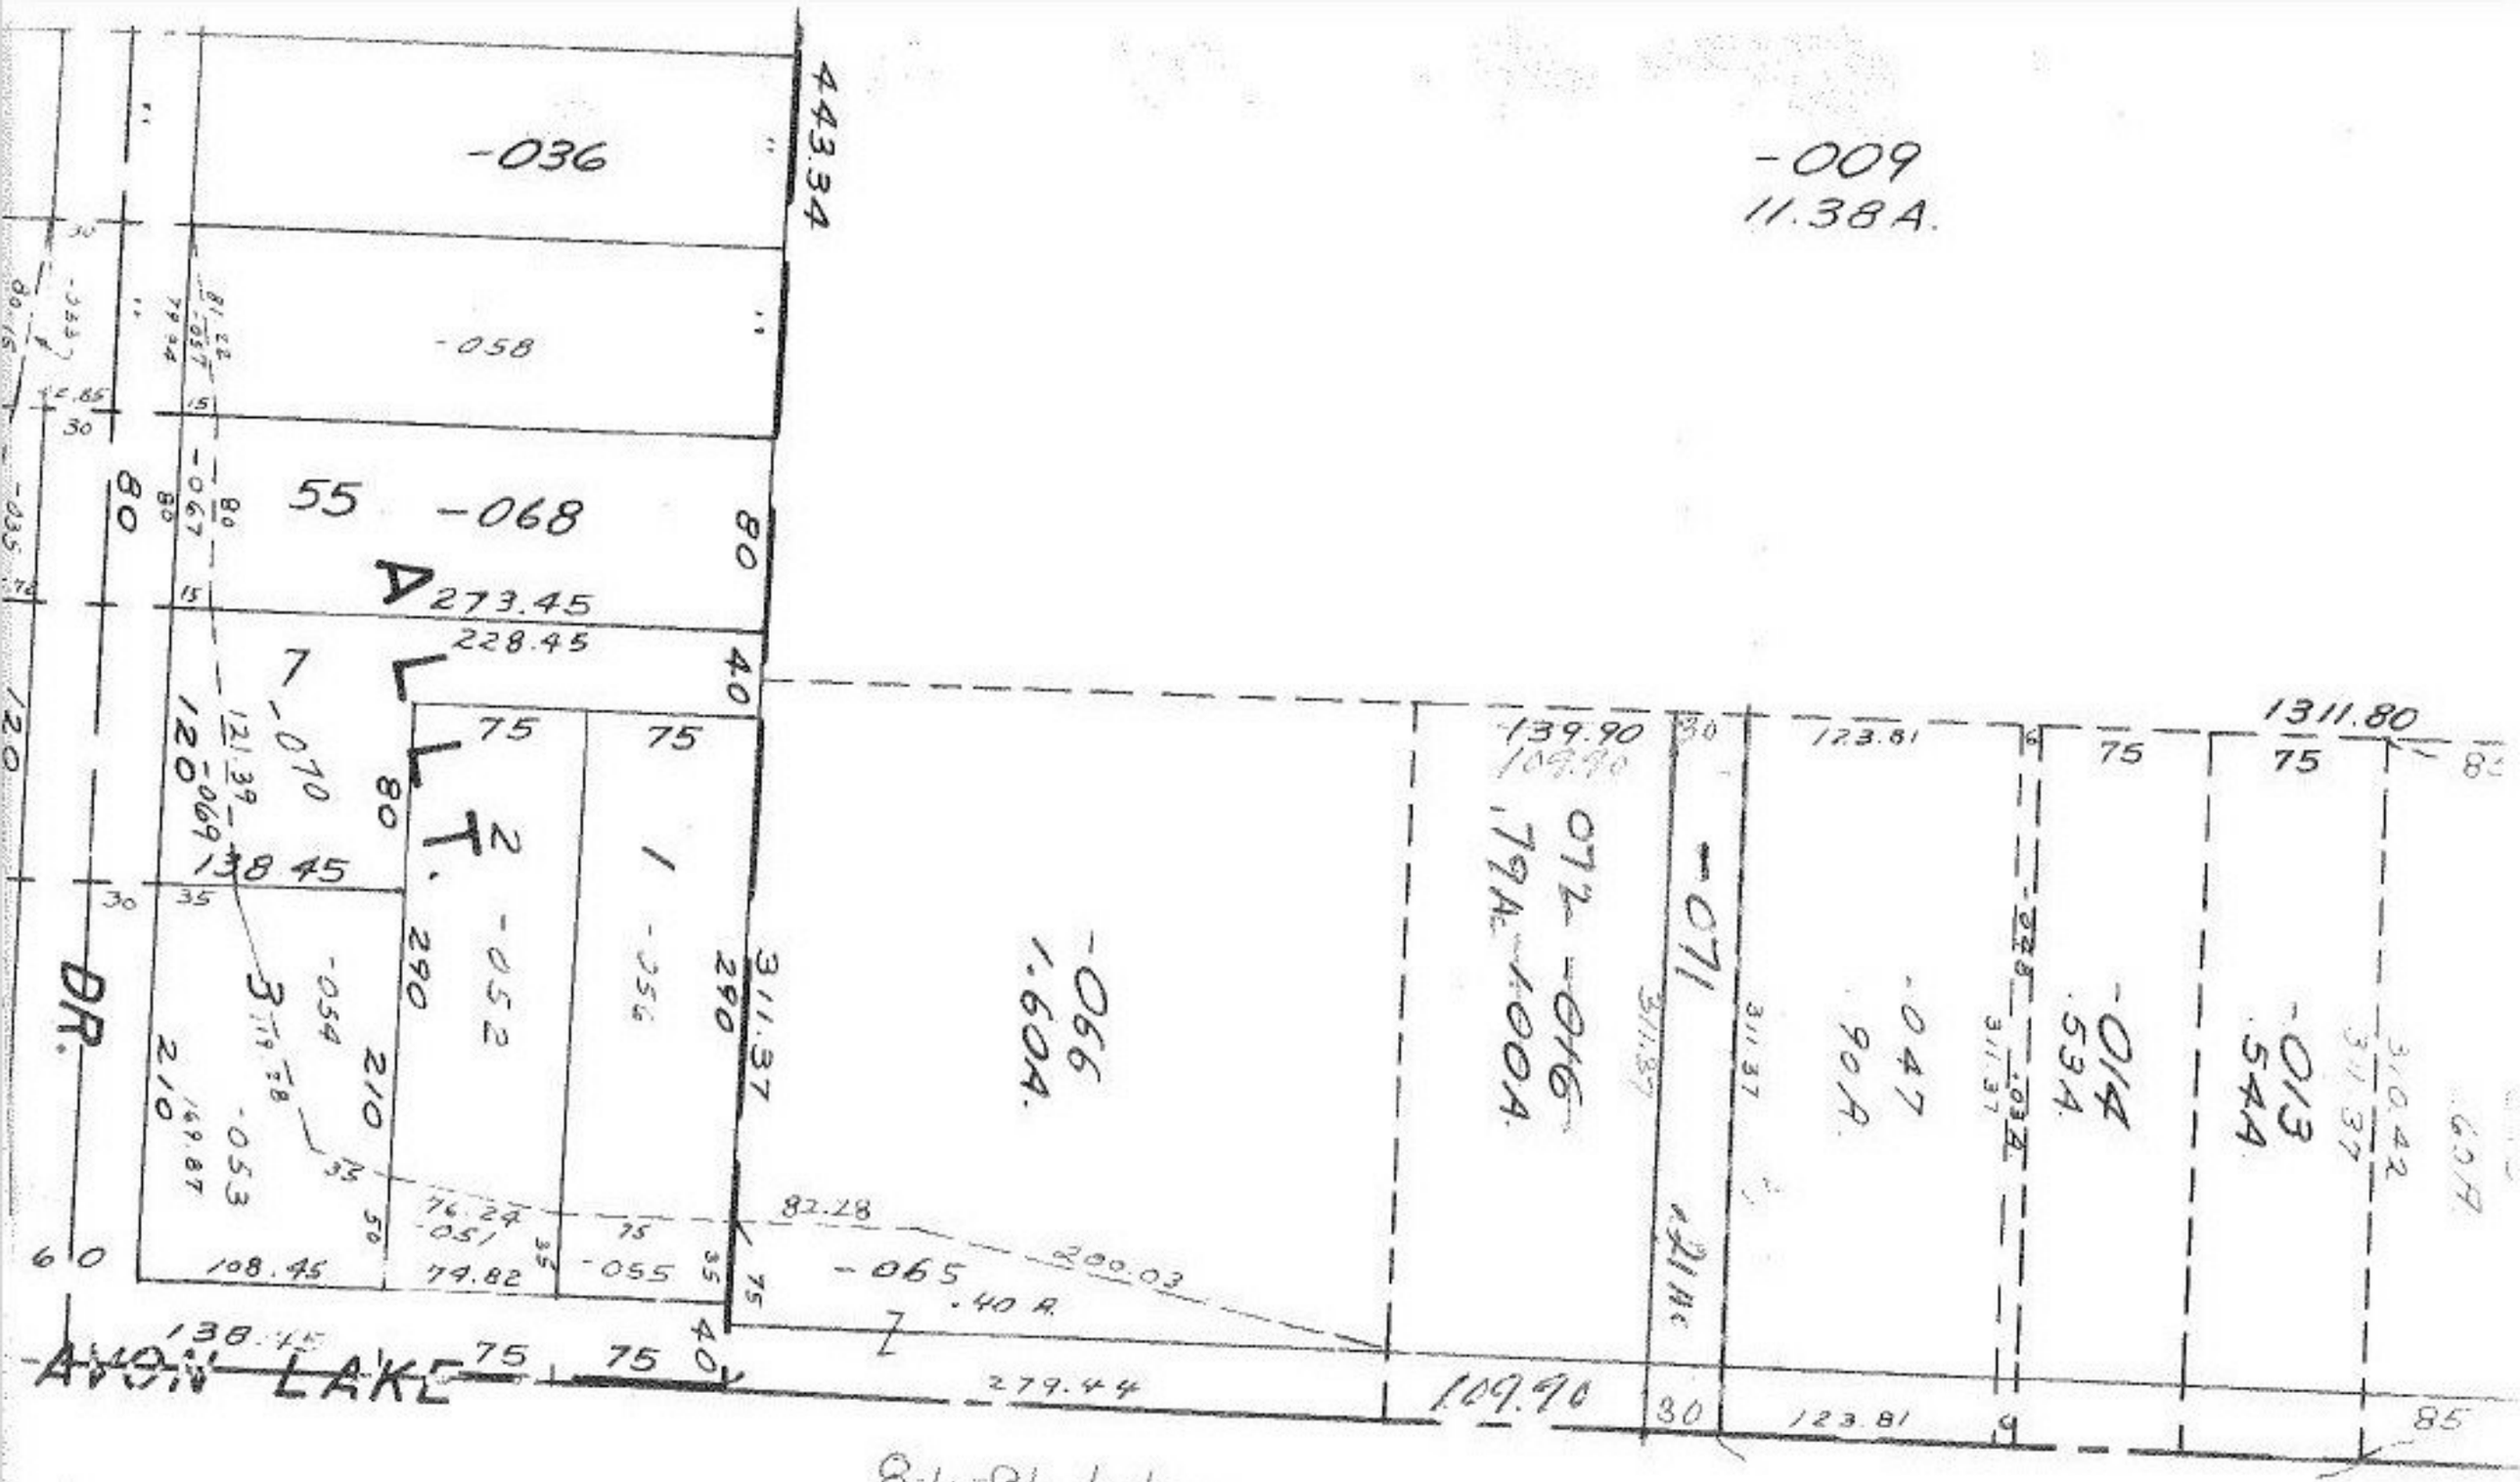

APPROVED
LORAIN CO.
MAP DEPT.
DATE 3-26-76
PAGE 7-11-075 B
BY
VOID AFTER

8-6-86 L.L.

JAN 18 1977

MAR 26 1976

9512

9512