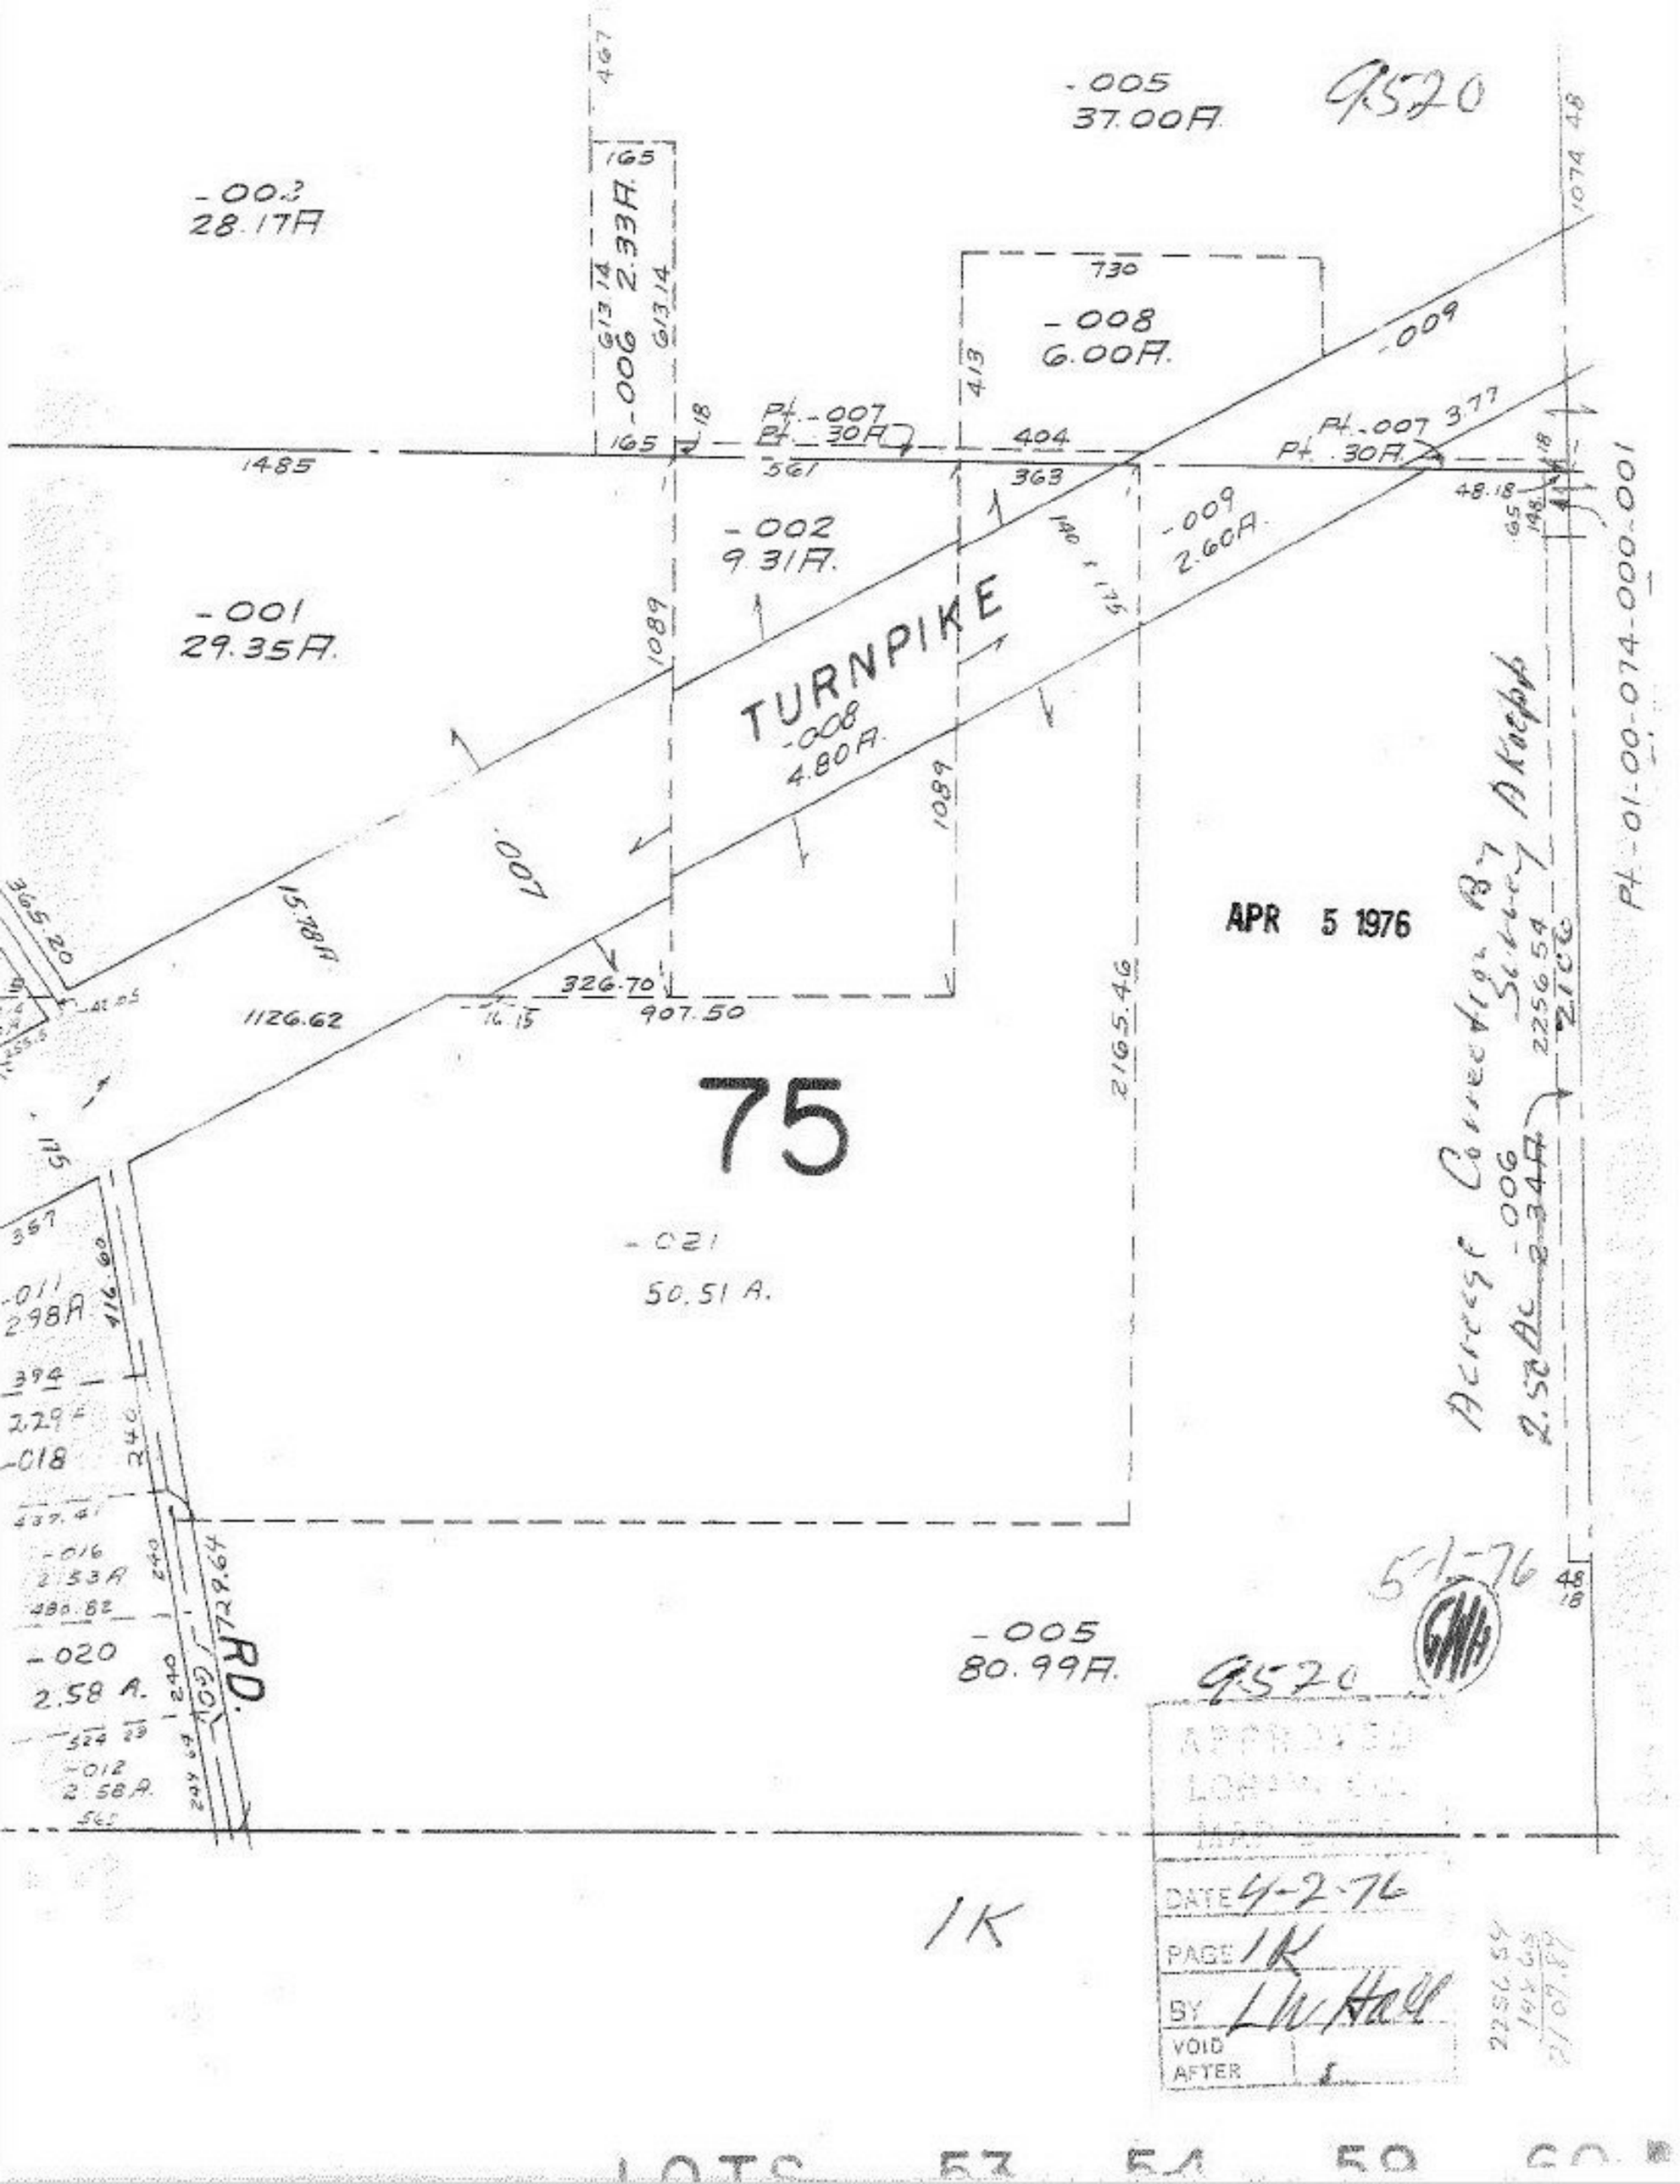

-005
37.00A.
9520
-003
28.17A
-006 2.33A.
-008
6.00A.
-009
Pt.-007
Pt. 30A
-002
9.31A.
-001
29.35A.
TURNPIKE
-008
4.80A.
-009
2.60A.
-007
15.78A
75
-021
50.51 A.
-011
2.98A
-018
-016
2.53A
-020
2.58 A.
-012
2.58A.
RD.
-005
80.99A.
APR 5 1976
Acreage Correction By Survey
-006
2.50 Ac
2256.54
2106
Pt.-01-00-074-000-001
5-1-76
9520
APPROVED
DATE 4-2-76
PAGE 1K
BY L.W. Hall
VOID AFTER
1K
LOTS 53 54 59 60