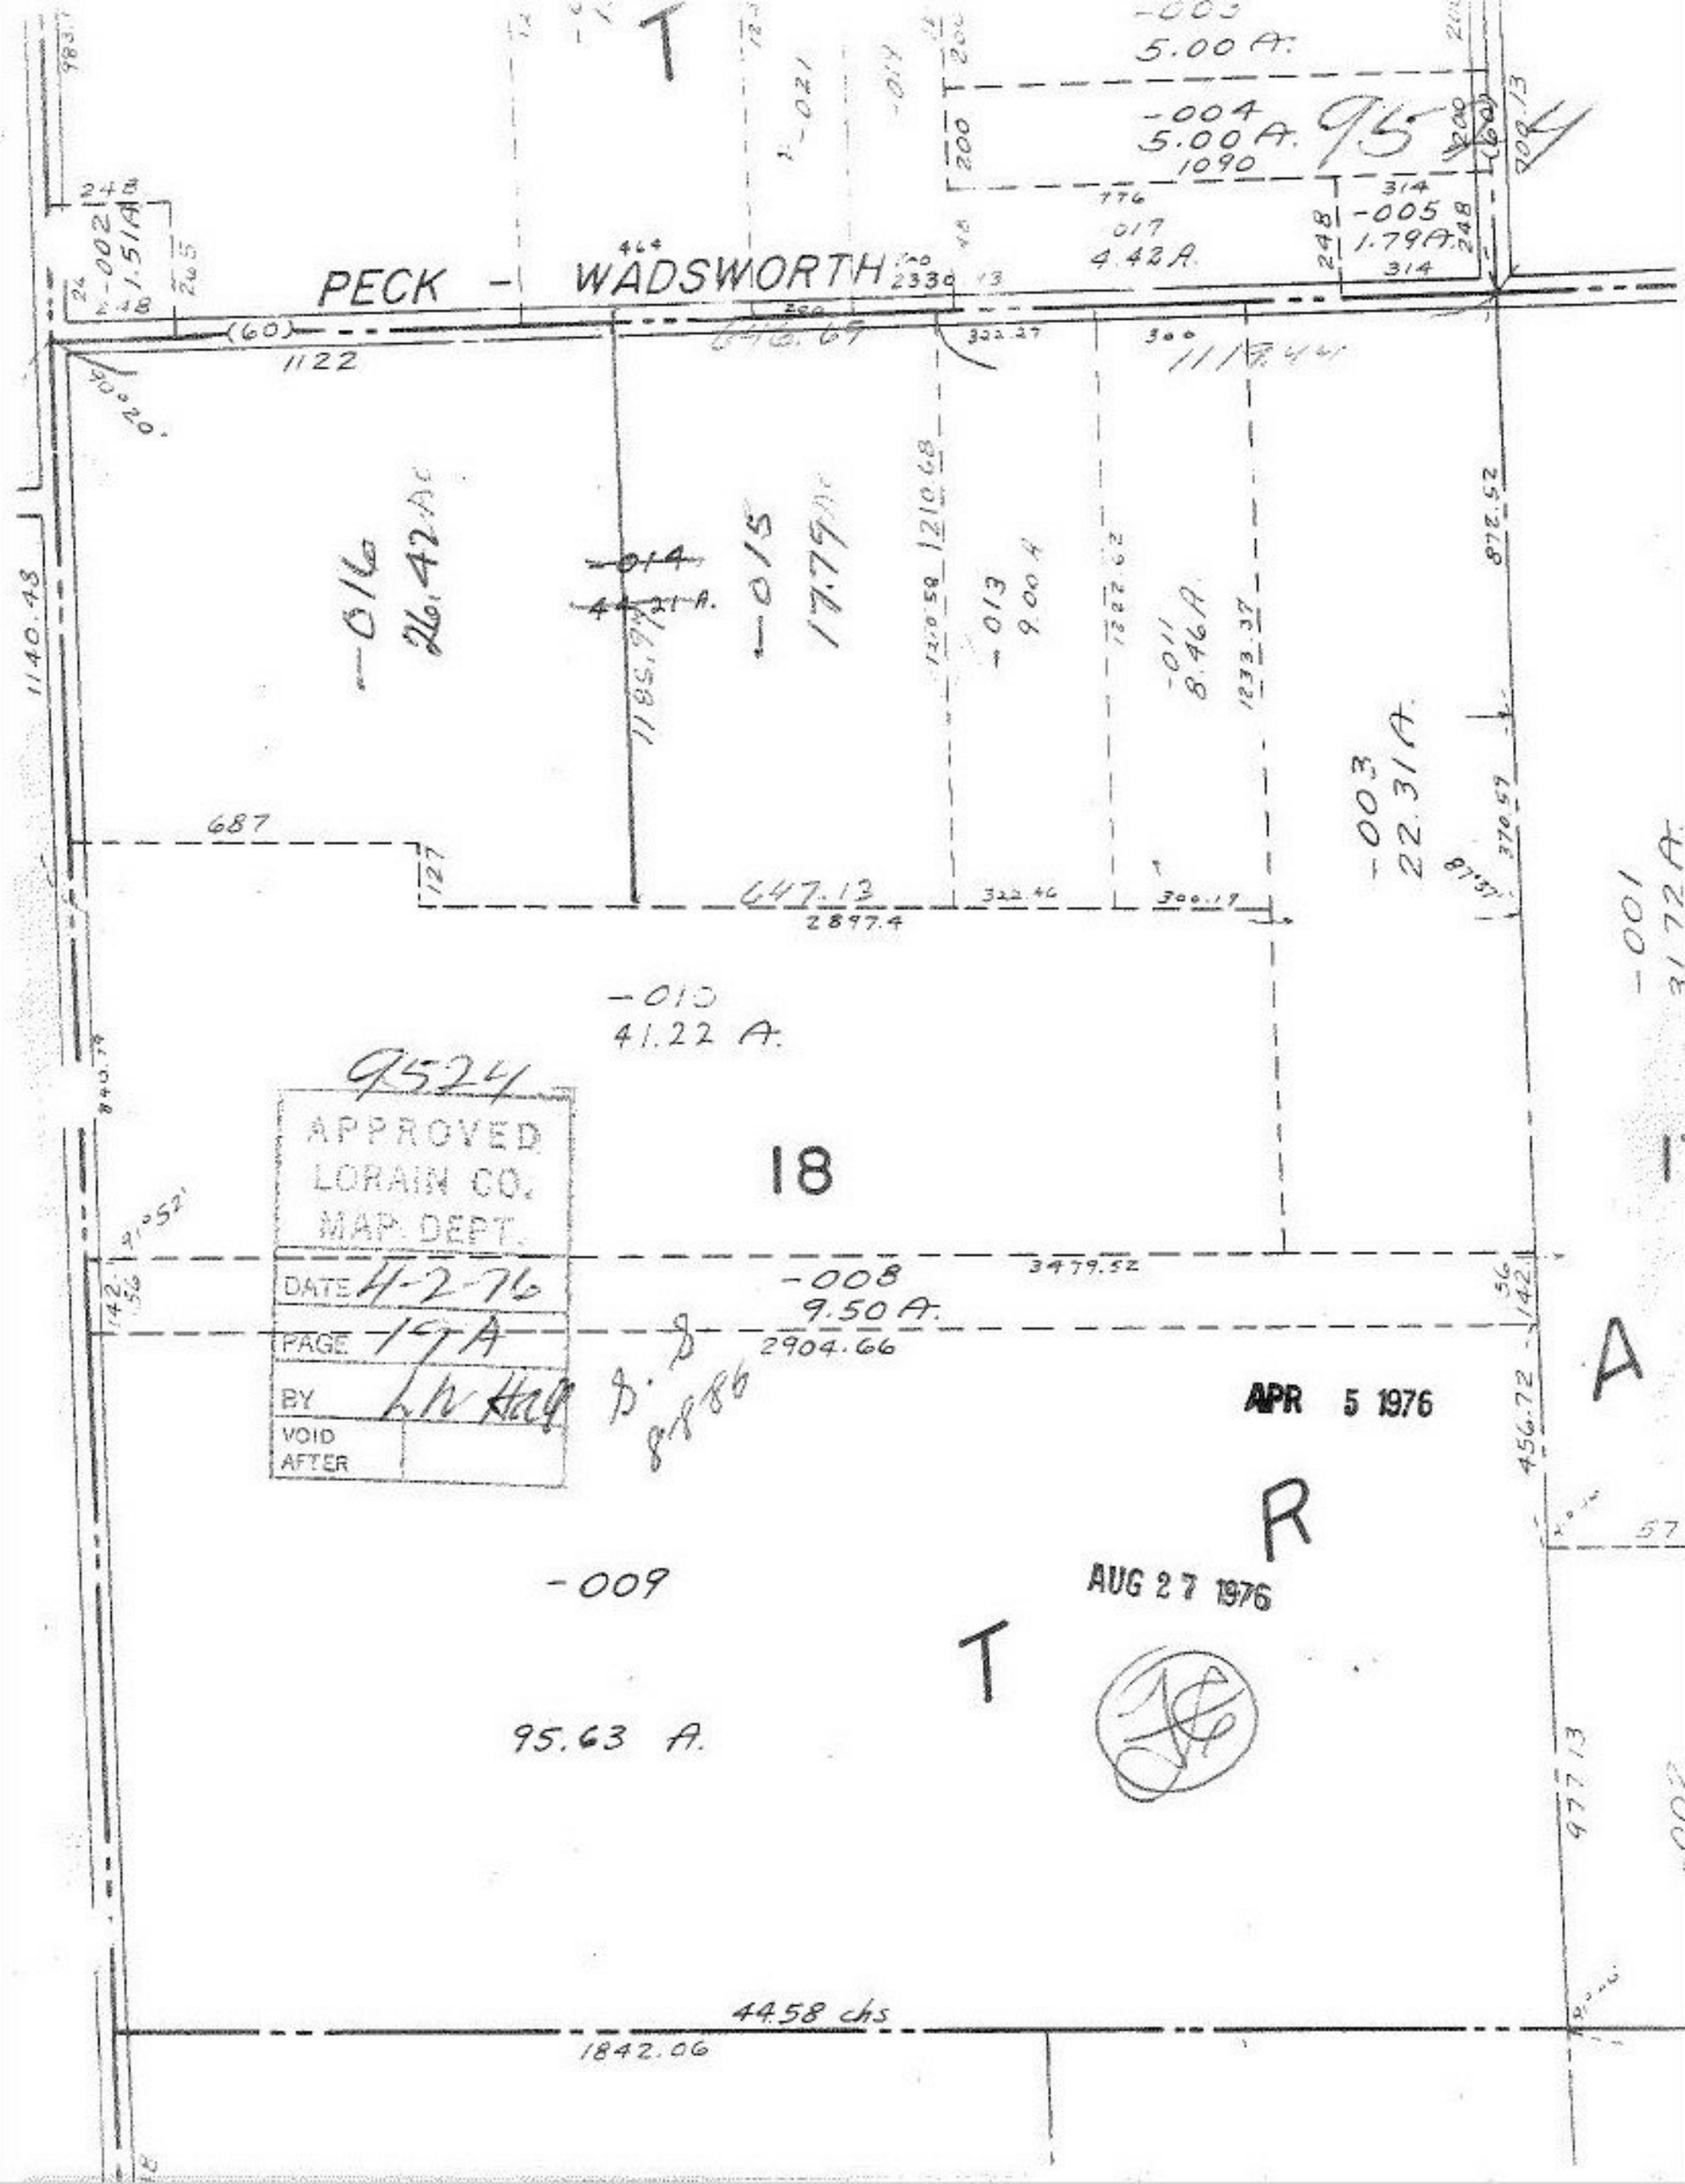

PECK - WADSWORTH
-003
5.00 A.
-004
5.00 A.
1090
95
-005
1.79 A.
-017
4.42 A.
-002
1.51 A.
-016
26.42 Ac
-014
44.21 A.
-015
17.79 Ac
-013
9.00 A
-011
8.46 A
-003
22.31 A.
-001
31.72 A.
-010
41.22 A.
18
-008
9.50 A.
-009
95.63 A.
T
R
A
APPROVED
LORAIN CO.
MAP DEPT.
DATE 4-2-76
PAGE 19A
BY LW Hall
VOID AFTER
APR 5 1976
AUG 27 1976