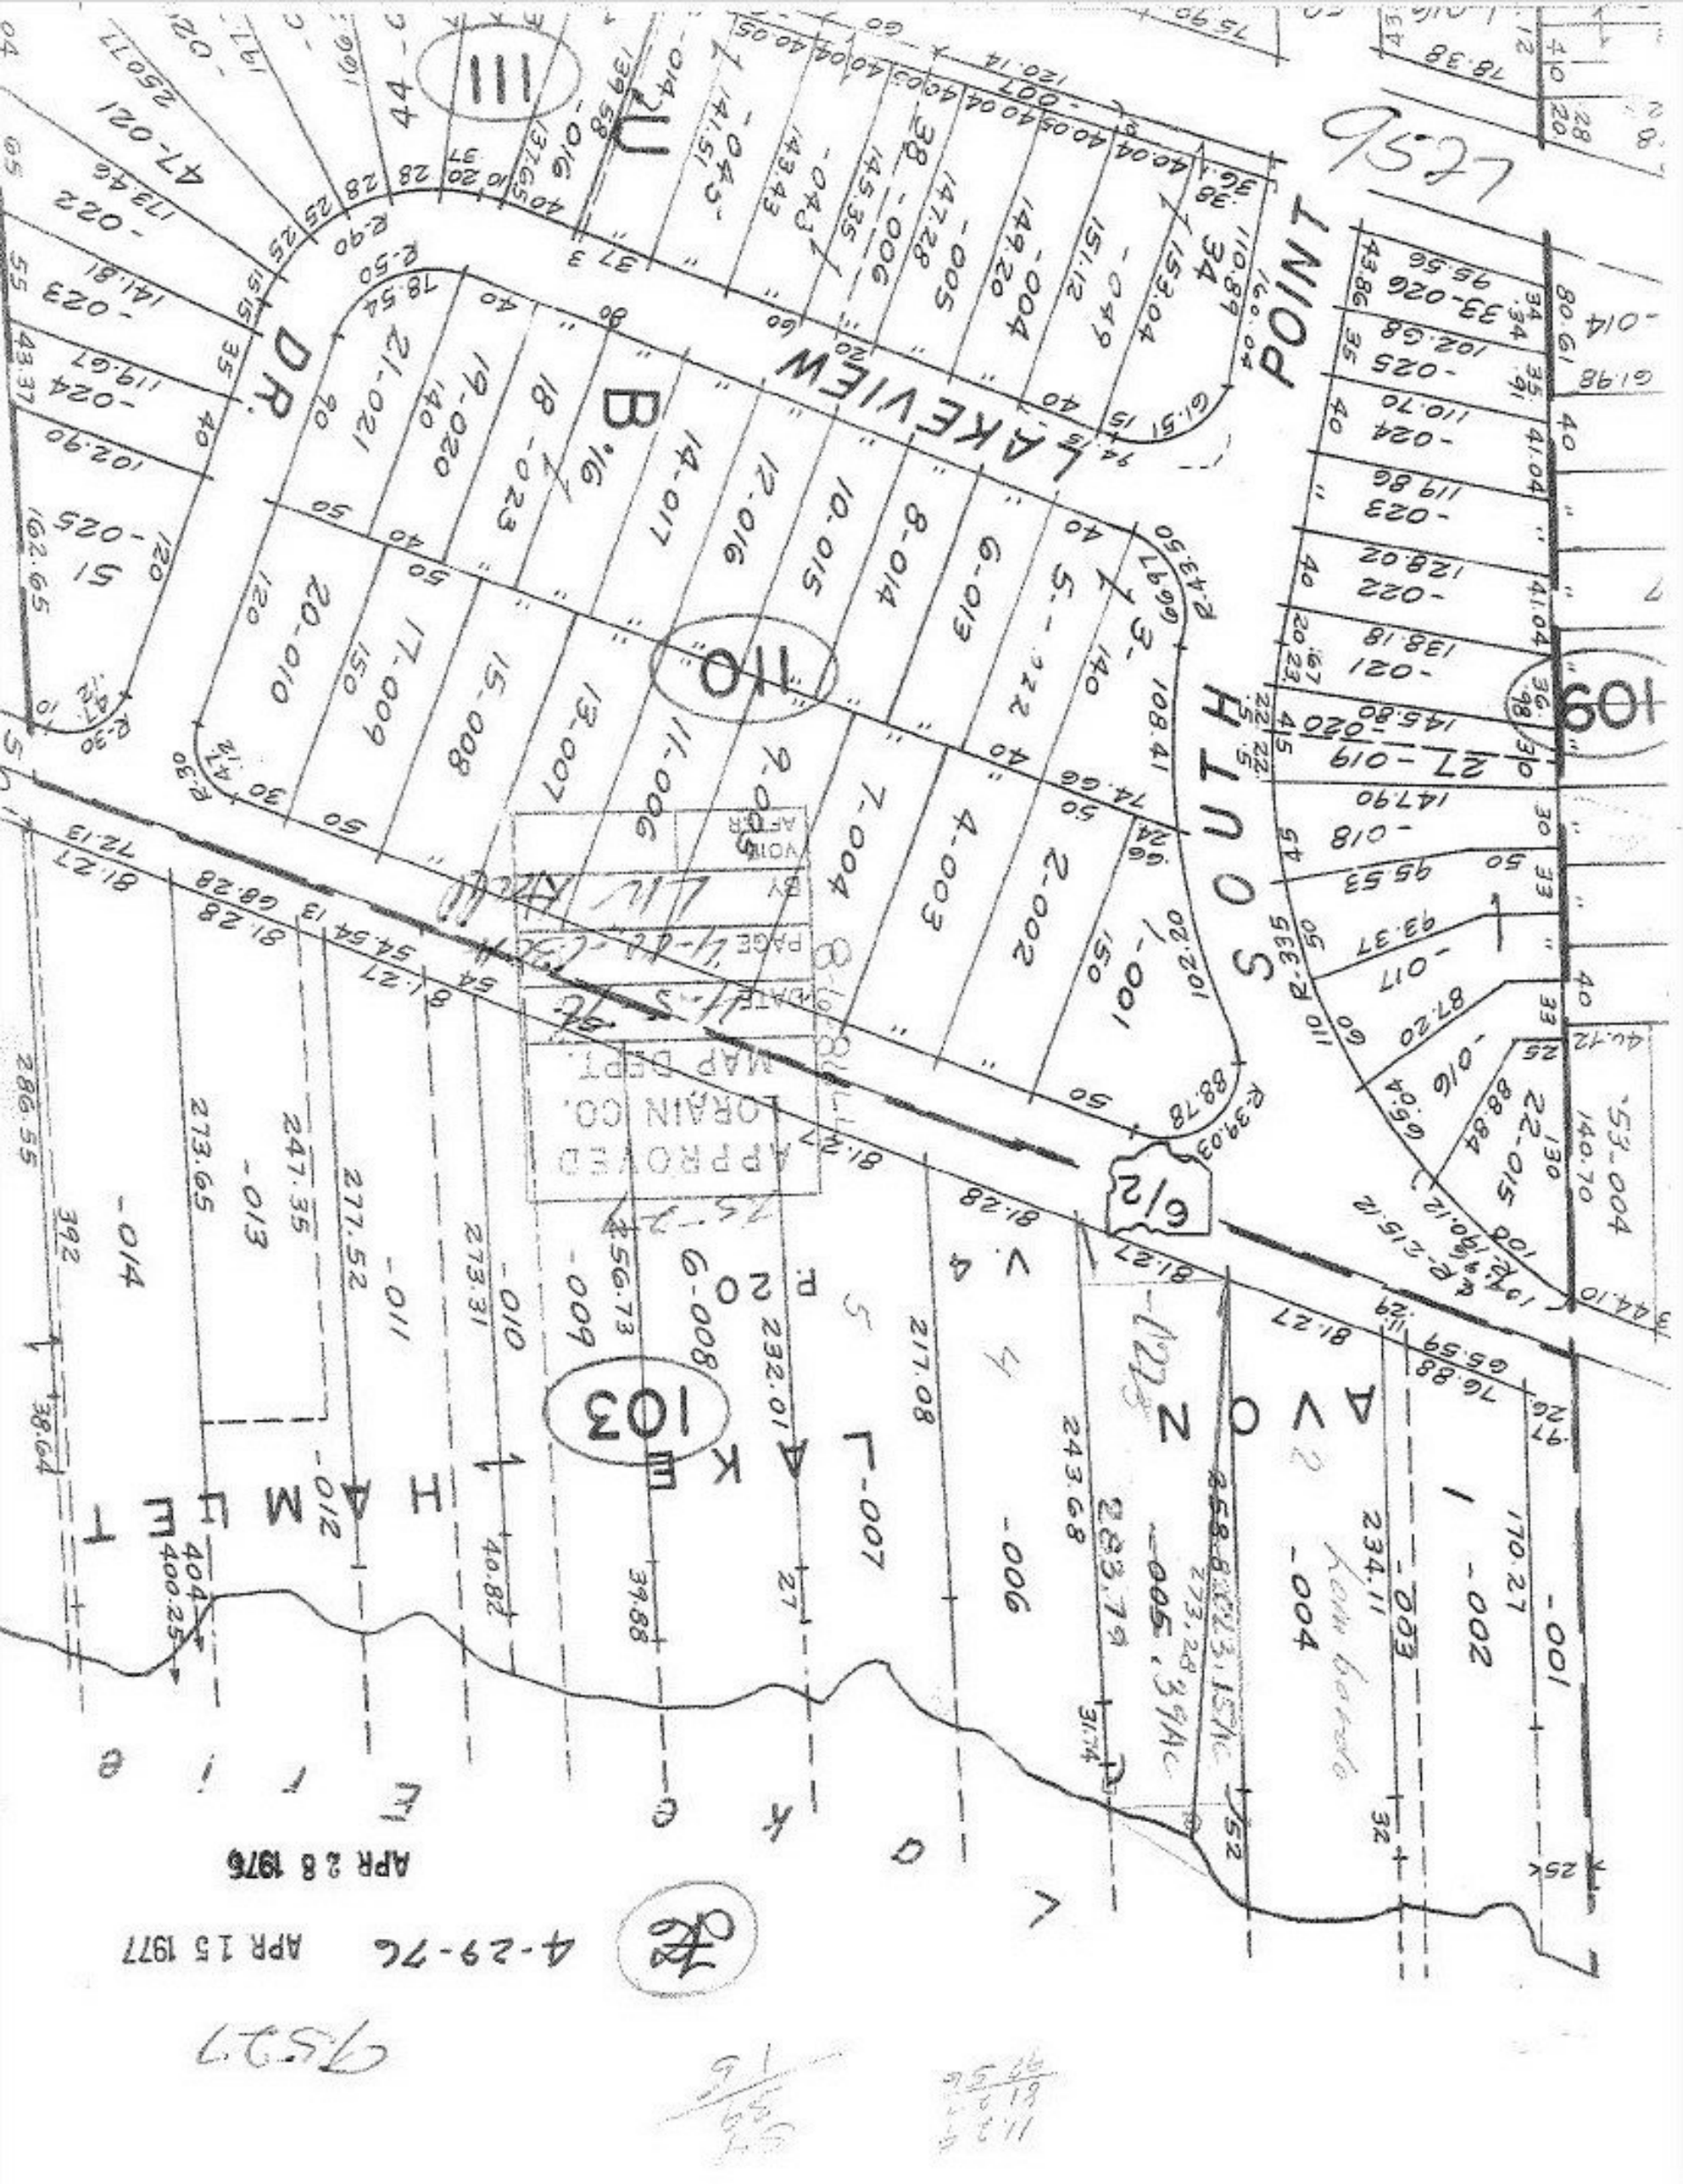
LAKEVIEW DR.
SOUTH POINT
BLVD.
110
111
109
103
6/2
9527
4-29-76
APR 15 1977
APR 28 1976
MAP DEPT.
ORAIN CO.
APPROVED
DATE
PAGE
BY
VOID AFTER