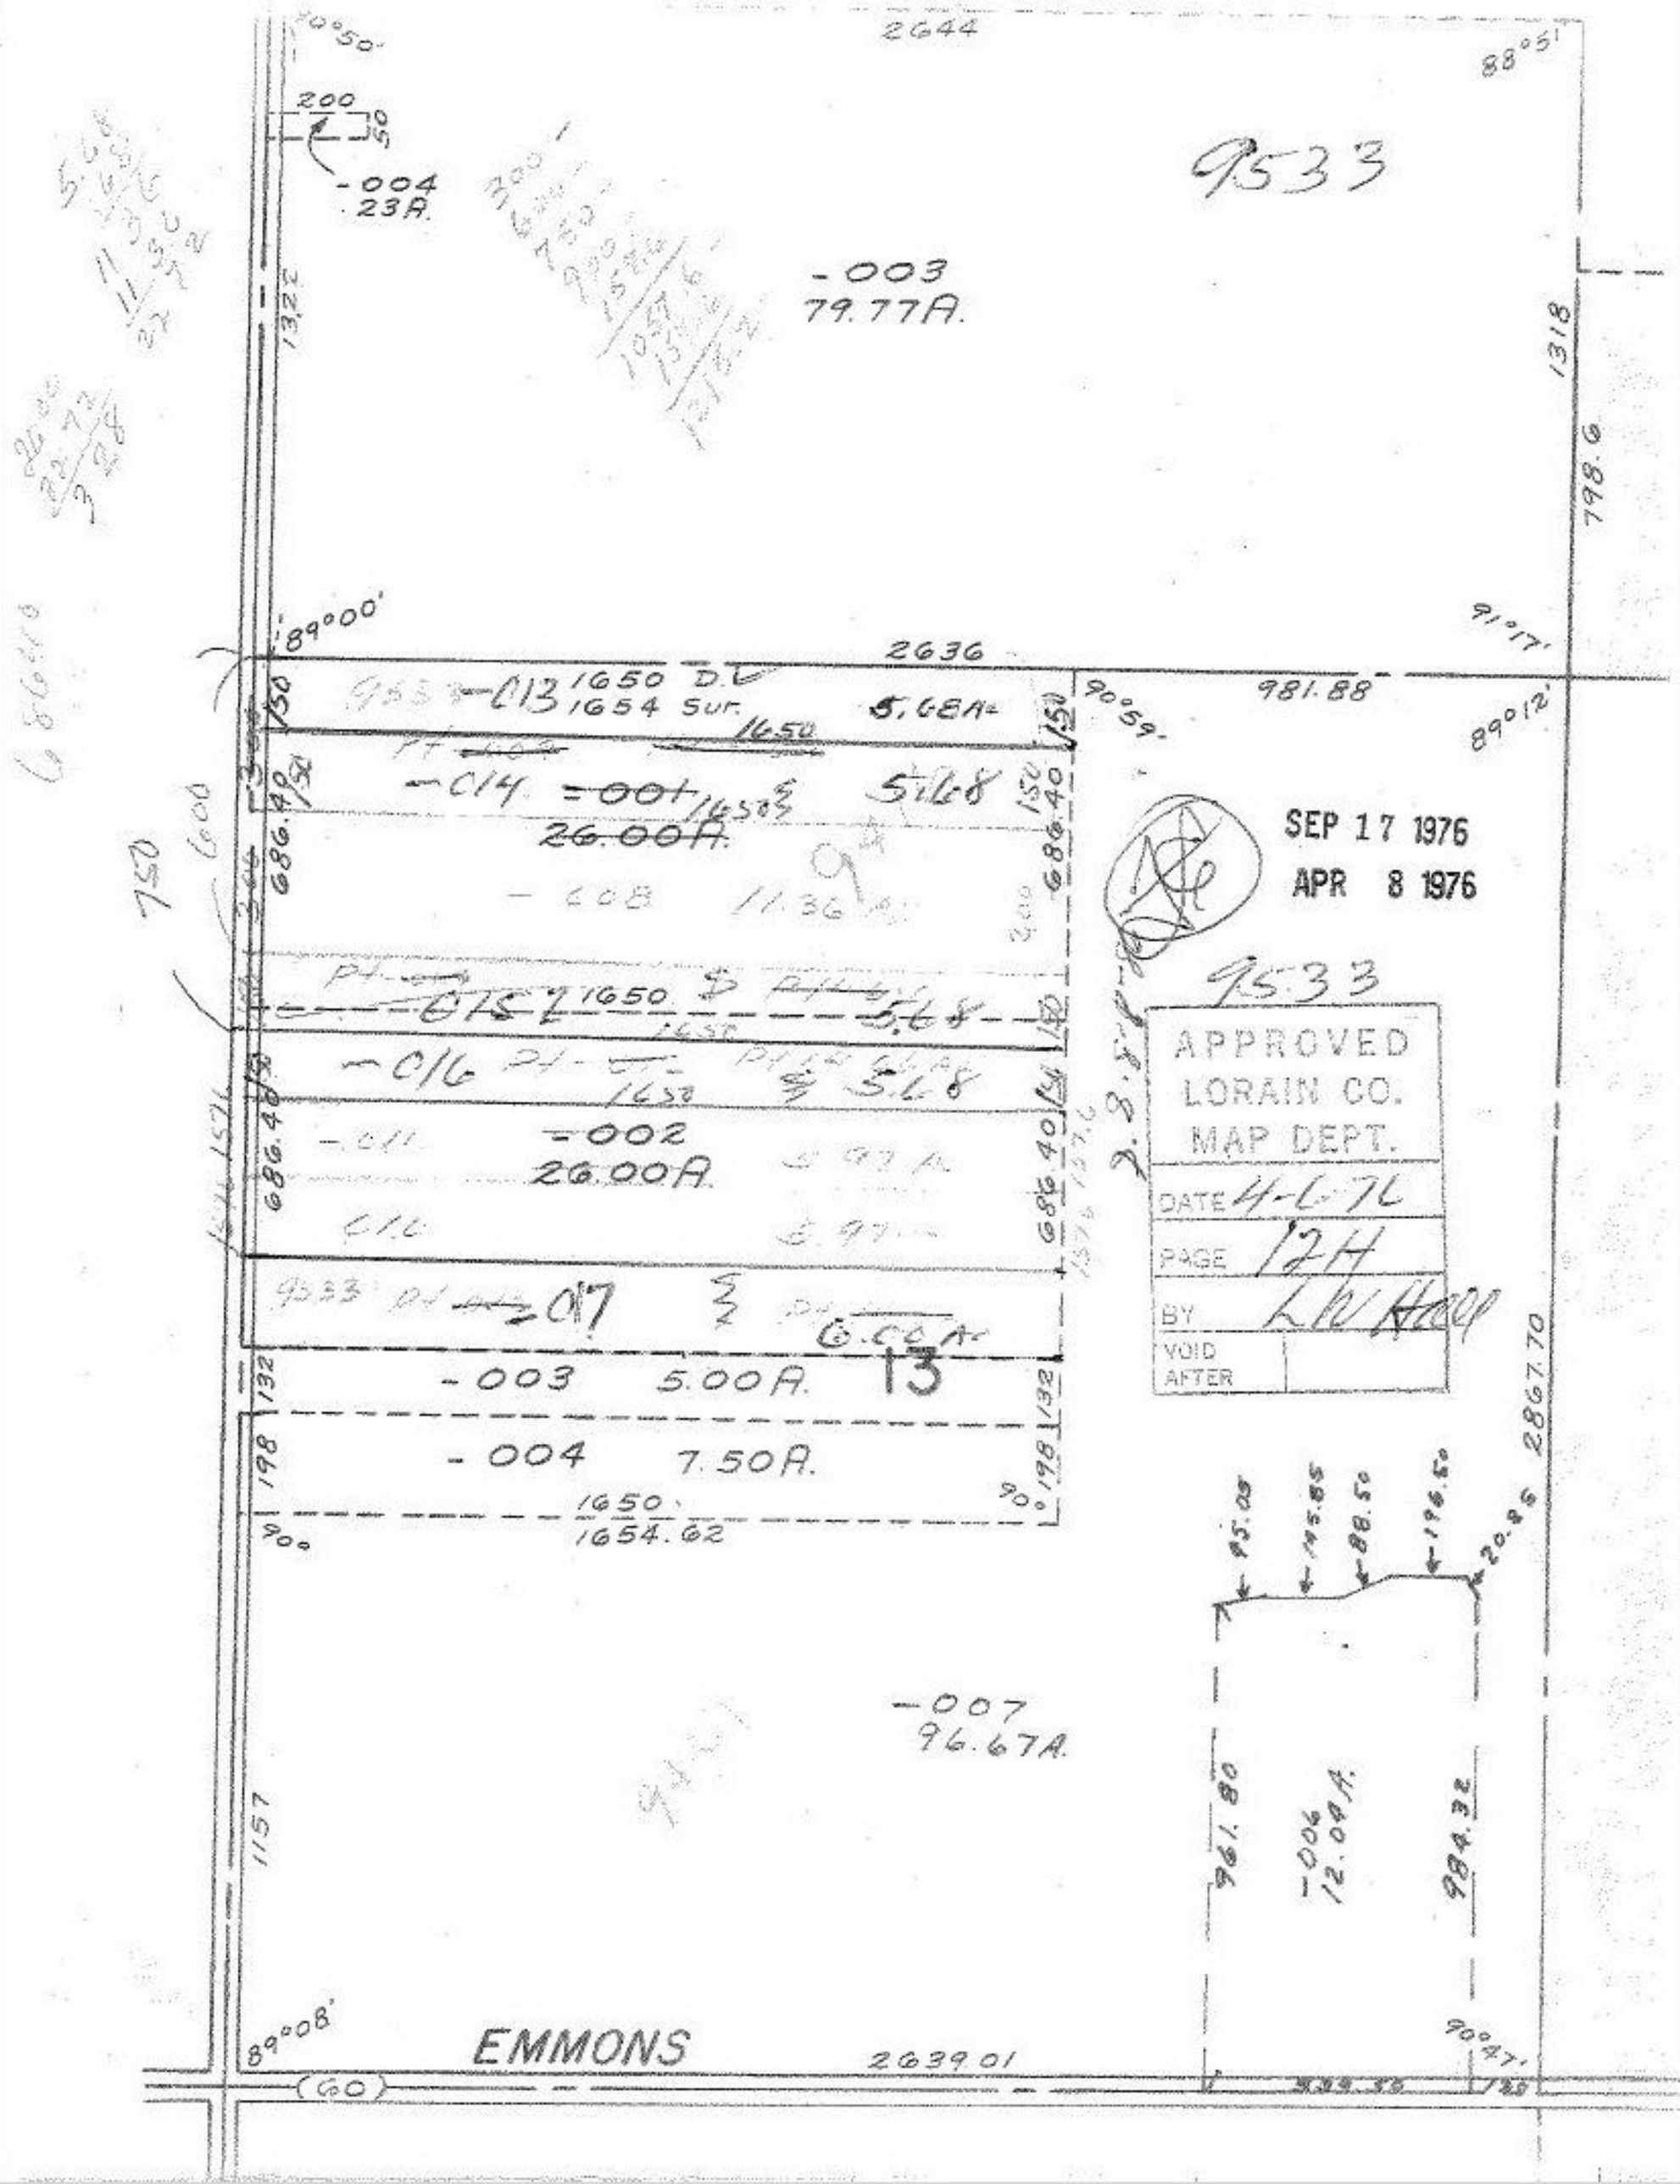

SEP 17 1976
APR 8 1976

APPROVED
LORAIN CO.
MAP DEPT.
DATE 4-6-76
PAGE 12H
BY LW Hall
VOID AFTER