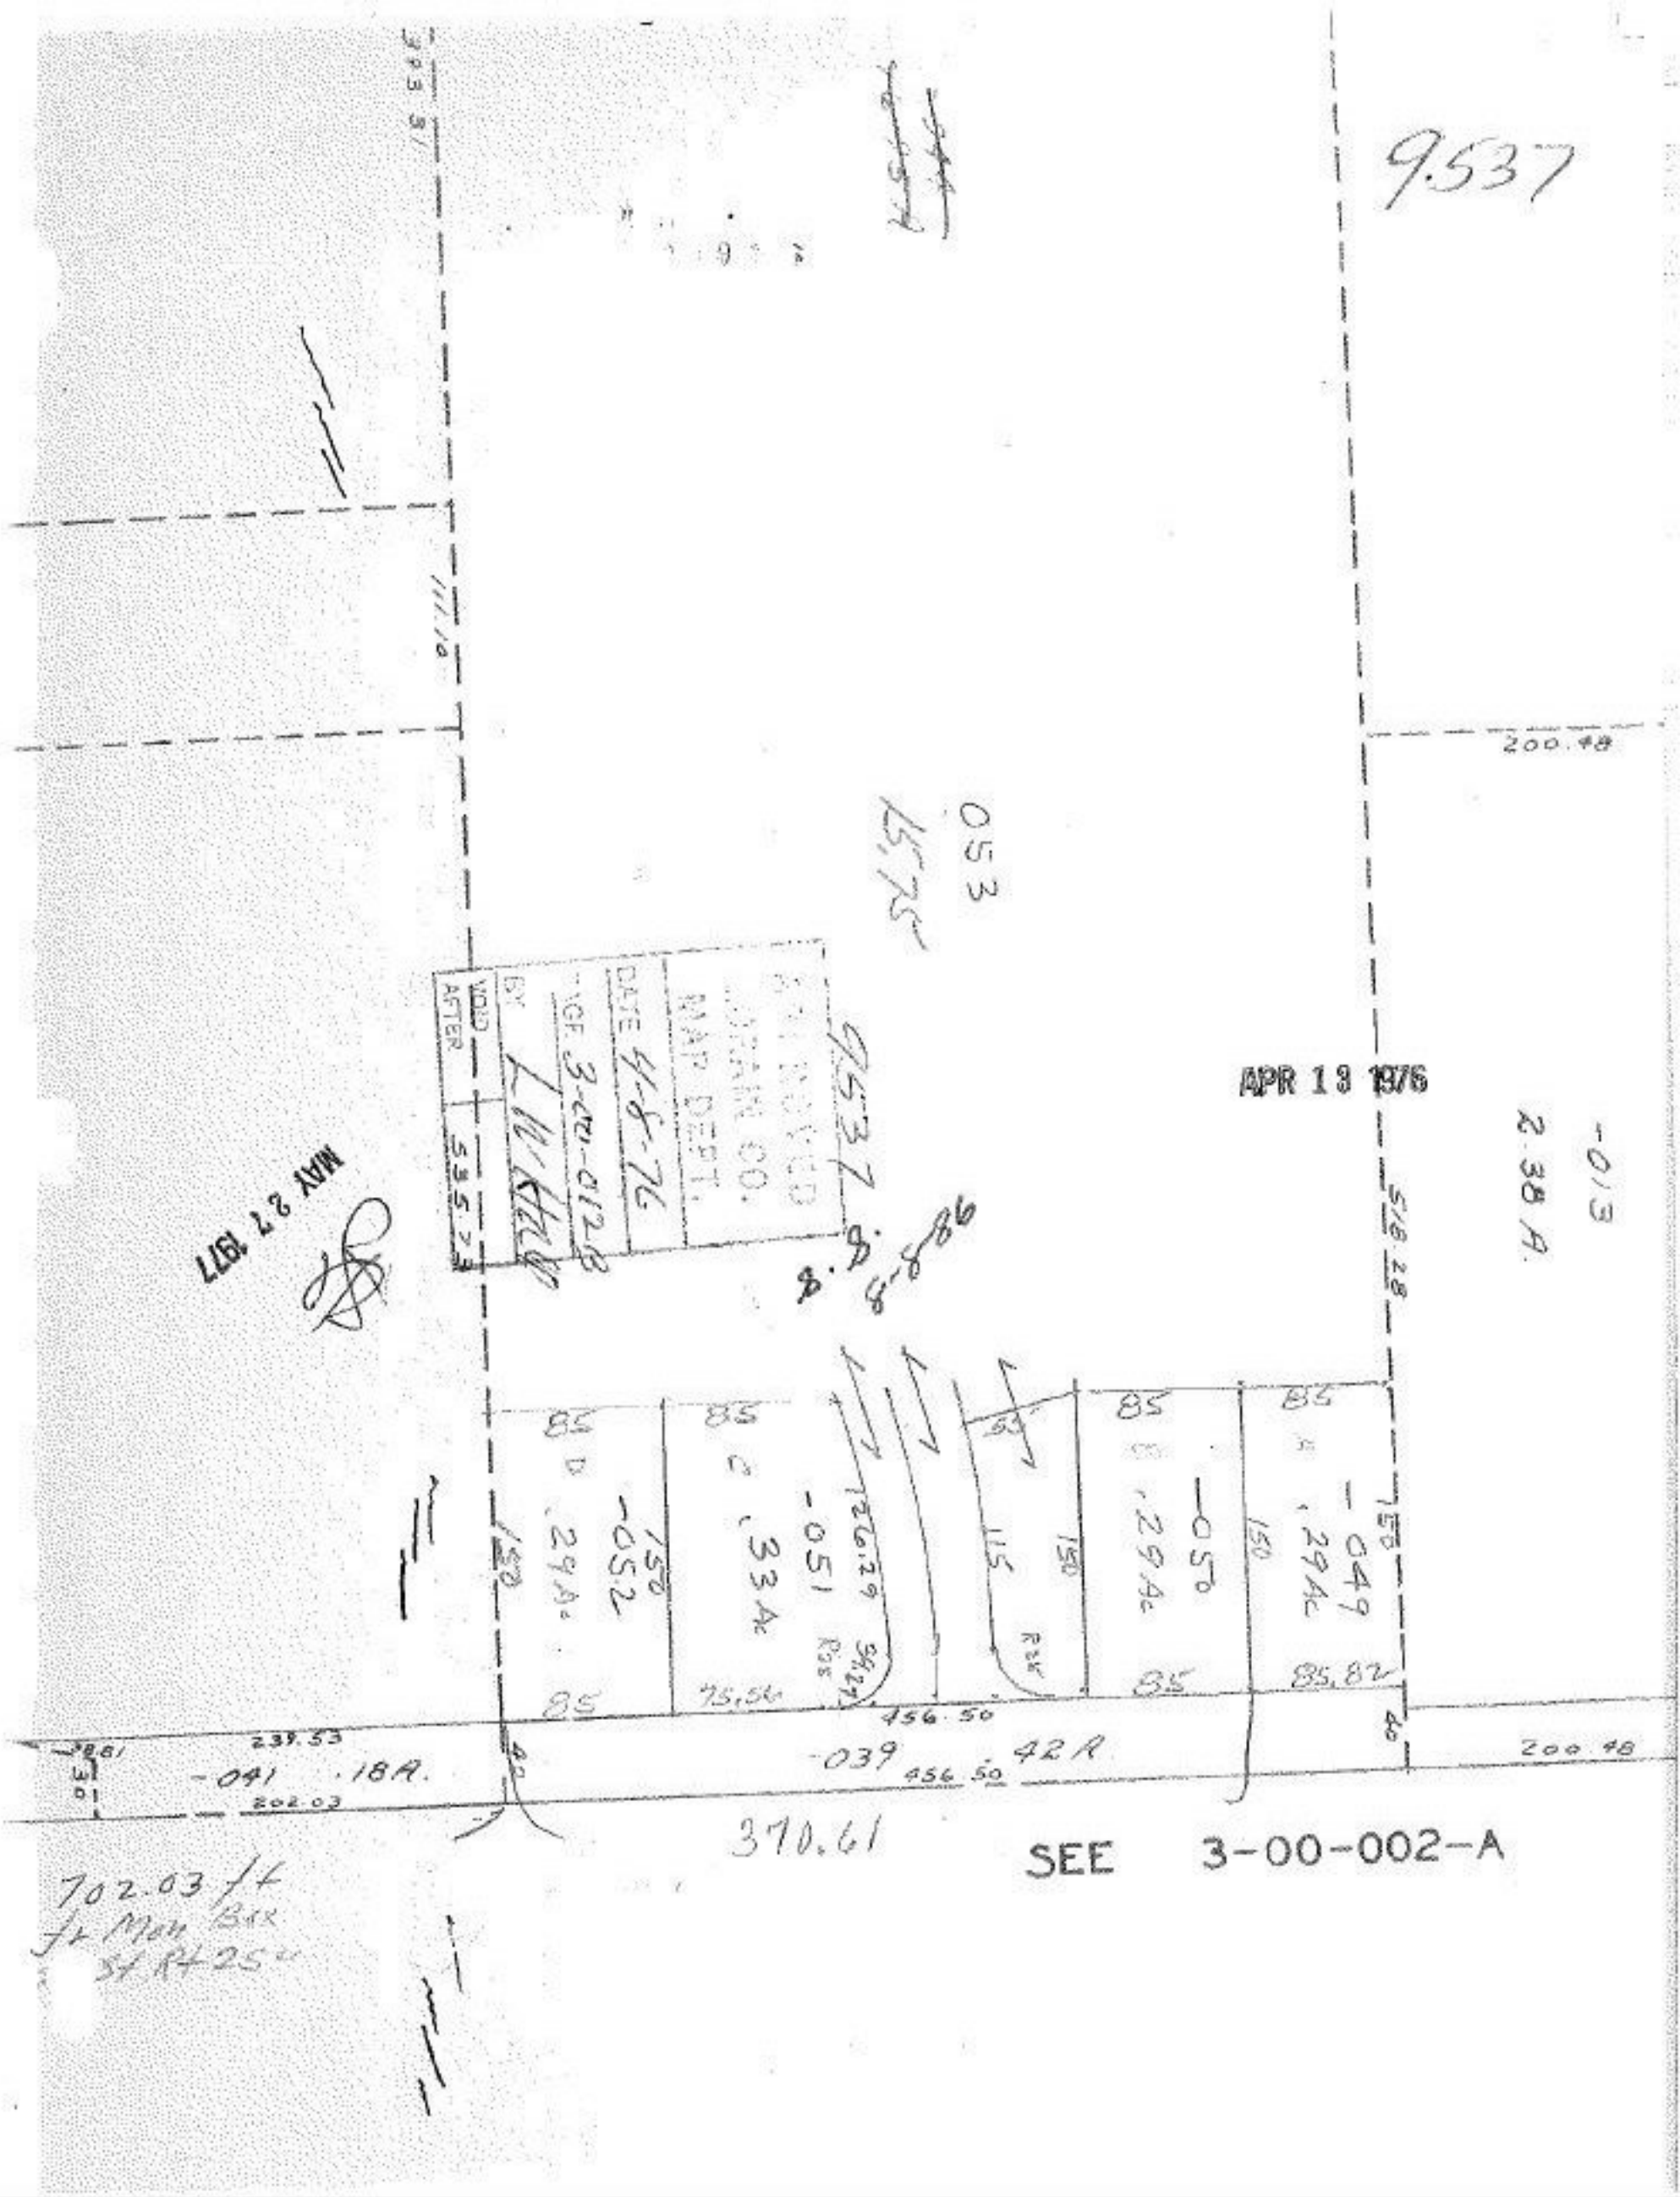

9.537
APR 13 1976
MAY 27 1977
-013
2.38 A.
200.48
518.28
-049
.29 Ac
-050
.29 Ac
-051
.33 Ac
-052
.29 Ac
85
85.82
456.50
-039
.42 A
239.53
-041
.18 A.
202.03
370.61
SEE 3-00-002-A
702.03 ft
ft Mon Box
St Rt 25