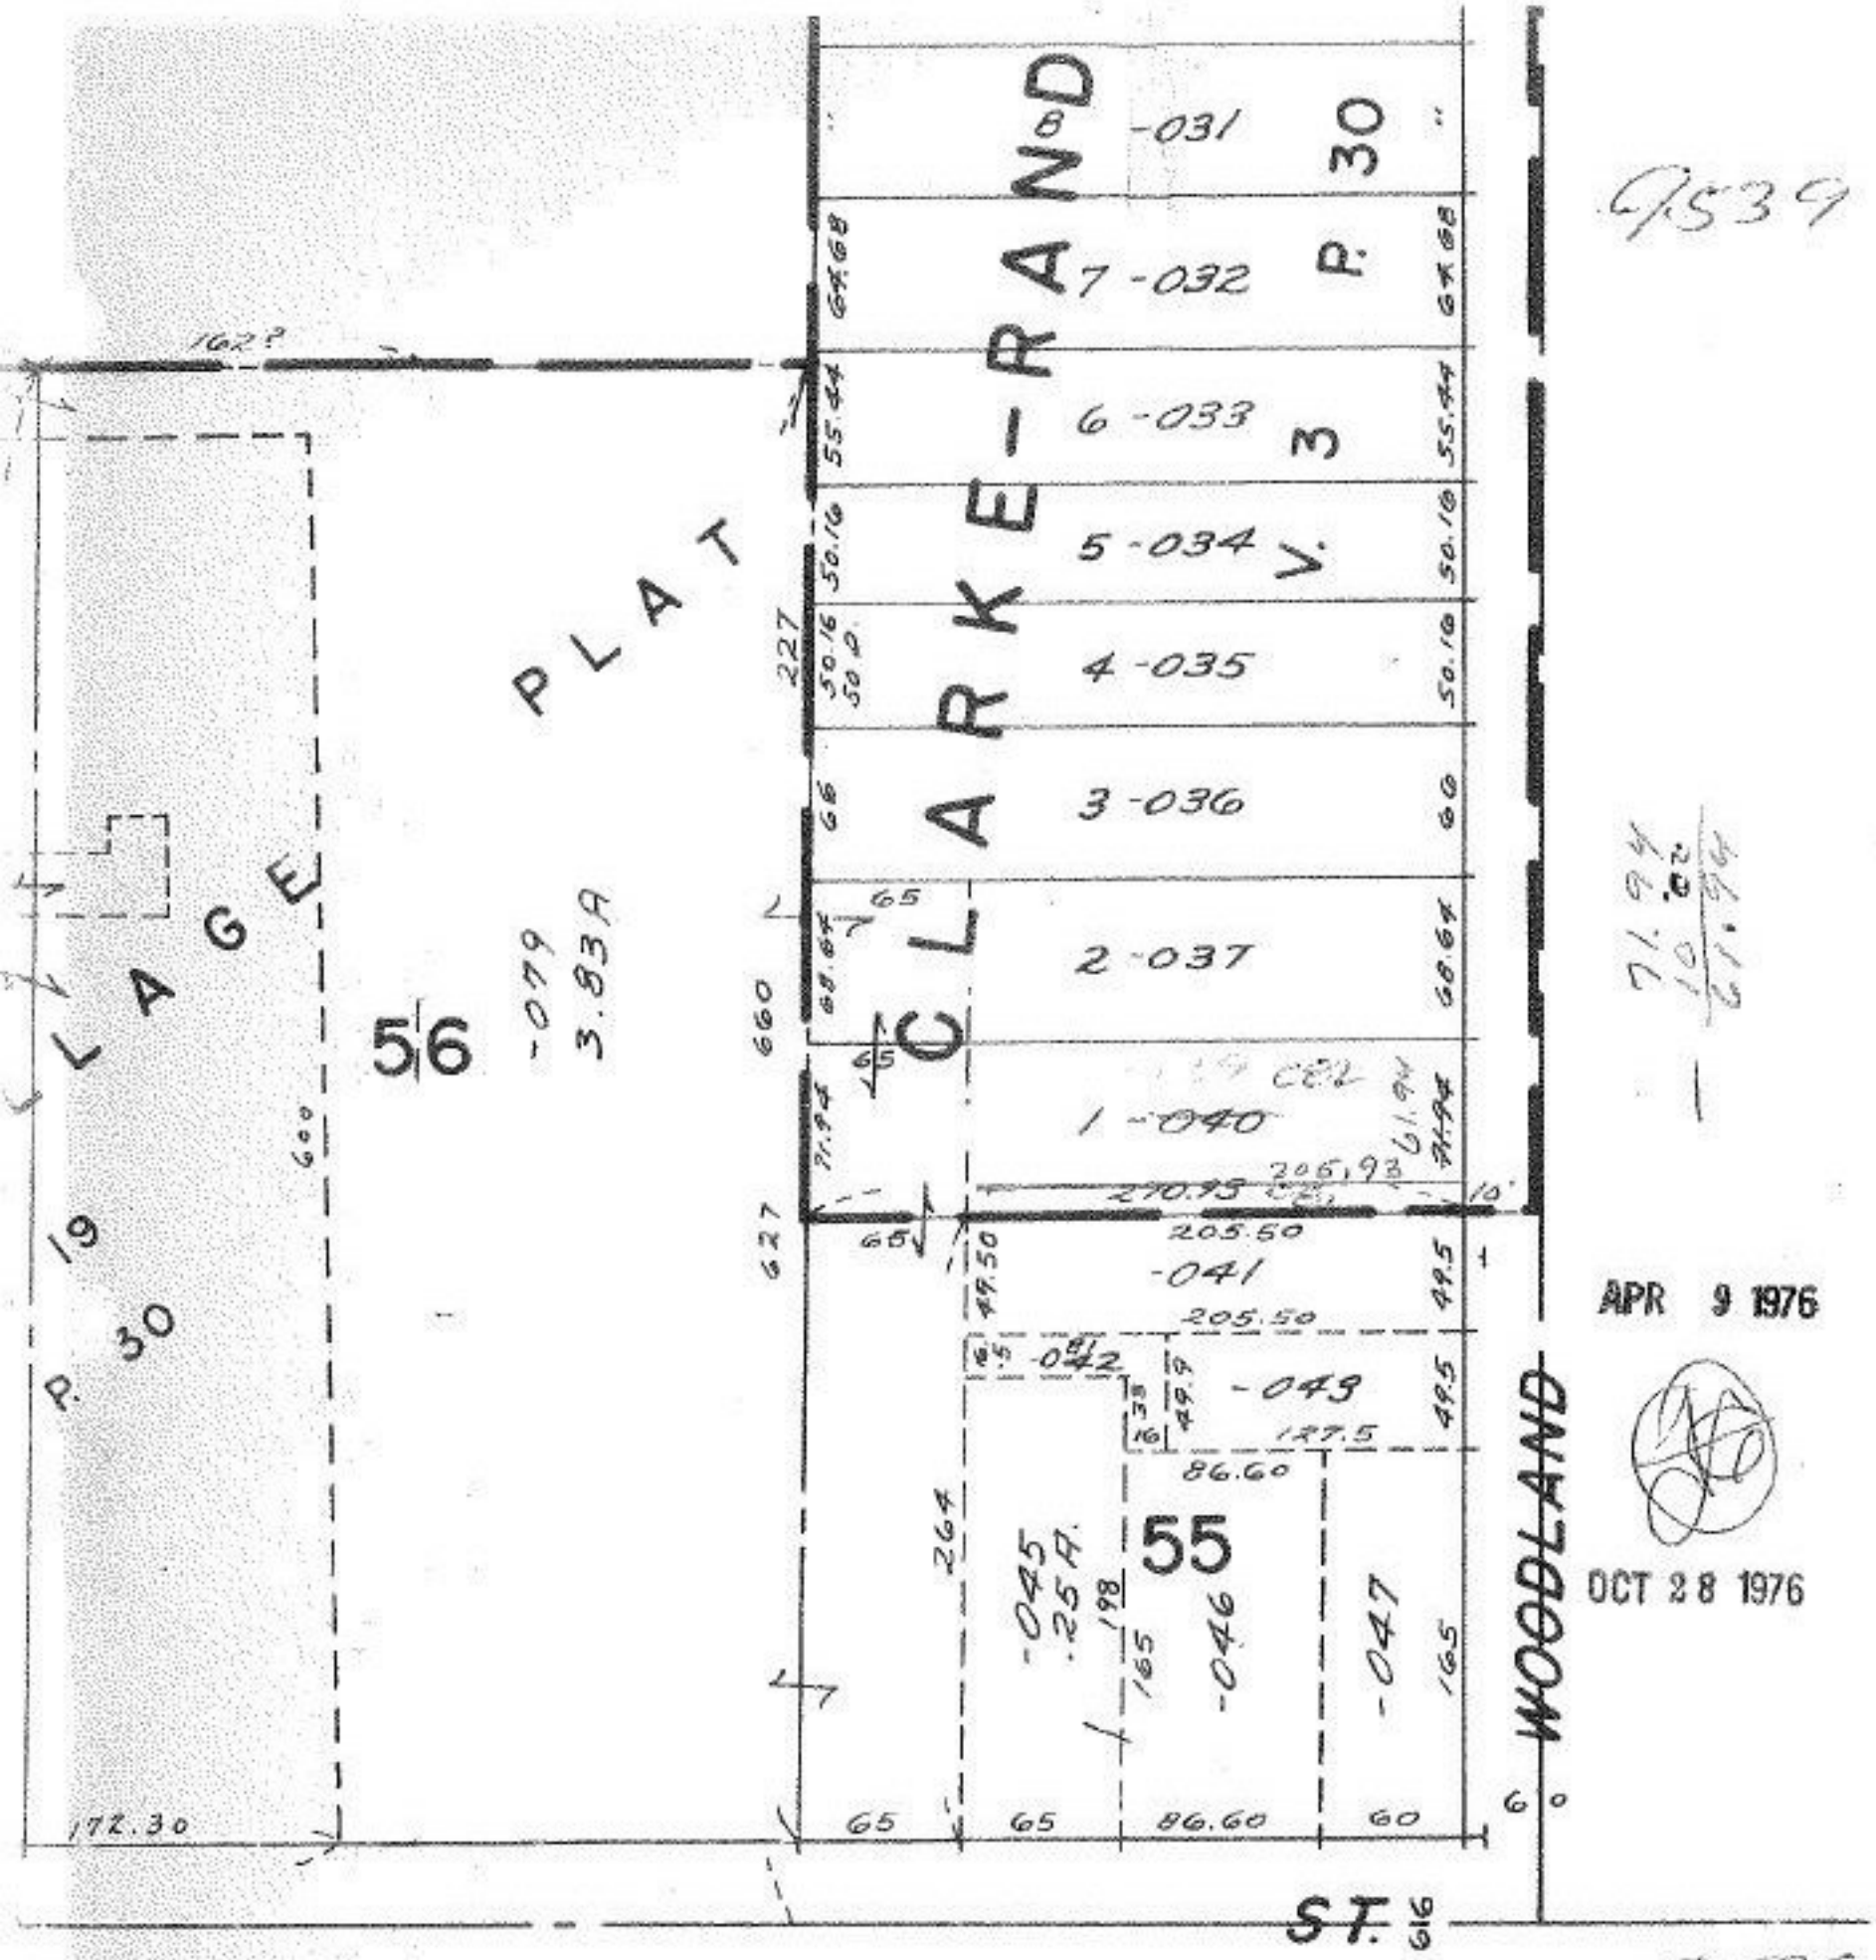

9539

APR 9 1976

OCT 28 1976

9539

270.93
65
205.93

APPROVED
LOCATION
MAP DEPT.
DATE 4-8-76
PAGE 9-00-075A
BY LW Hall
VOID AFTER

W PT. LOT 75