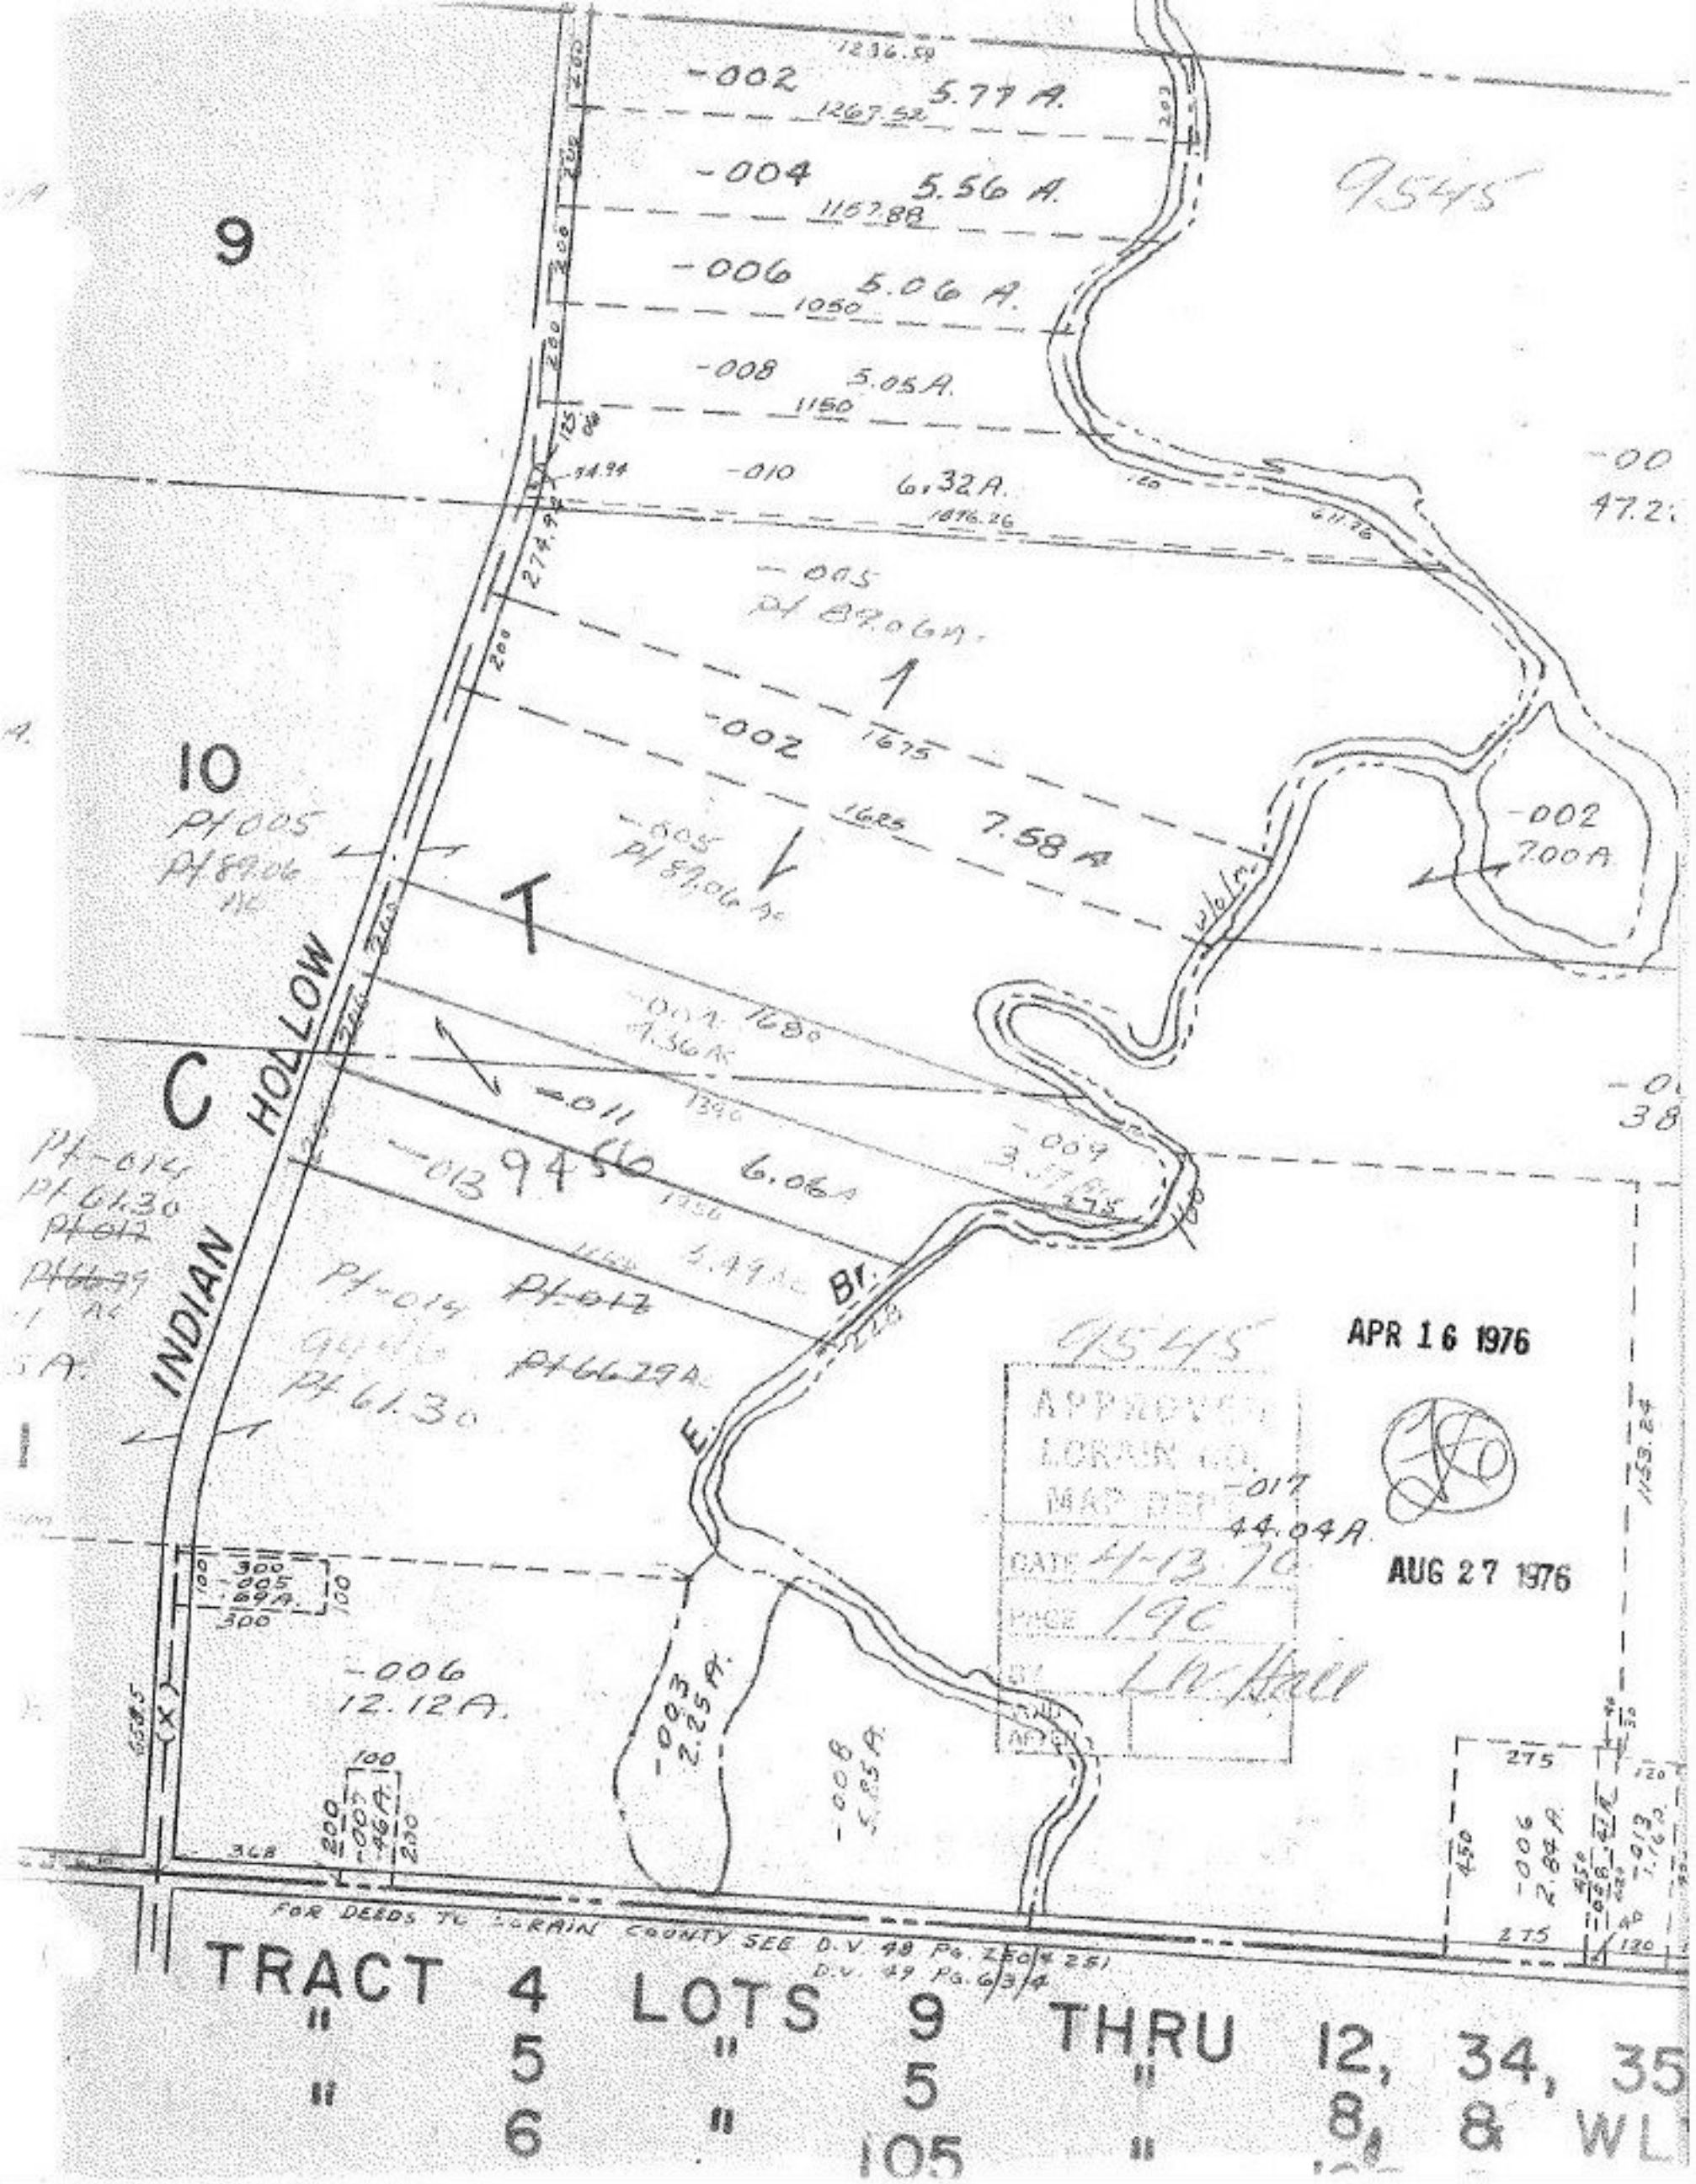

9
10
C
T
INDIAN HOLLOW
E. Br.
-002 5.77 A.
-004 5.56 A.
-006 5.06 A.
-008 5.05 A.
-010 6.32 A.
-005 Pt 89.06 A.
-002 7.58 A
-002 7.00 A
-011 6.06 A
-013 9456
-009 3.57 A
-017 44.04 A.
-006 12.12 A.
-003 2.25 A.
-008 5.85 A.
-006 2.84 A.
9545
APR 16 1976
AUG 27 1976
APPROVED LORAIN CO. MAP DEPT.
DATE 4-13-76
PAGE 196
BY L.W. Hall
FOR DEEDS TO LORAIN COUNTY SEE D.V. 48 Pg. 250 & 251
D.V. 49 Pg. 63/4
TRACT 4 LOTS 9 THRU 12, 34, 35
" 5 " 5 " 8, 8 WL
" 6 " 105 "