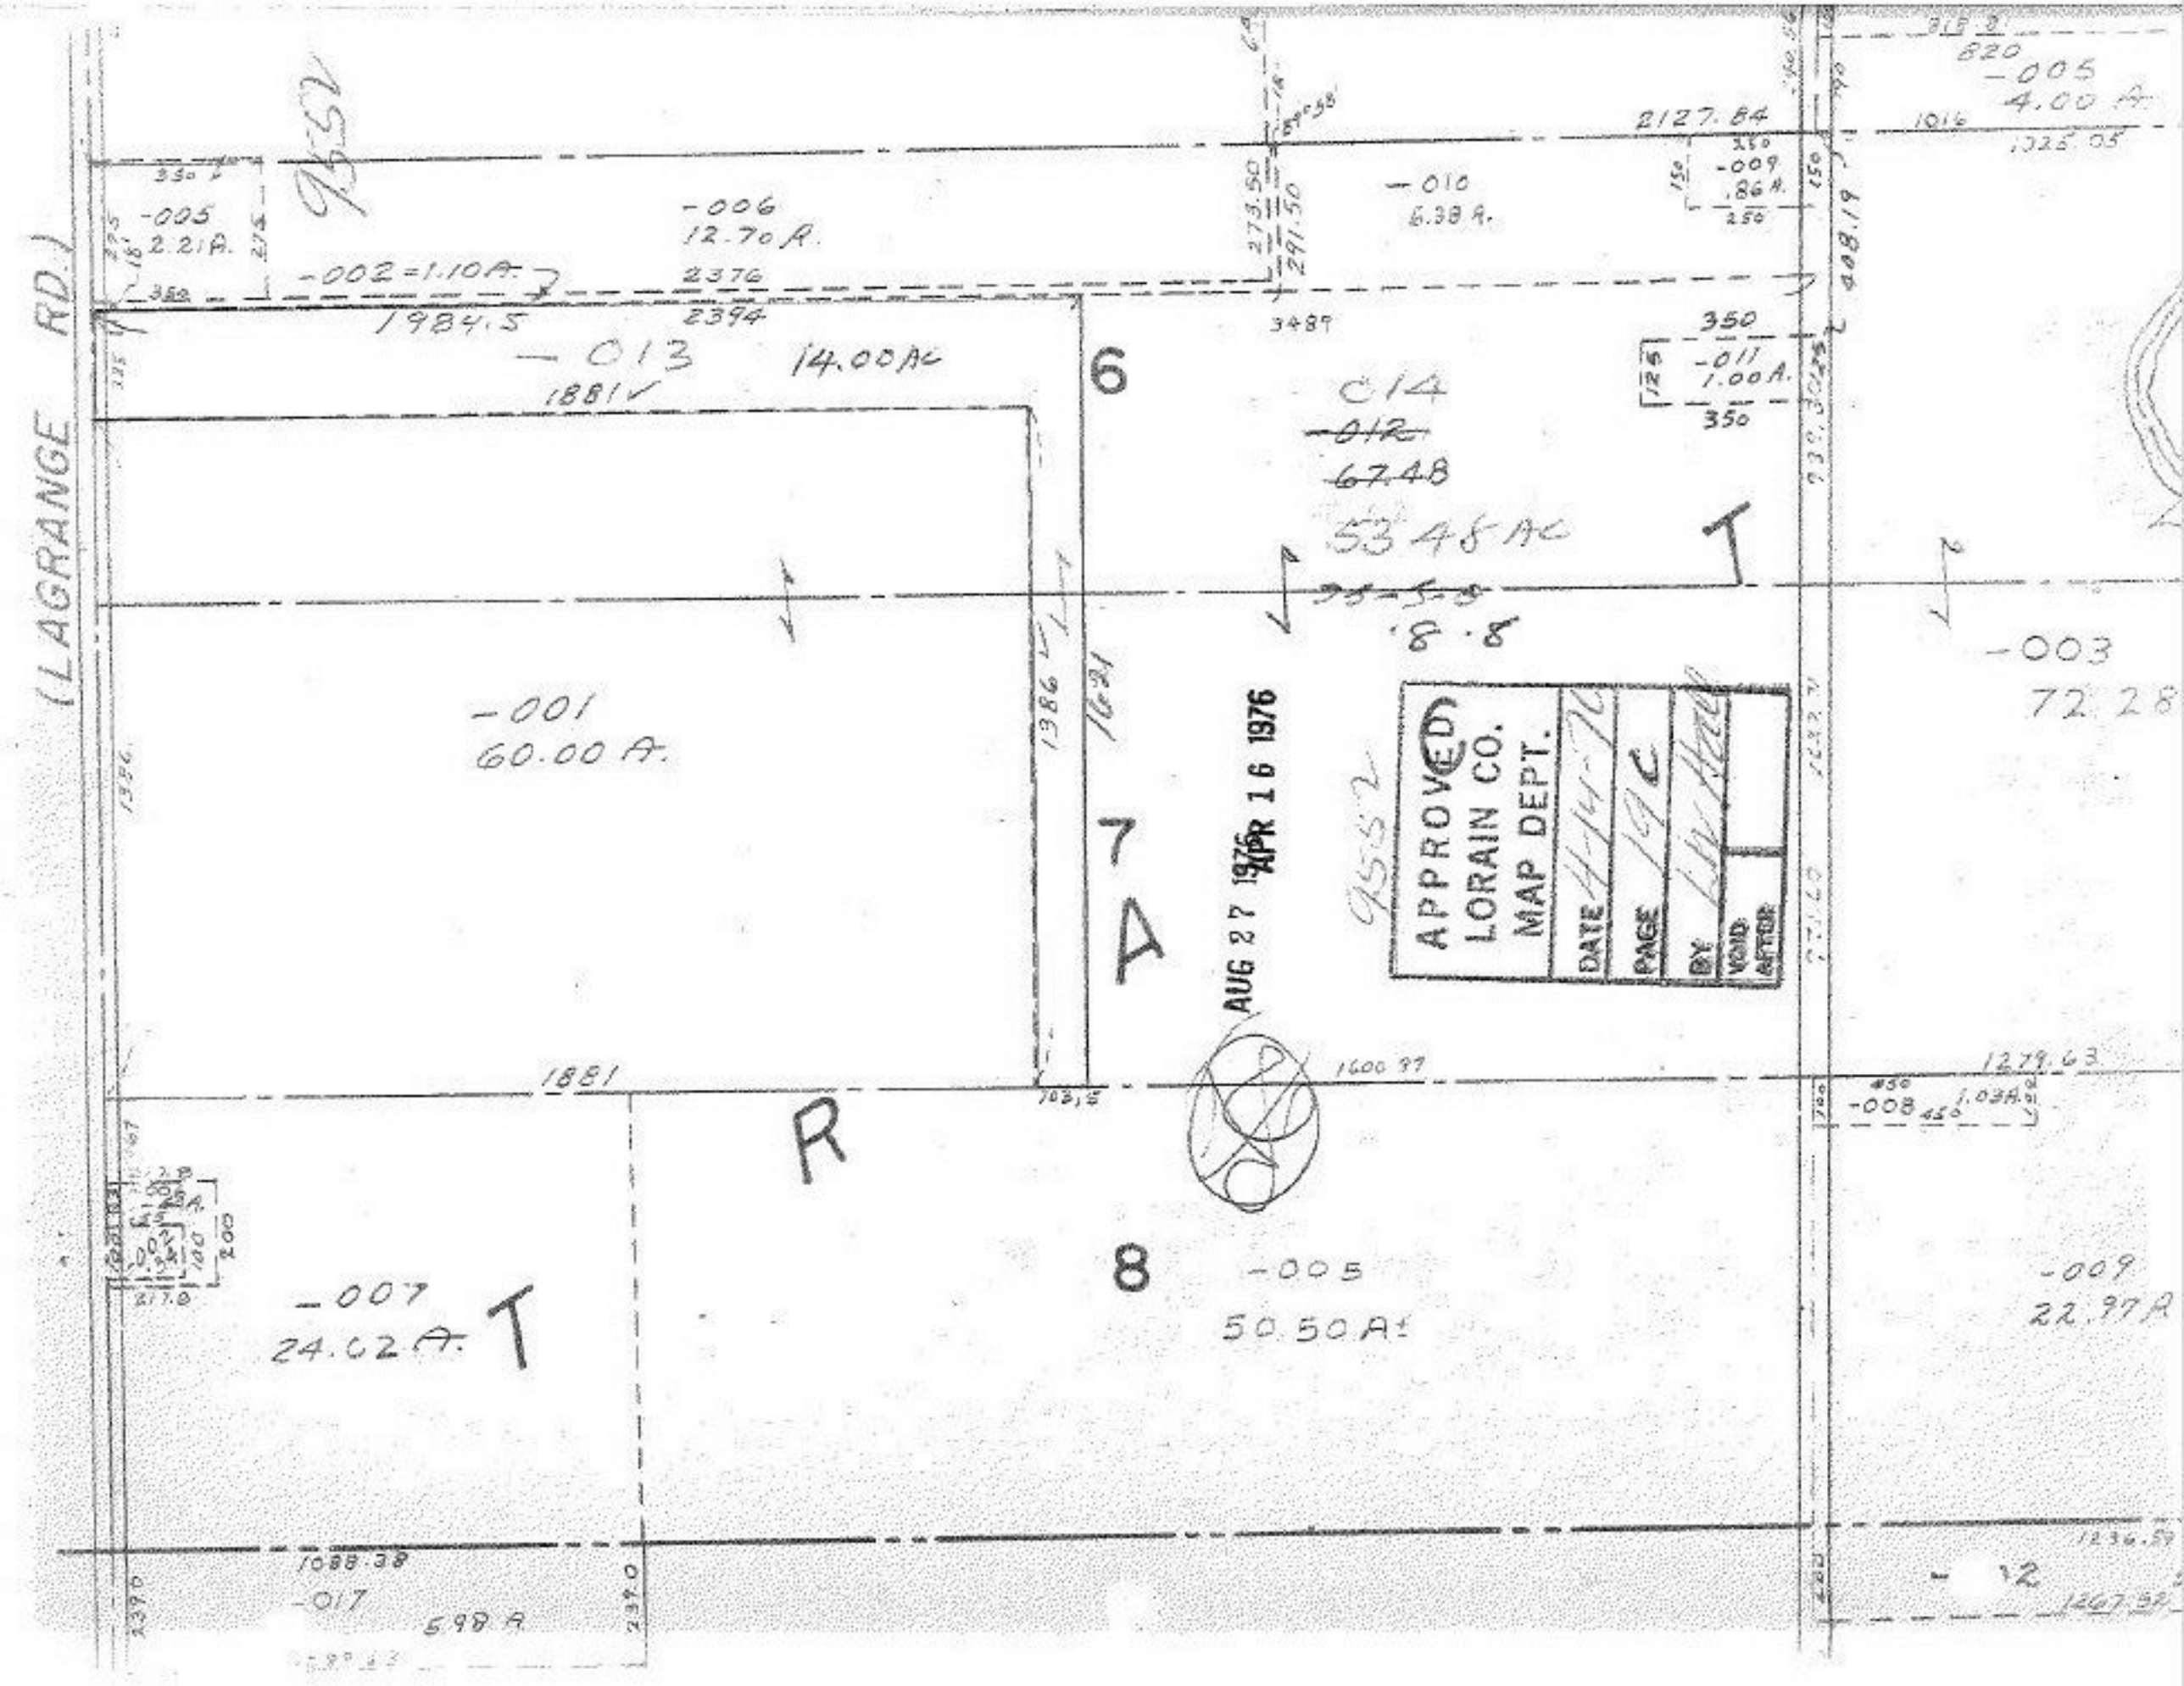

(LAGRANGE RD.)
9552
-005
2.21A.
-002=1.10A.
1984.5
-006
12.70A.
2376
2394
-013
14.00AC
1881
6
-010
6.38A.
2127.84
-009
.86A.
-005
4.00A.
1016
1025.05
-011
1.00A.
350
-014
-012
67.48
53.48AC
.8.8
-001
60.00A.
1386
1621
7
A
R
T
8
-005
50.50A±
-007
24.02A.
-003
72.28
-009
22.97A
1279.63
-008
1.03A.
1600.97
1881
1088.38
-017
5.98A.
-12
1267.52
1236.59
APPROVED
LORAIN CO.
MAP DEPT.
DATE
PAGE
BY
VOID AFTER
AUG 27 1976
APR 16 1976