9563

9-610-0

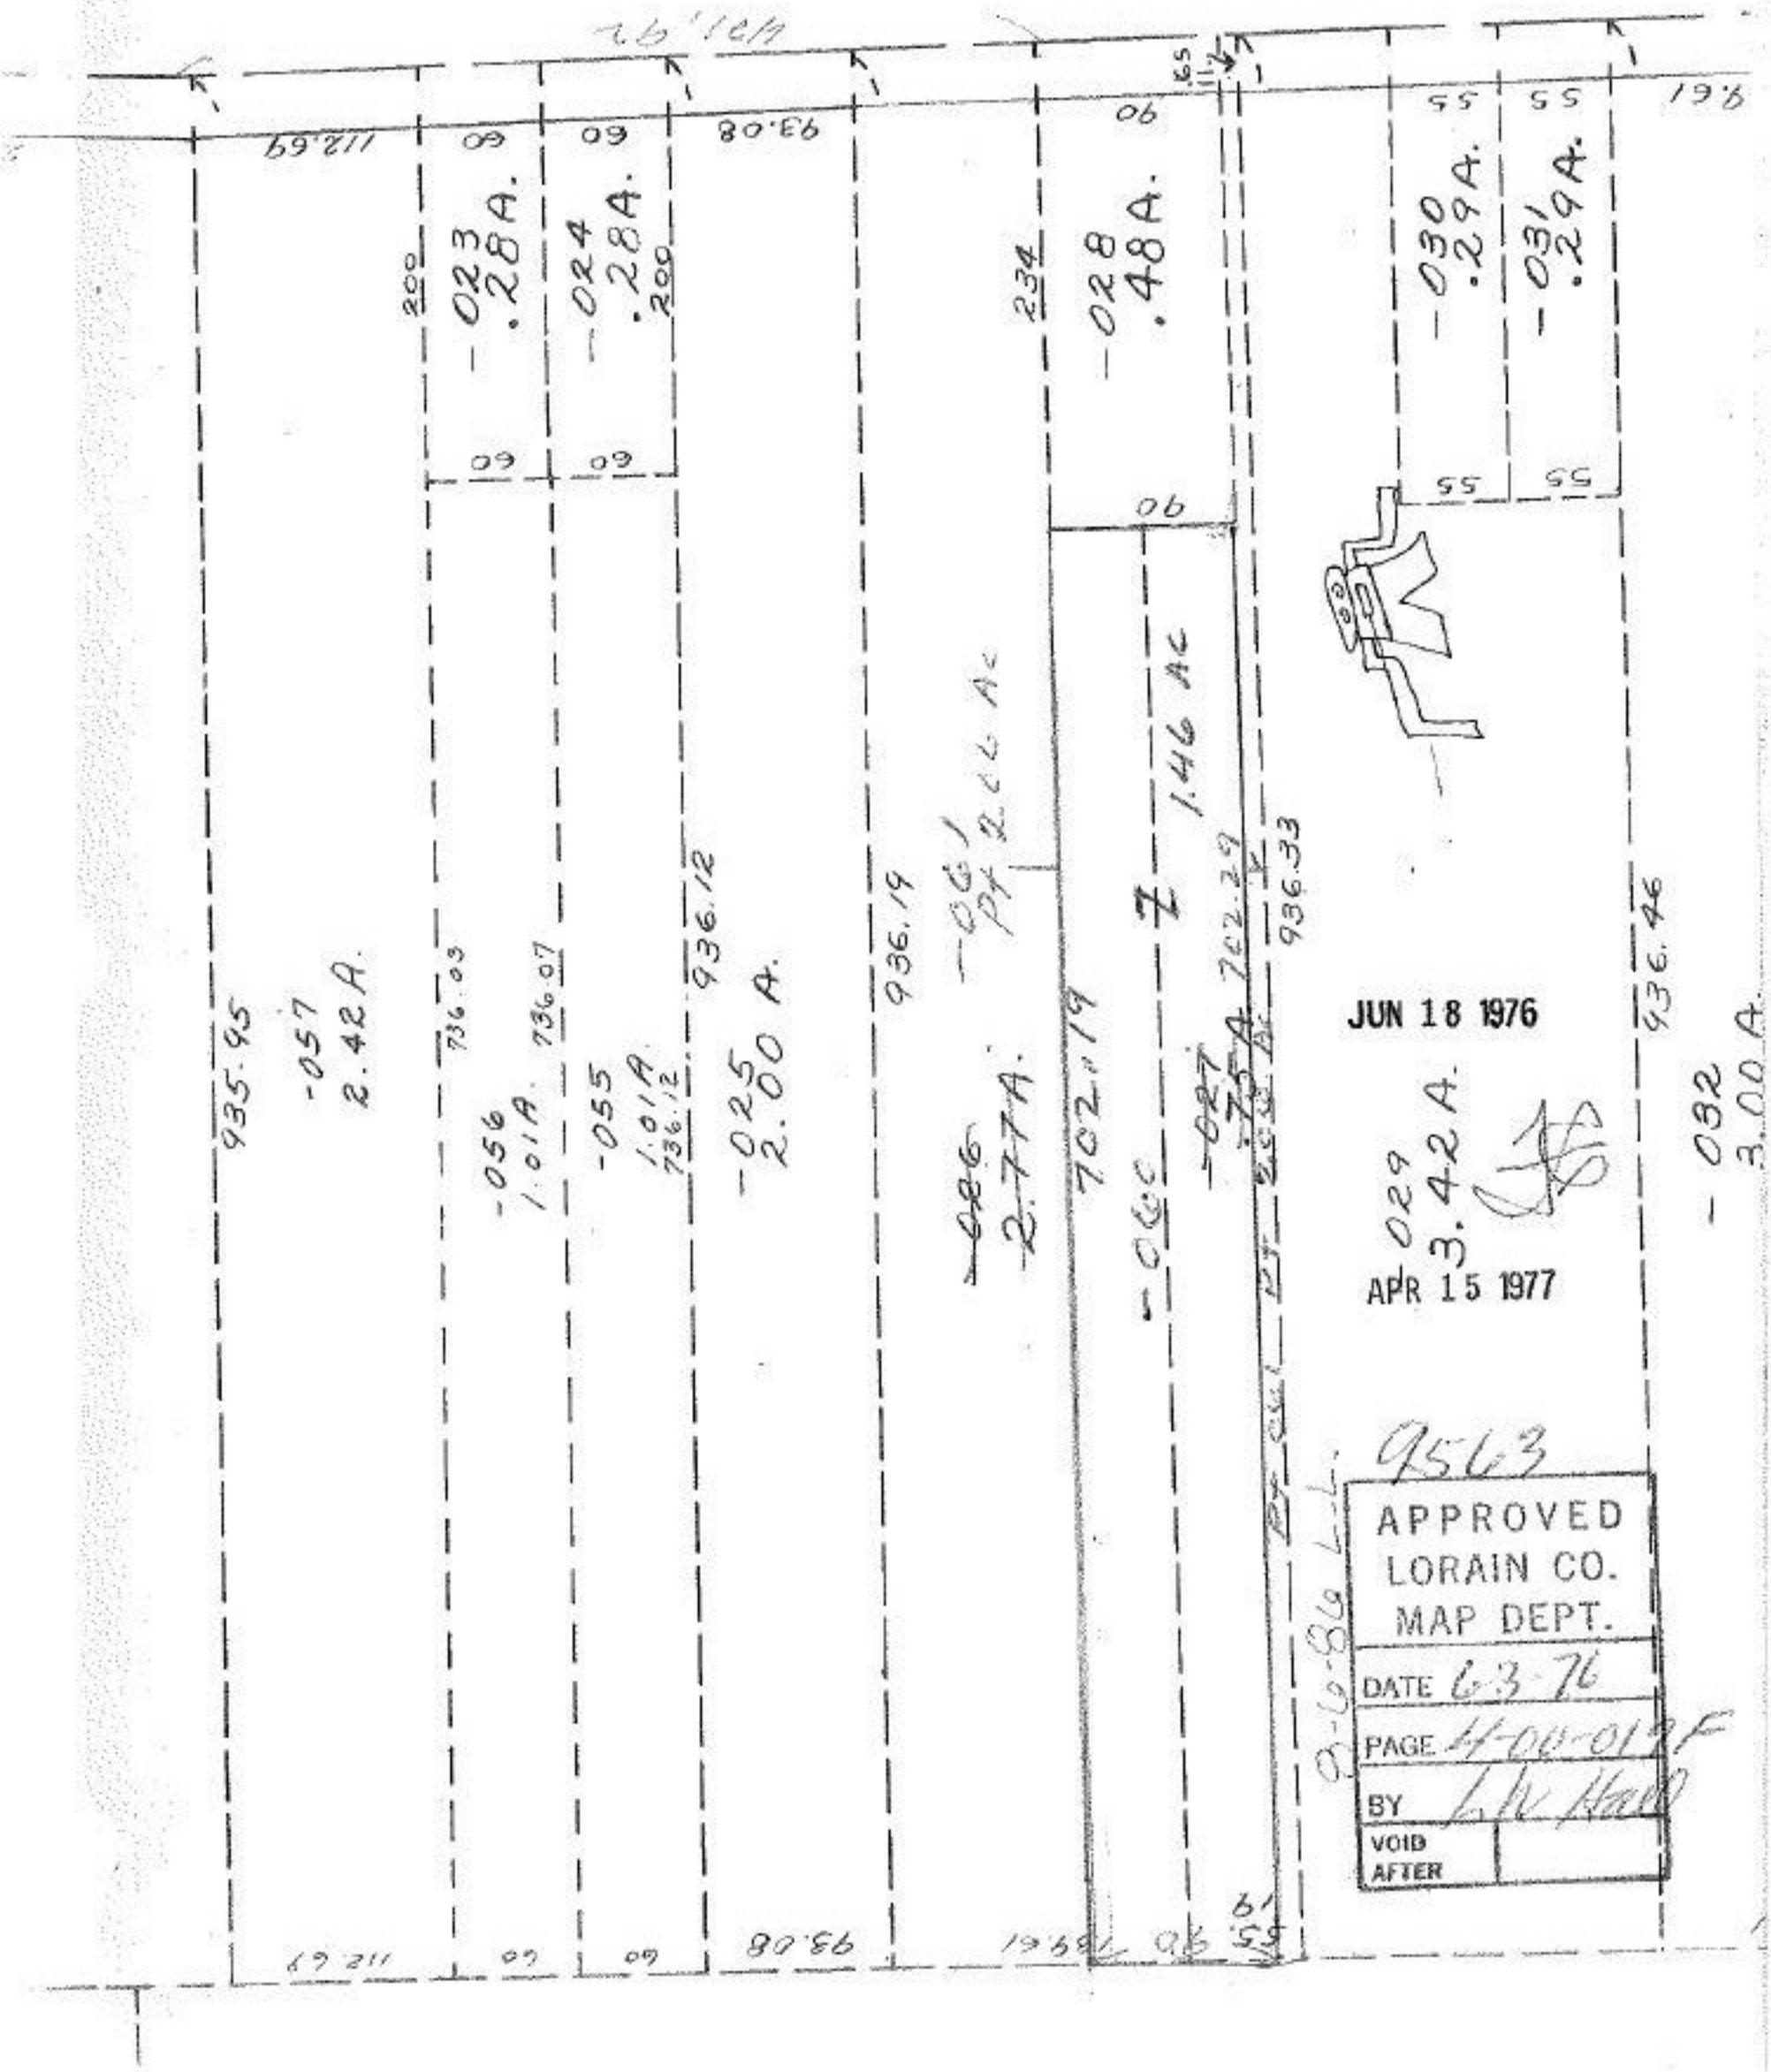

JUN 18 1976

APR 15 1977

9563

APPROVED
LORAIN CO.
MAP DEPT.

DATE 6-3-76

PAGE 4-00-019F

BY L.W. Hall

VOID AFTER