

9564 SEE 10-00

9564

-001
11.87A.

9564

APPROVED
LORAIN CO.
MAP DEPT.


DATE 4-23-76

PAGE 10-00-0001 F

BY [Signature]

VOID AFTER [Signature]

98-8-8
8.8

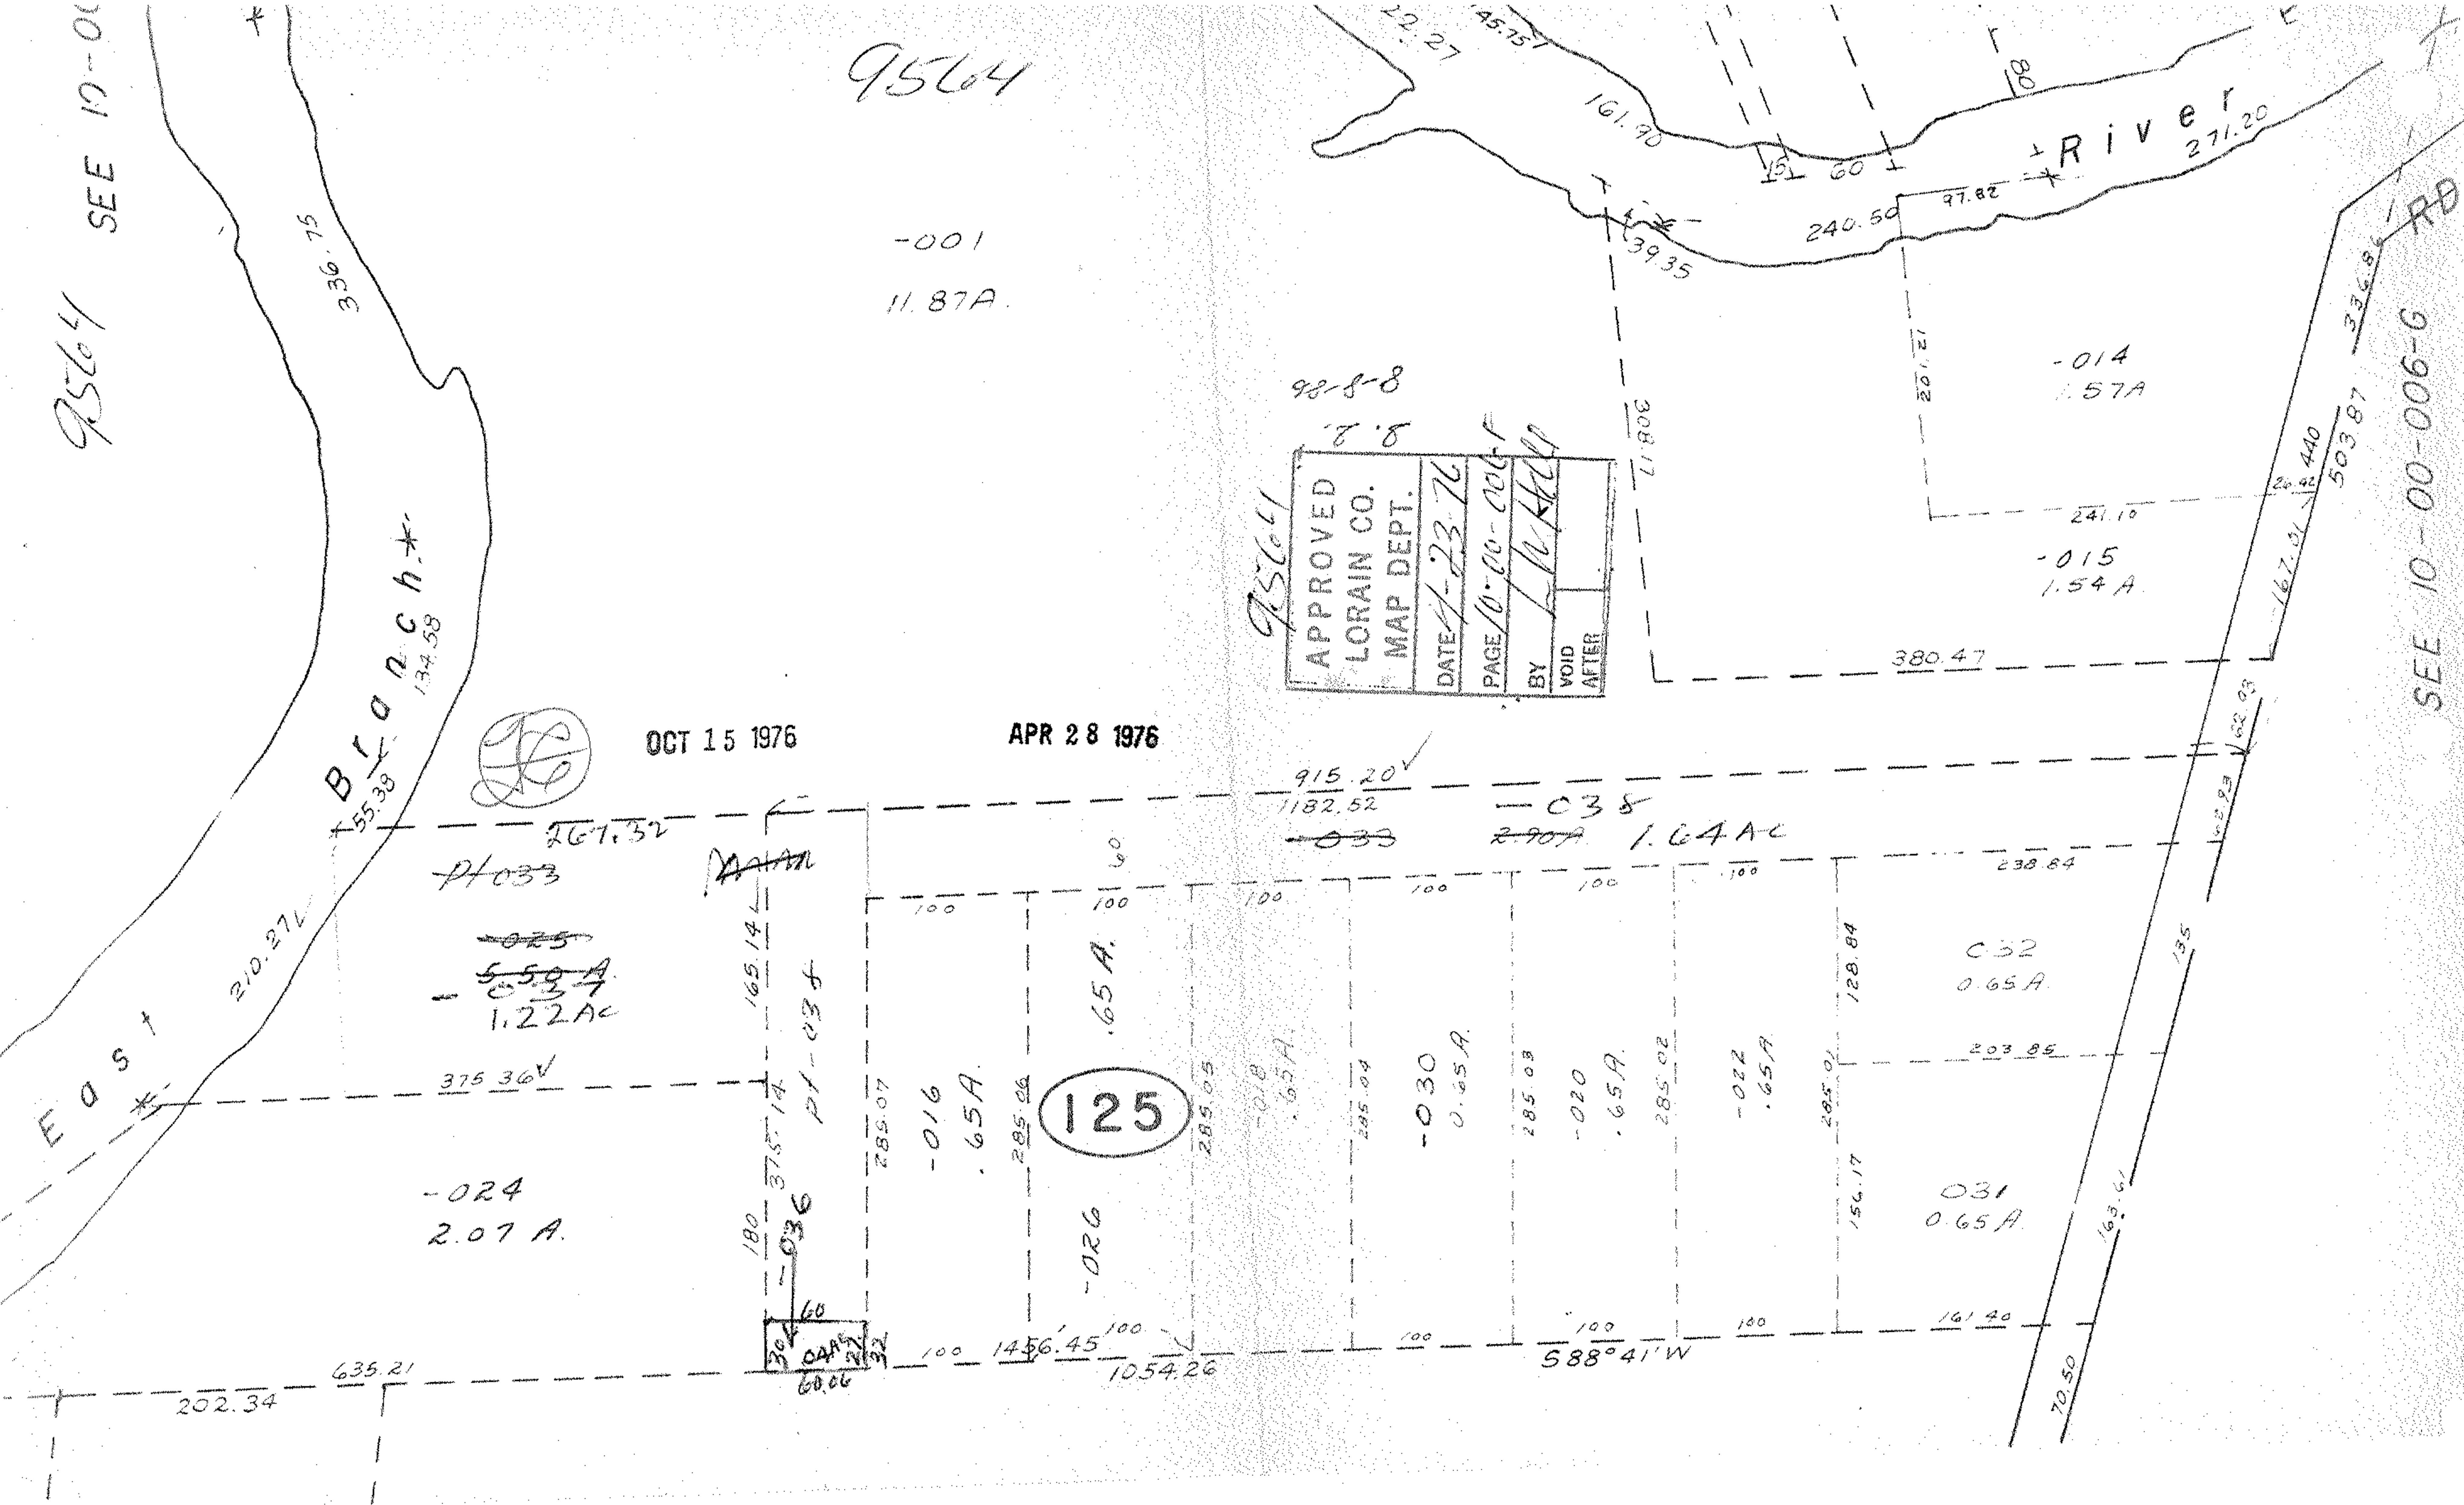

Branch River

River

OCT 15 1976

APR 28 1976

125

-024
2.07 A.

~~-025~~
~~-034~~
1.22 AC

~~-033~~
267.32

-016
.65 A.

-018
.65 A.

-030
0.65 A.

-020
.65 A.

-022
.65 A.

031
0.65 A.

032
0.65 A.

~~-033~~
2.90 A. 1.64 AC

-014
1.57 A.

-015
1.54 A.

SEE 10-00-006-G RD