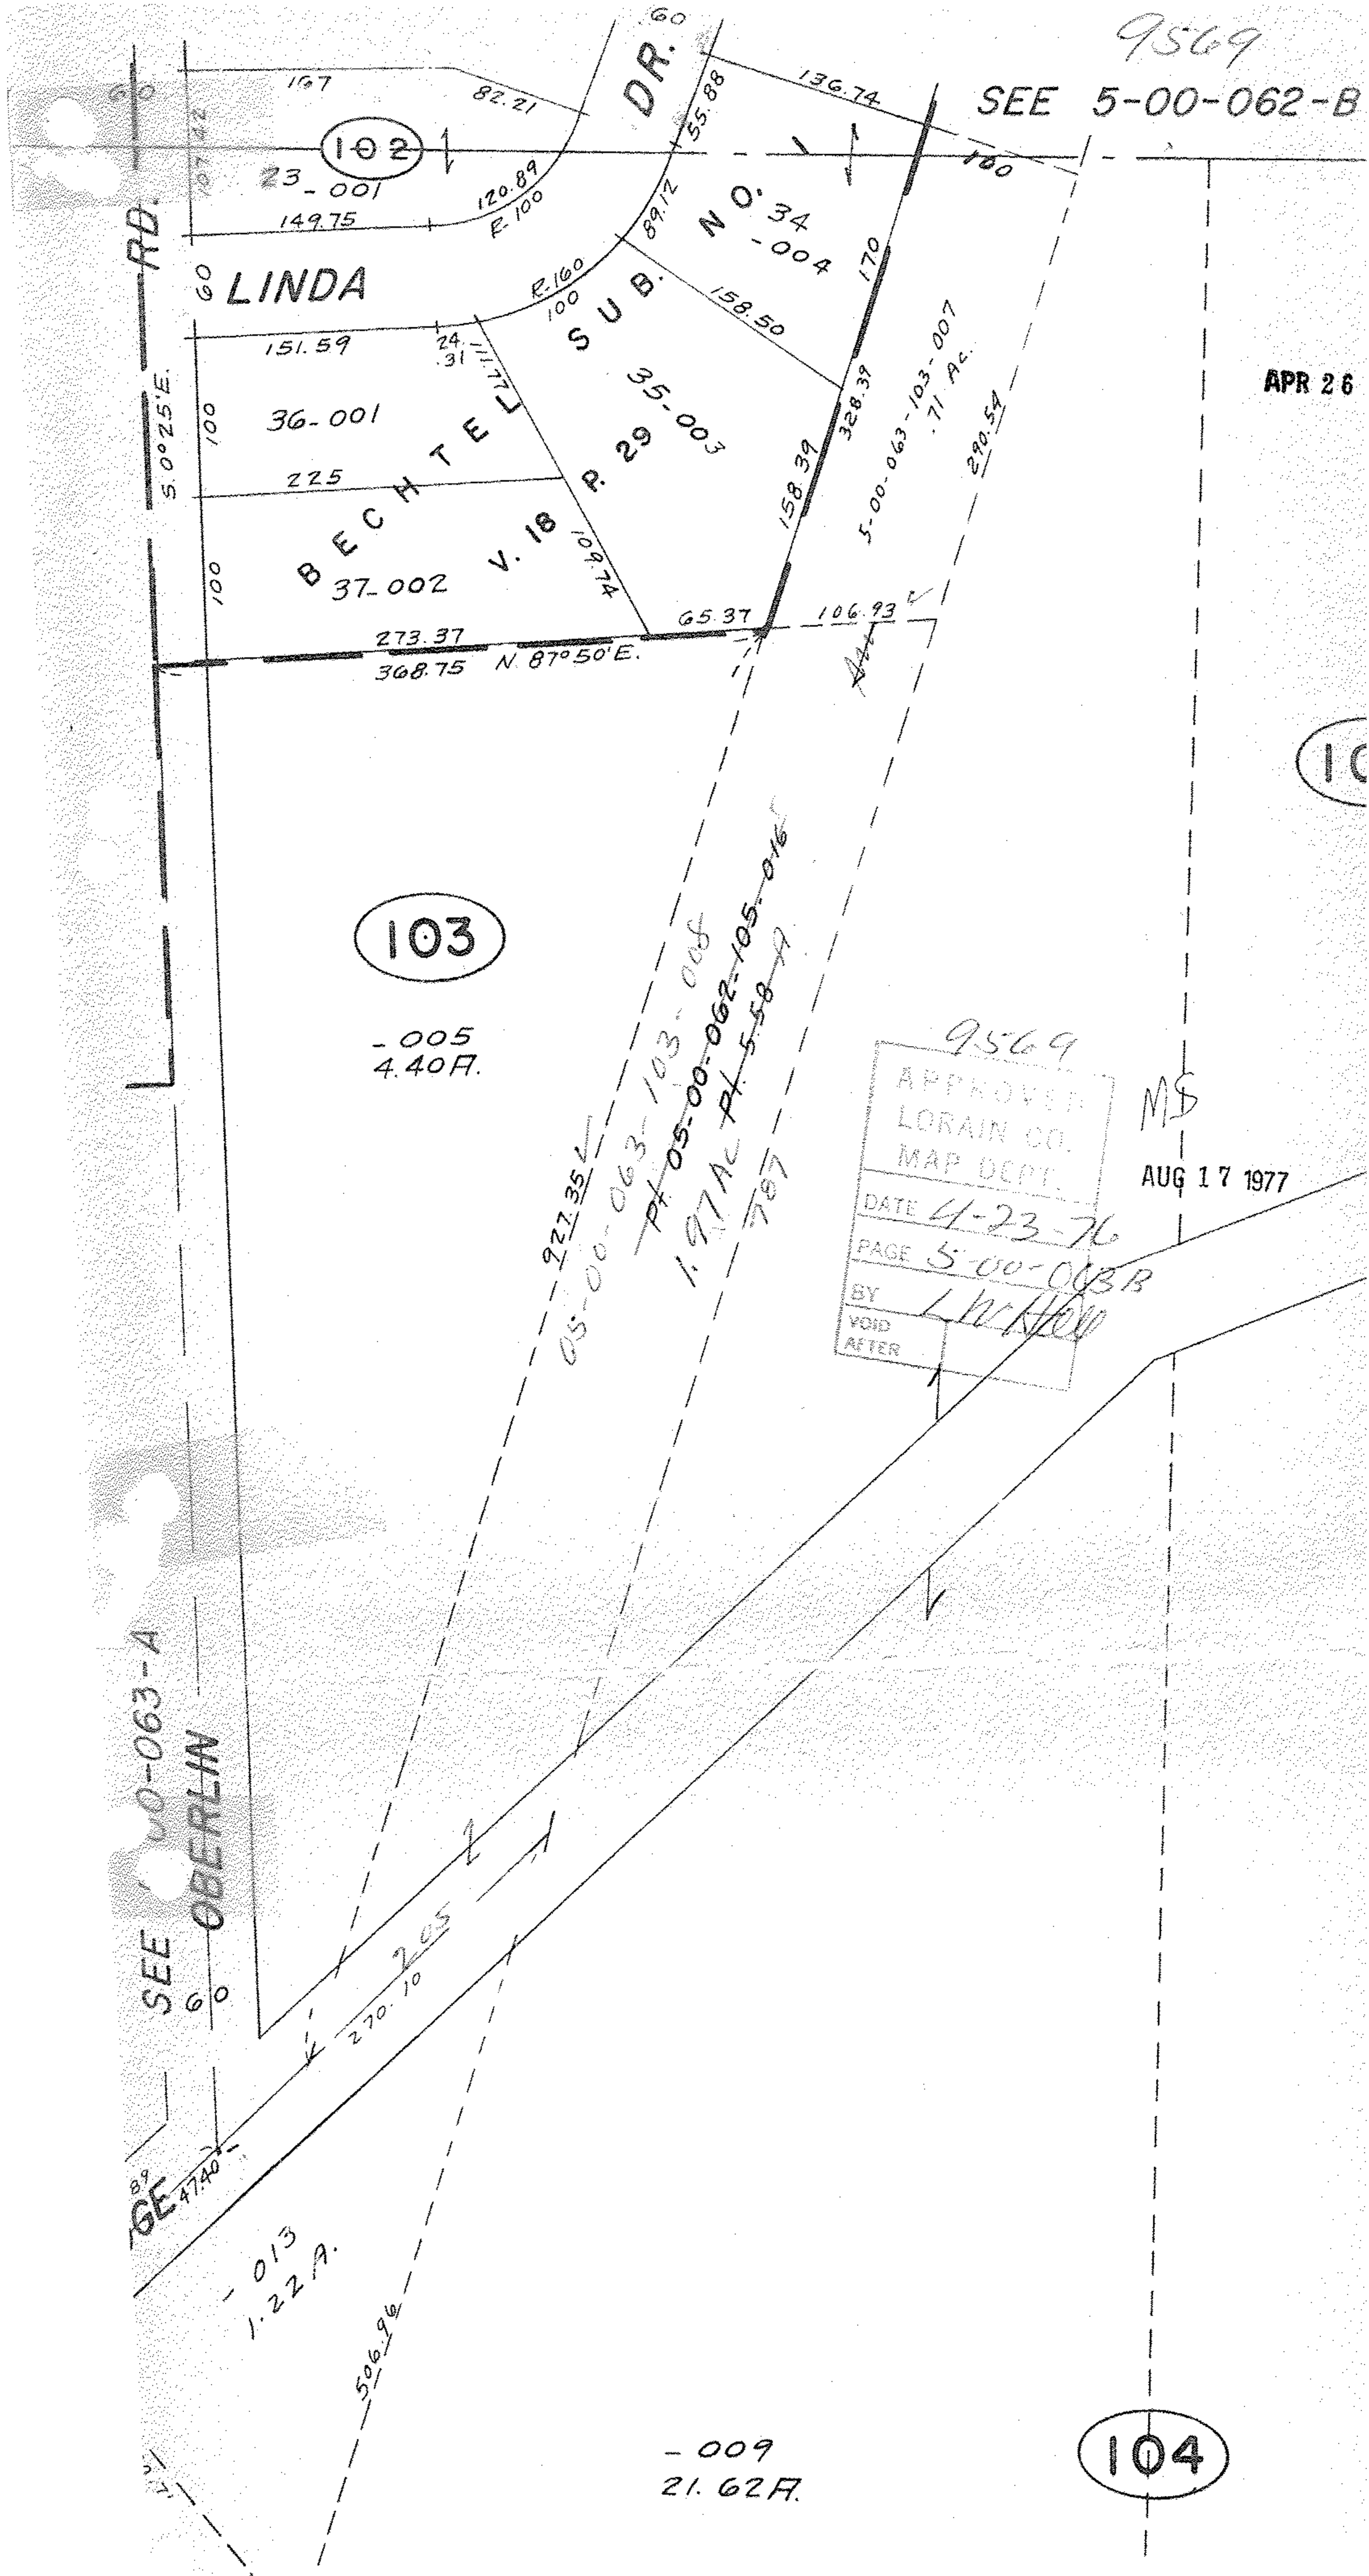
9569
SEE 5-00-062-B
DR.
RD.
LINDA
SUB.
NO. 34
-004
BECHTEL
V. 18 P. 29
35-003
36-001
37-002
23-001
102
103
-005
4.40A.
104
-009
21.62A.
-013
1.22A.
SEE 5-00-063-A
OBERLIN
APR 26
AUG 17 1977
APPROVED
LORAIN CO.
MAP DEPT.
DATE 4-23-76
PAGE 5-00-063B
BY
VOID AFTER
5-00-063-103-007
.71 Ac.
05-00-063-103-008
Pt. 05-00-062-105-016
1.97 Ac. Pt. 5.58-A
787
167
82.21
136.74
55.88
120.89
E. 100
149.75
89.12
R. 160
100
158.50
170
151.59
24.31
11.77
S. 0°25'E.
225
109.74
158.39
328.39
290.54
273.37
368.75
N. 87°50'E.
65.37
106.93
927.35
270.10
205
506.96
47.40
89.12
60