9569

APR 26 1976

SEE

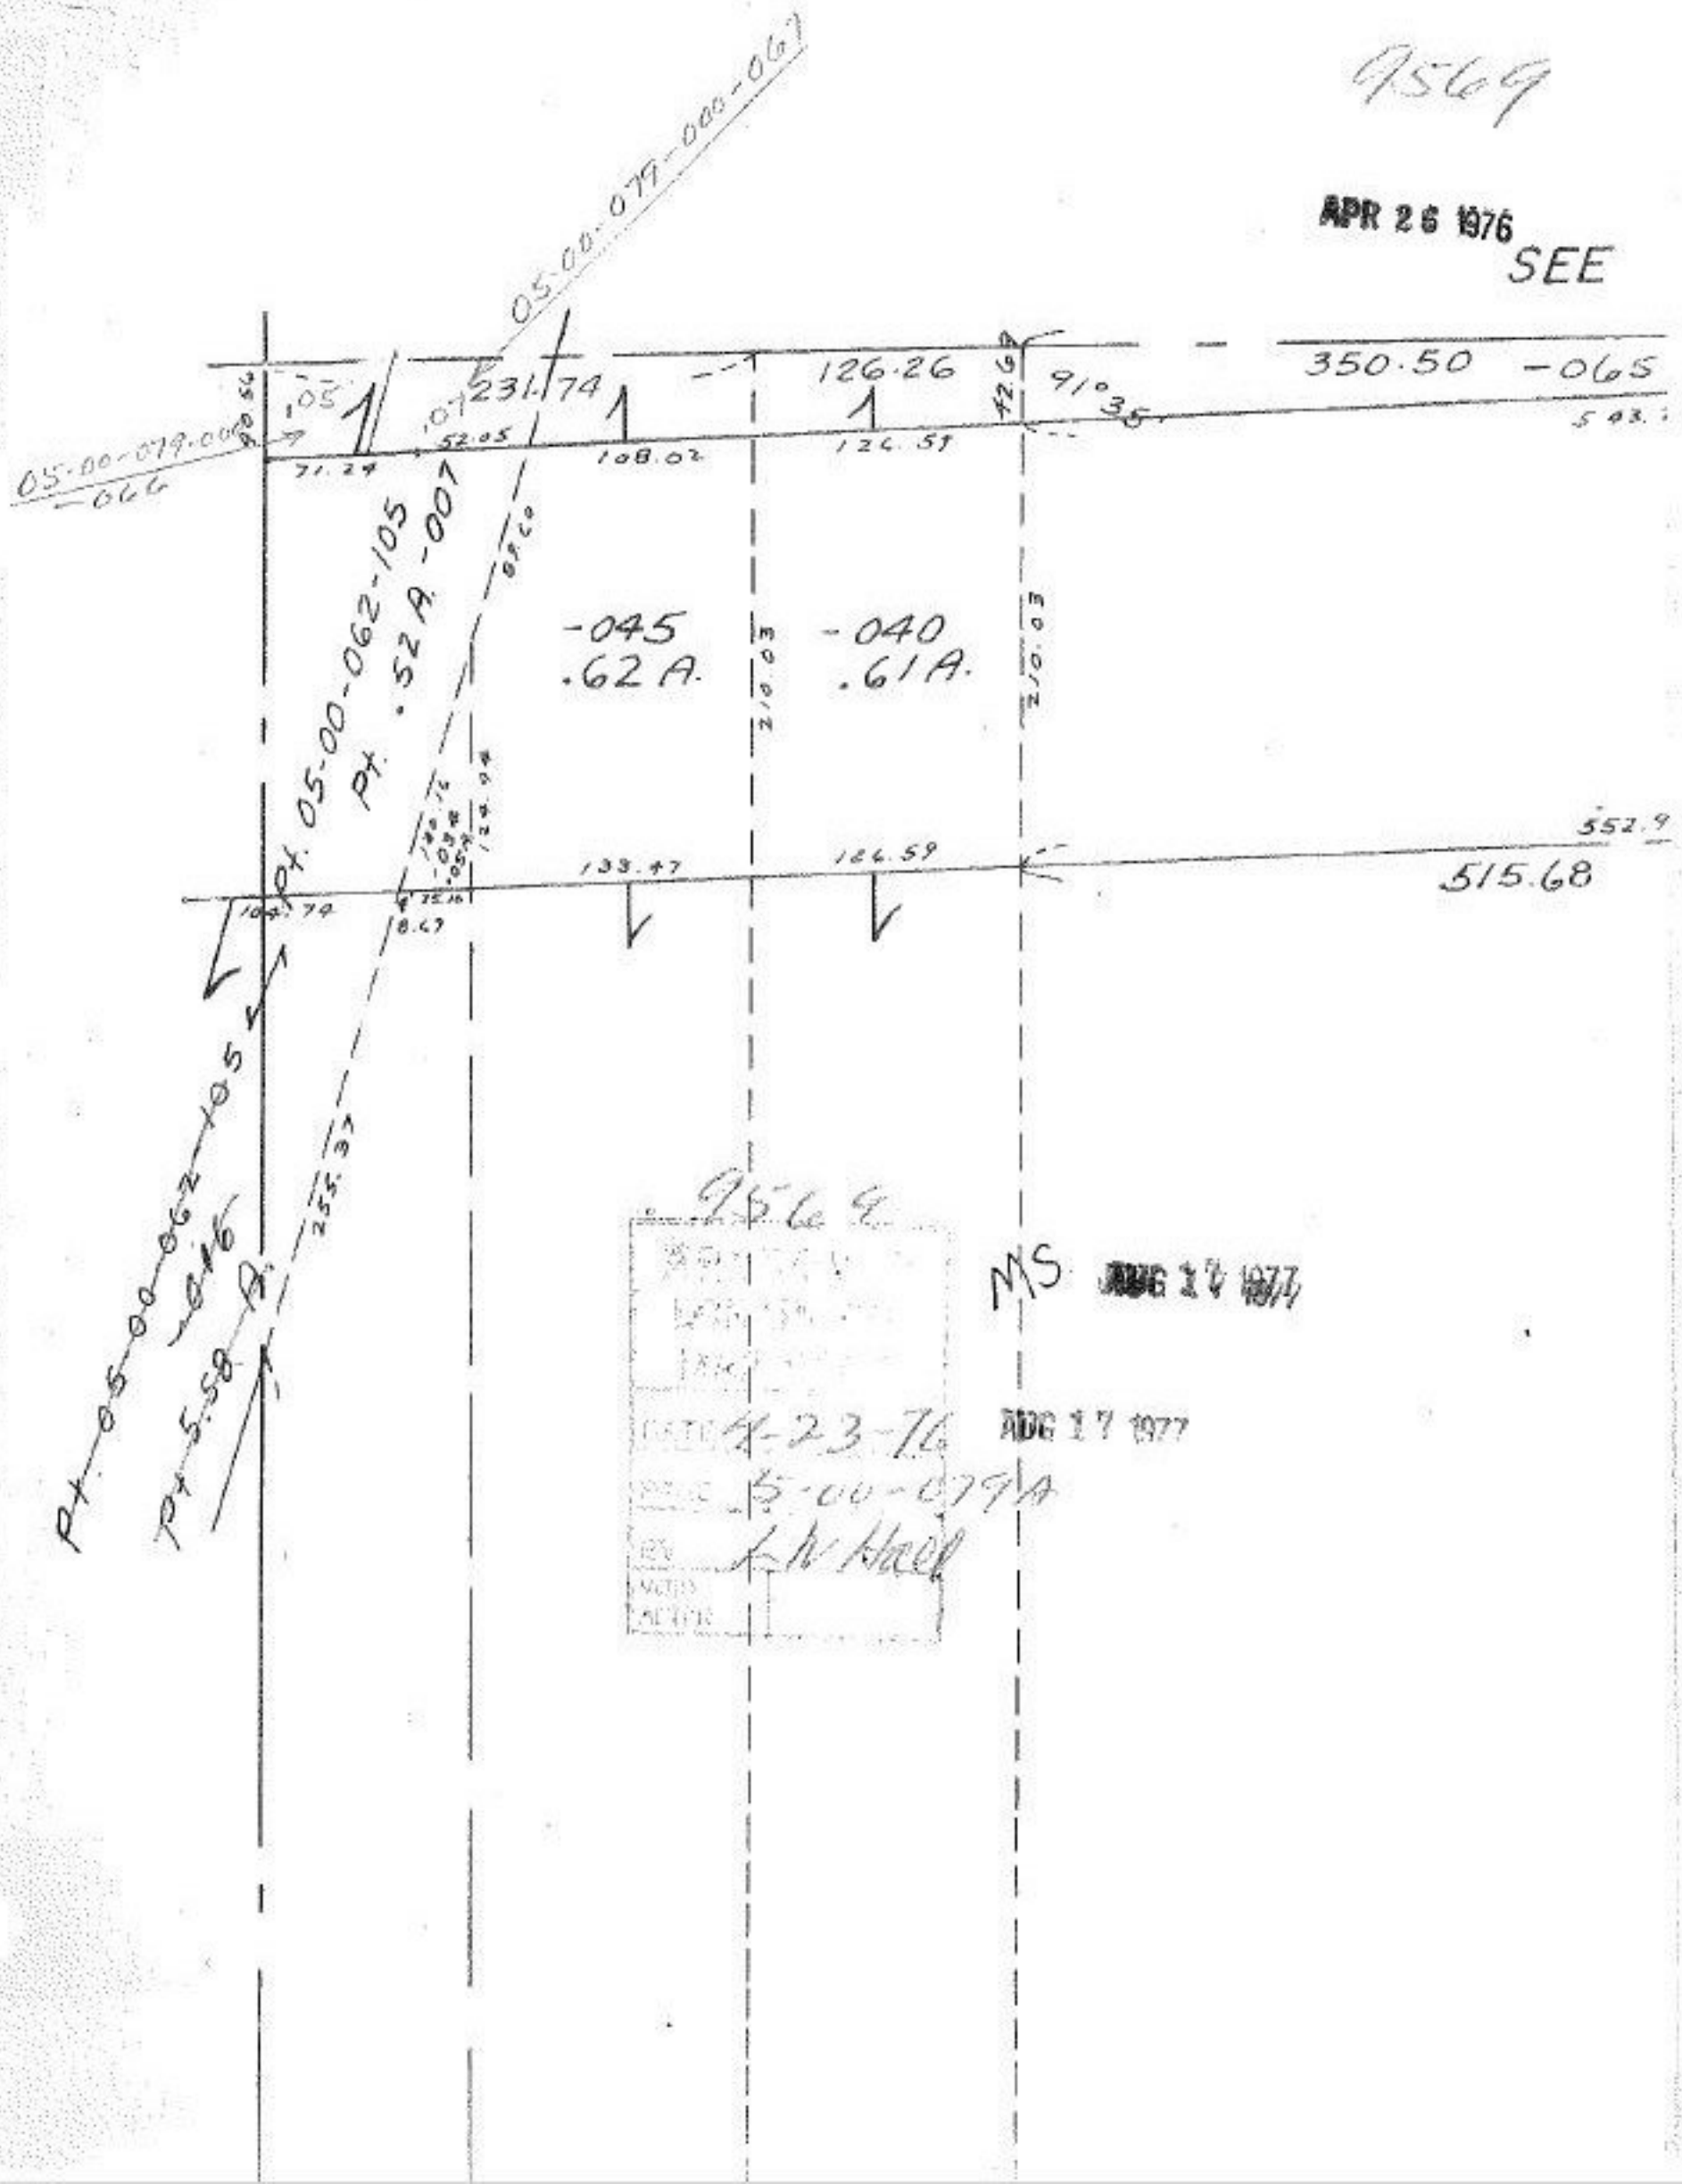

9569

MS AUG 17 1977

DATE 4-23-76 AUG 17 1977

PAGE 5-00-079A

BY L.W. Hall