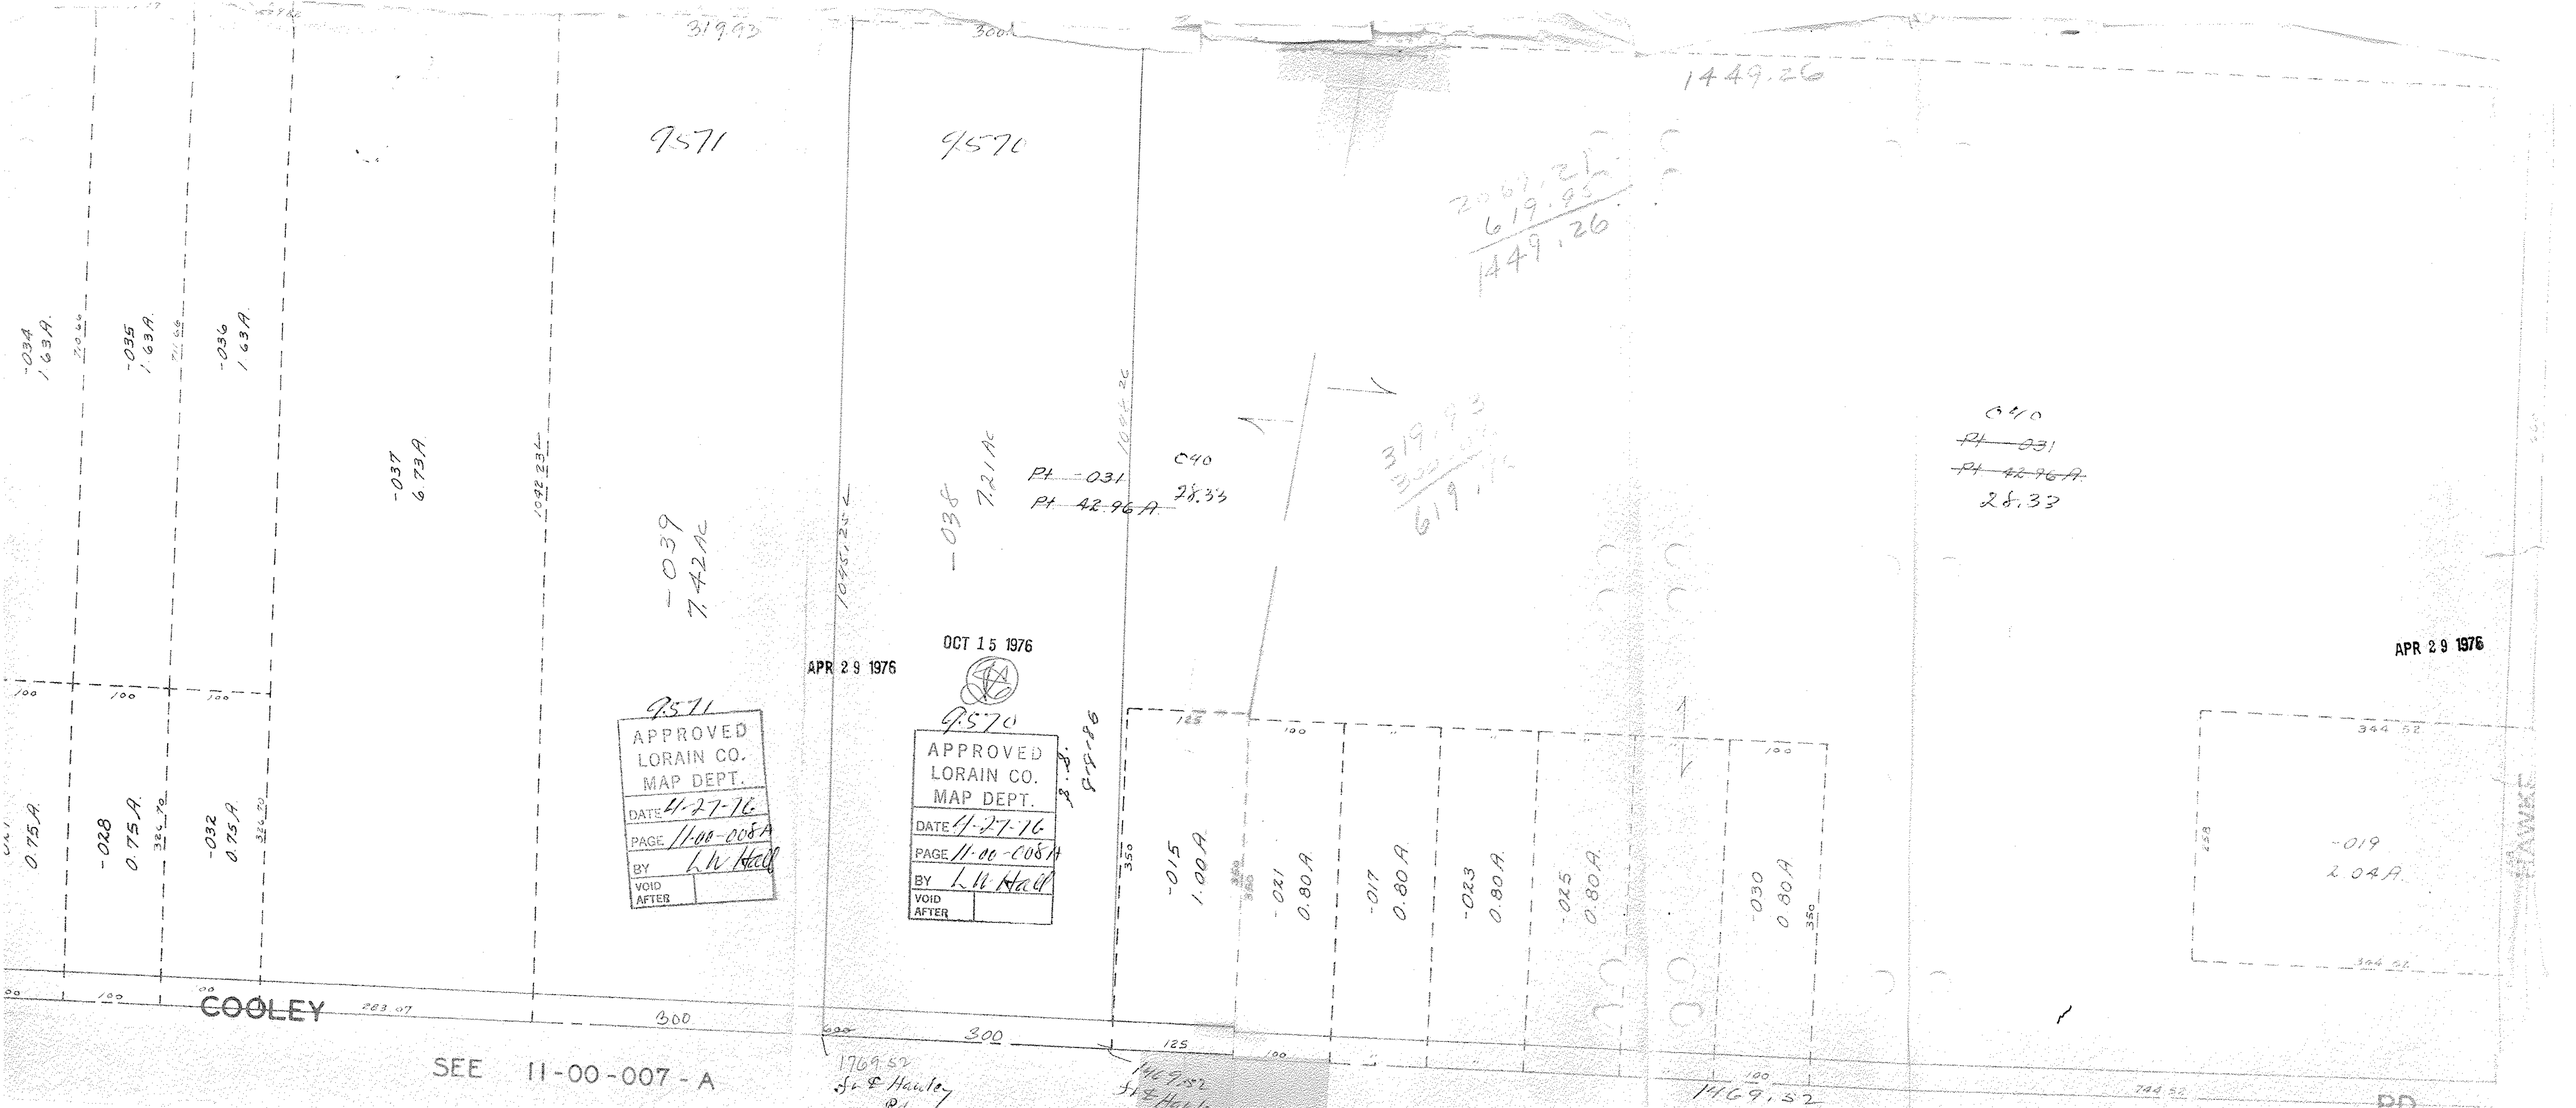
9571
9570
-034
1.63A.
-035
1.63A.
-036
1.63A.
-037
6.73A
-039
7.42Ac
-038
7.21Ac
Pt -031
Pt 42.96A
C40
28.33
1449.26
619.93
1449.26
C40
Pt 031
Pt 42.96A
28.33
APR 29 1976
OCT 15 1976
APPROVED
LORAIN CO.
MAP DEPT.
DATE 4-27-76
PAGE 11-00-008A
BY L.N. Hall
VOID AFTER
APPROVED
LORAIN CO.
MAP DEPT.
DATE 4-27-76
PAGE 11-00-008A
BY L.N. Hall
VOID AFTER
-015
1.00A.
-021
0.80A.
-017
0.80A
-023
0.80A.
-025
0.80A.
-030
0.80A
-019
2.04A.
-028
0.75A.
-032
0.75A
COOLEY
SEE 11-00-007-A
300
1969.52
1449.52
1449.52
RD