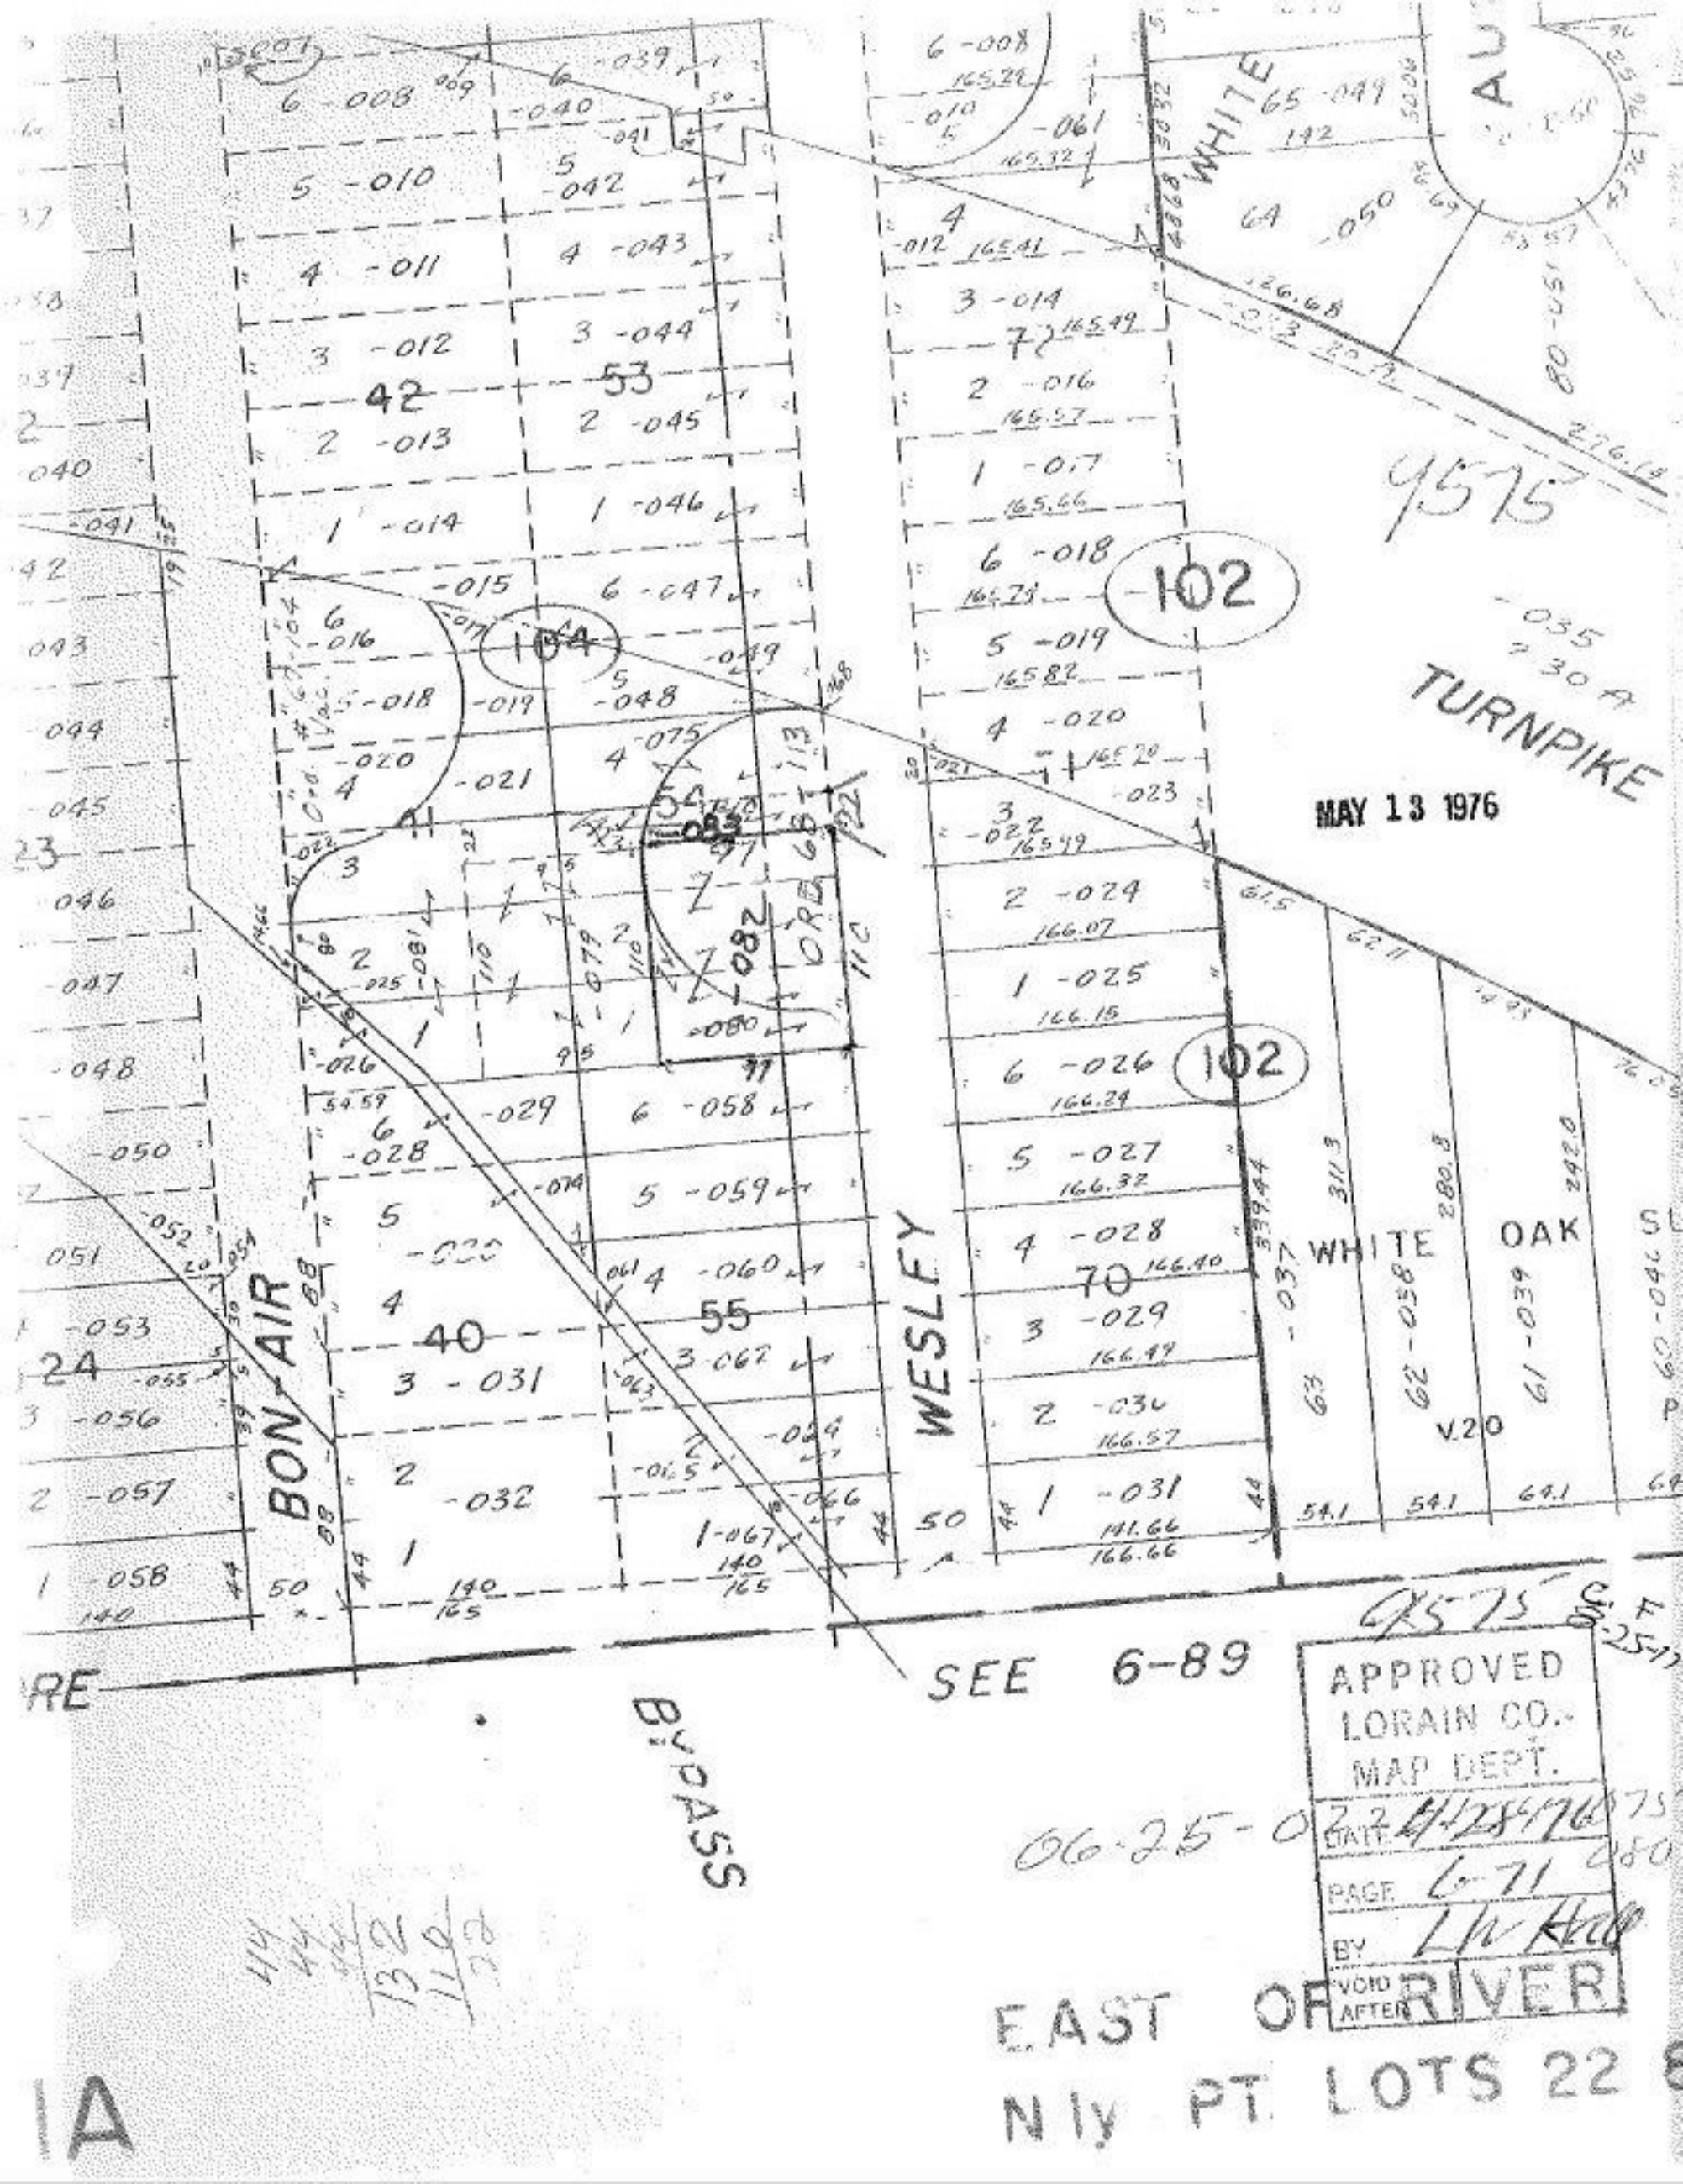

WHITE
TURNPIKE
MAY 13 1976
WHITE OAK
WESLEY
BON AIR
SEE 6-89
BYPASS
APPROVED
LORAIN CO.
MAP DEPT.
DATE
PAGE 6-71
BY
VOID AFTER
RIVER
EAST OF
N ly PT. LOTS 22