


ITES

9594

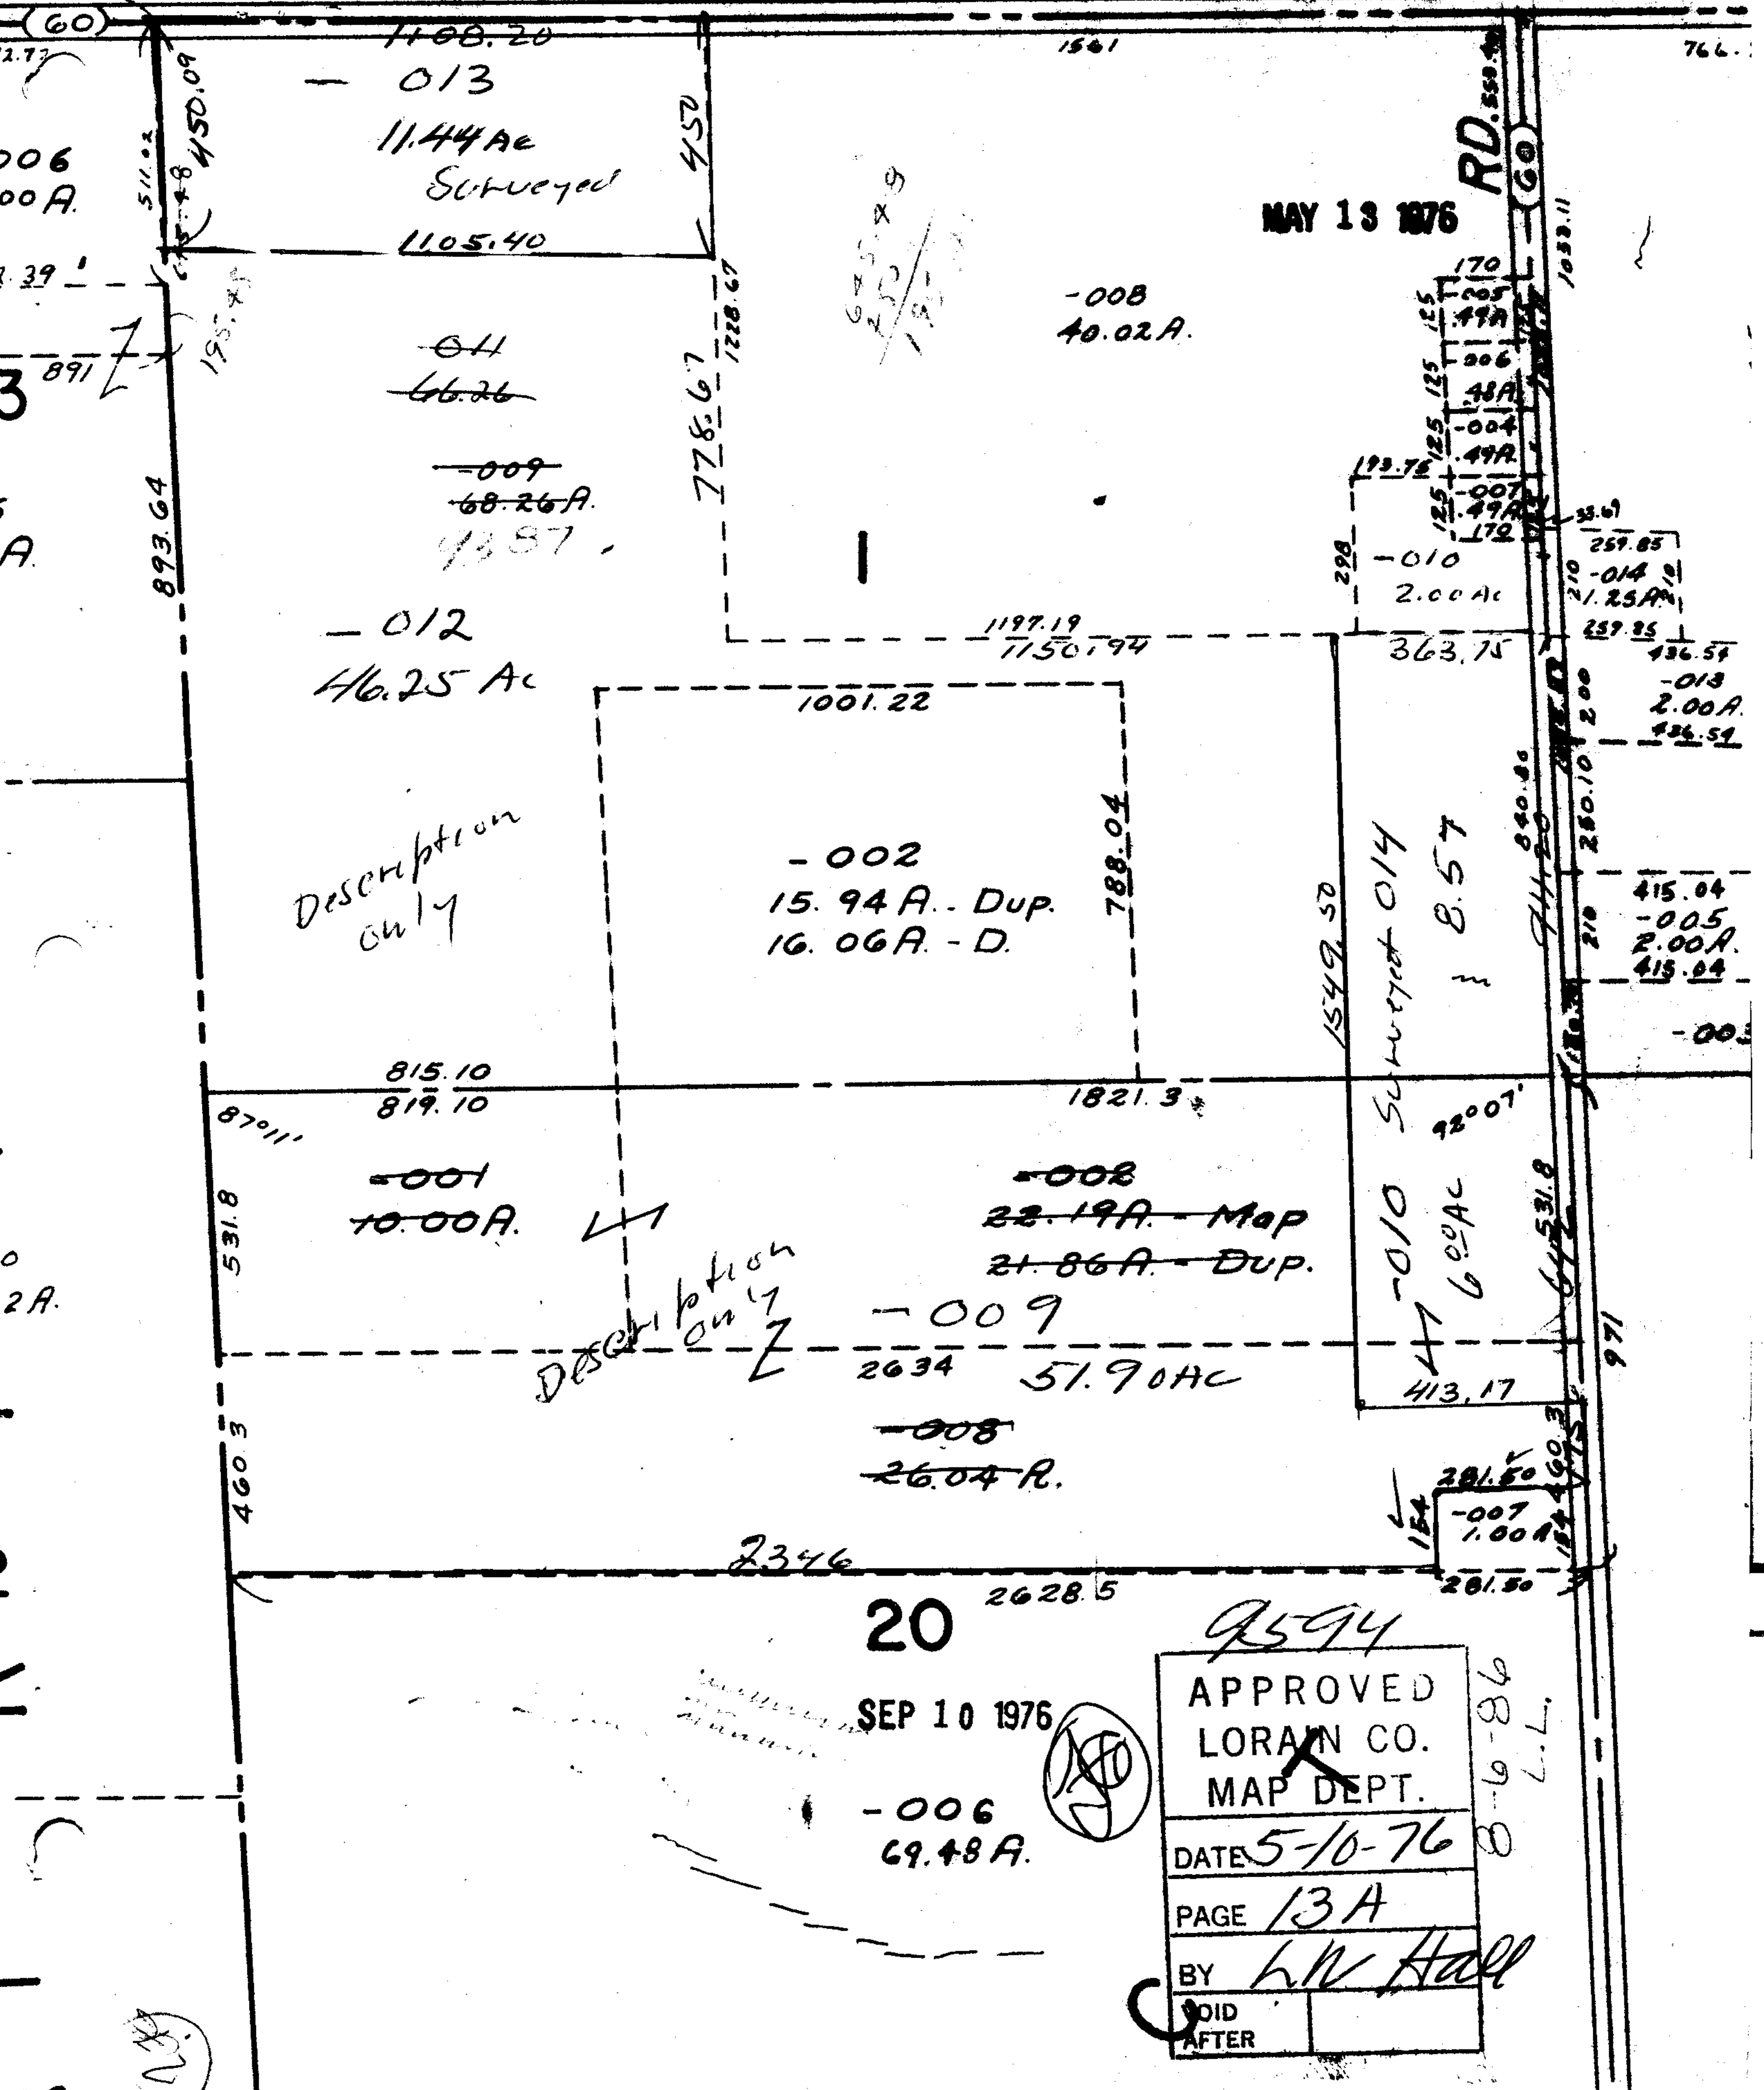

Description only

Description only

MAY 13 1876

20
SEP 10 1976

9594

APPROVED
LORAN CO.
MAP DEPT.

DATE 5-10-76

PAGE 13A

BY L.V. Hall

VOID AFTER

1108.20
- 013
11.44 Ac
Surveyed
1105.40

011
~~66.26~~
-009
~~68.26 A.~~
43.87

- 012
46.25 Ac

- 002
15.94 A. - Dup.
16.06 A. - D.

815.10
819.10
-001
10.00 A.

-008
~~22.19 A. - Map~~
~~21.86 A. - Dup.~~

-009
2634 51.90 AC

-008
26.04 R.

-006
69.48 A.

RD. 250

170
165
257.85
-014
21.25 A.
257.85
436.57
-013
2.00 A.
436.57
415.04
-005
2.00 A.
415.04
-004

1549.50
Surveyed 014
8.57
6.00 AC

281.50
-007
1.00 A.
281.50

6-6-86
L.L.