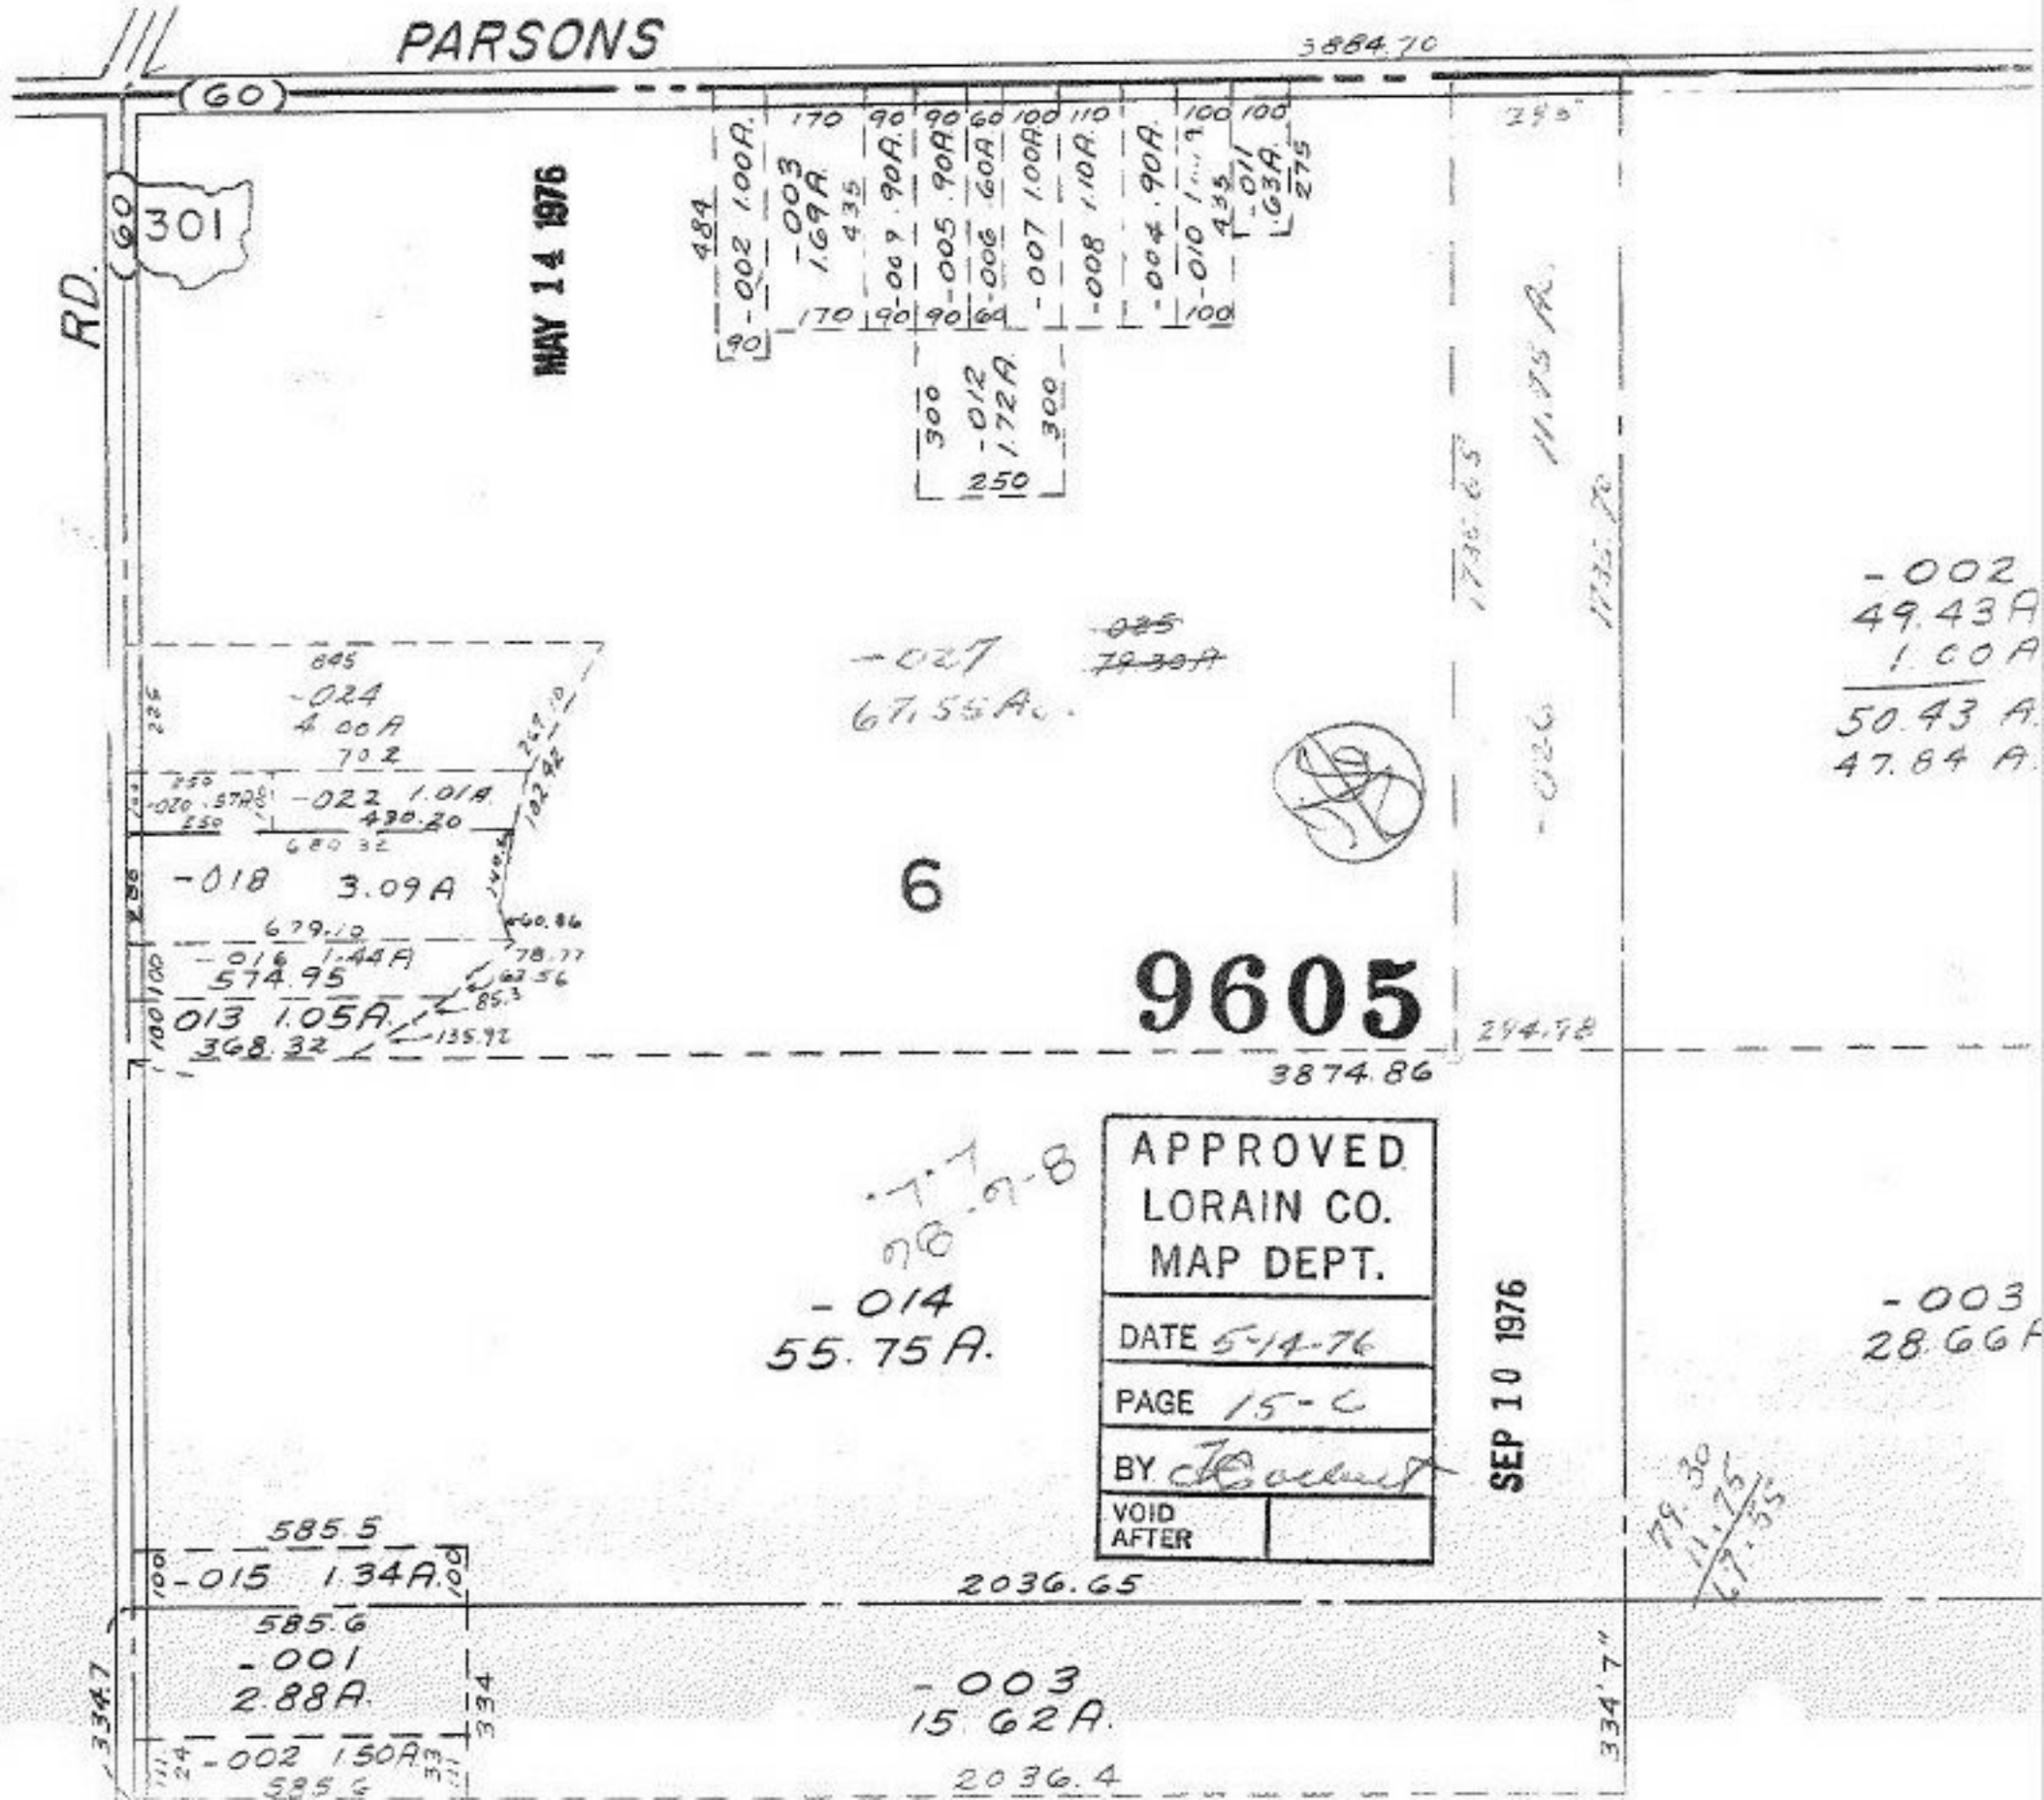
PARSONS
3884.70
(60)
301
RD.
MAY 14 1976
-002 1.00A.
-003 1.69A.
-009 .90A.
-005 .90A.
-006 .60A.
-007 1.00A.
-008 1.10A.
-004 .90A.
-010
-011 .63A.
-012 1.72A.
-024 4.00A
-022 1.01A.
-018 3.09A
-016 1.44A
-013 1.05A.
-027 67.55A.
6
9605
3874.86
-014 55.75A.
-002 49.43A 1.00A 50.43 A. 47.84 A.
-003 28.66A
APPROVED
LORAIN CO.
MAP DEPT.
DATE 5-14-76
PAGE 15-C
BY
VOID AFTER
SEP 10 1976
-015 1.34A.
-001 2.88A.
-002 1.50A.
-003 15.62A.
2036.65
2036.4
334.7
334'7"