


SEE

SEE II

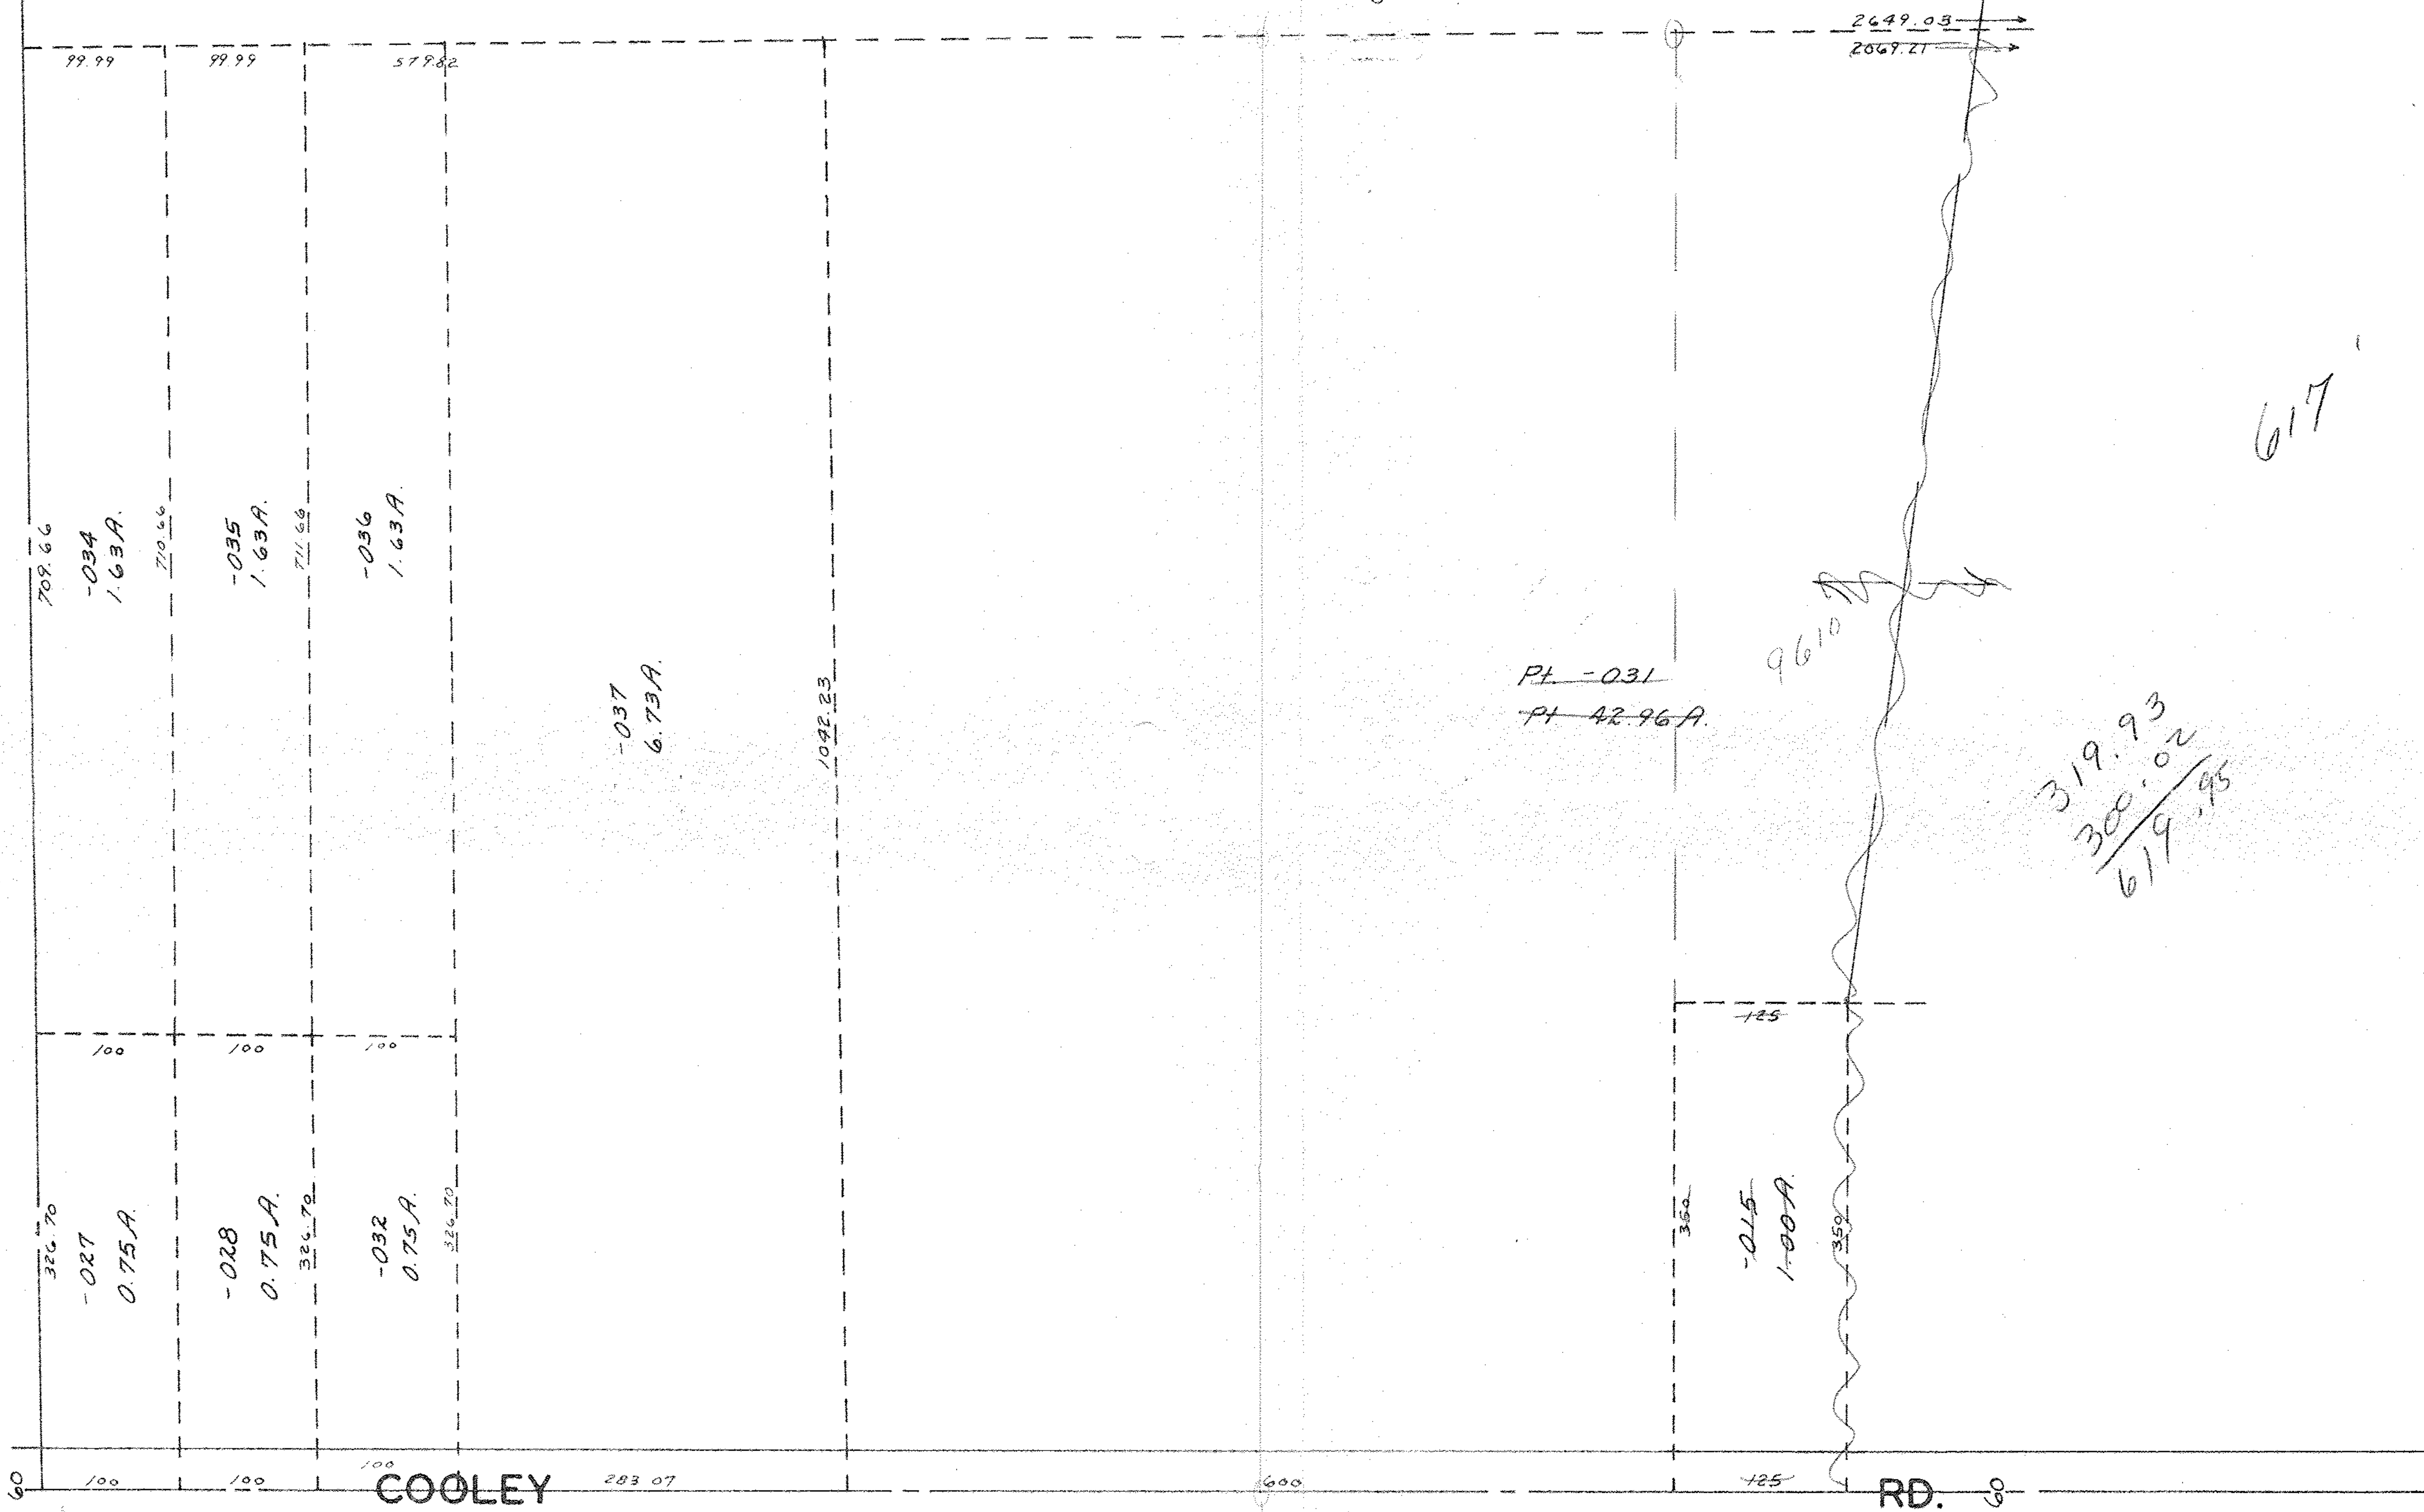

SEE II-00-007 - A

OCT 15 1976



EATON TWP.

W 1/2 LOT 8

SCALE: 1" = 100'

ED 10-008 A