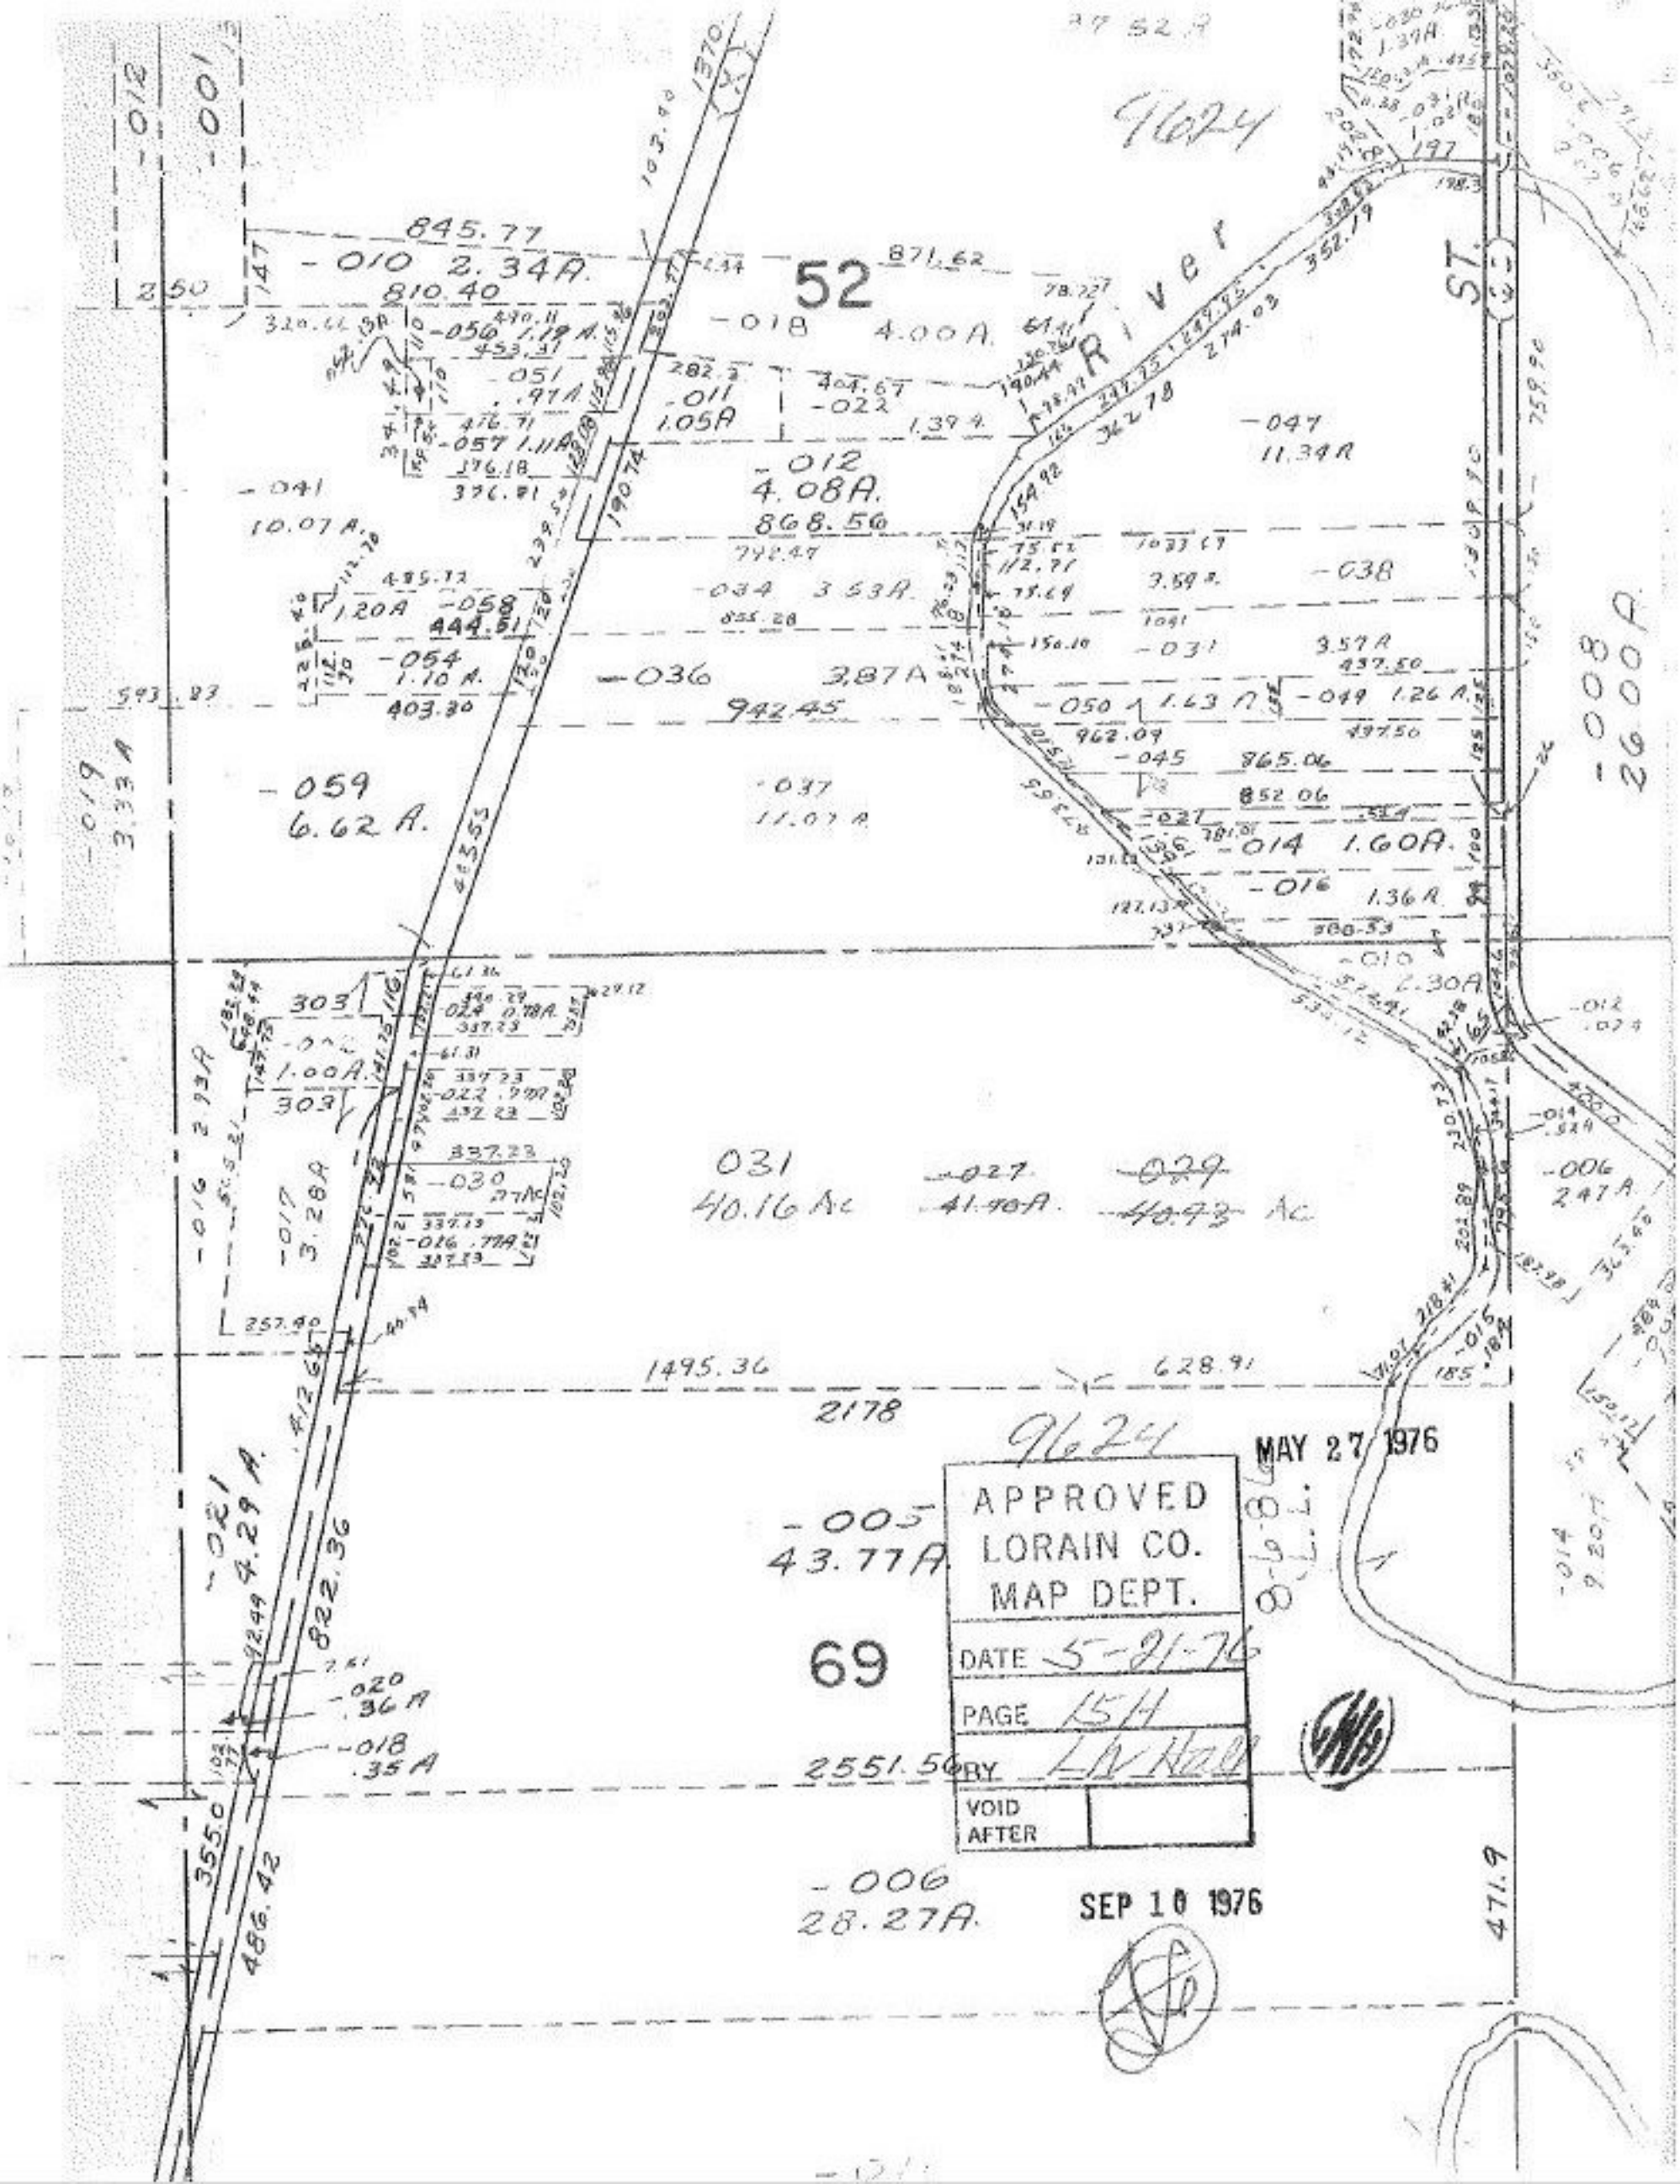

9624
52
River
ST.
845.77
-010 2.34A.
810.40
871.62
-018 4.00A.
-012
4.08A.
868.56
-047
11.34A
-041
10.07A.
-034 3.53A.
-038
-058
444.51
-054
1.10 A.
403.30
-036 3.87A
942.45
-050 1.63 A
-049 1.26 A.
-059
6.62 A.
-037
11.07 A
-045
865.06
852.06
-014 1.60A.
-016 1.36 A
-010
2.30A
-008
26.00 A
-019
3.33 A
303
1.00A.
303
-030
-017
3.28A
031
40.16 Ac
-027
41.90A.
-029
40.93 Ac
-006
2.47 A
1495.36
628.91
2178
9624
MAY 27 1976
-005
43.77A
APPROVED
LORAIN CO.
MAP DEPT.
DATE 5-21-76
PAGE 15H
BY LW Hall
VOID AFTER
69
-021
4.29 A.
822.36
-020
.36 A
-018
.35 A
2551.56
355.0
486.42
-006
28.27A.
SEP 10 1976
471.9