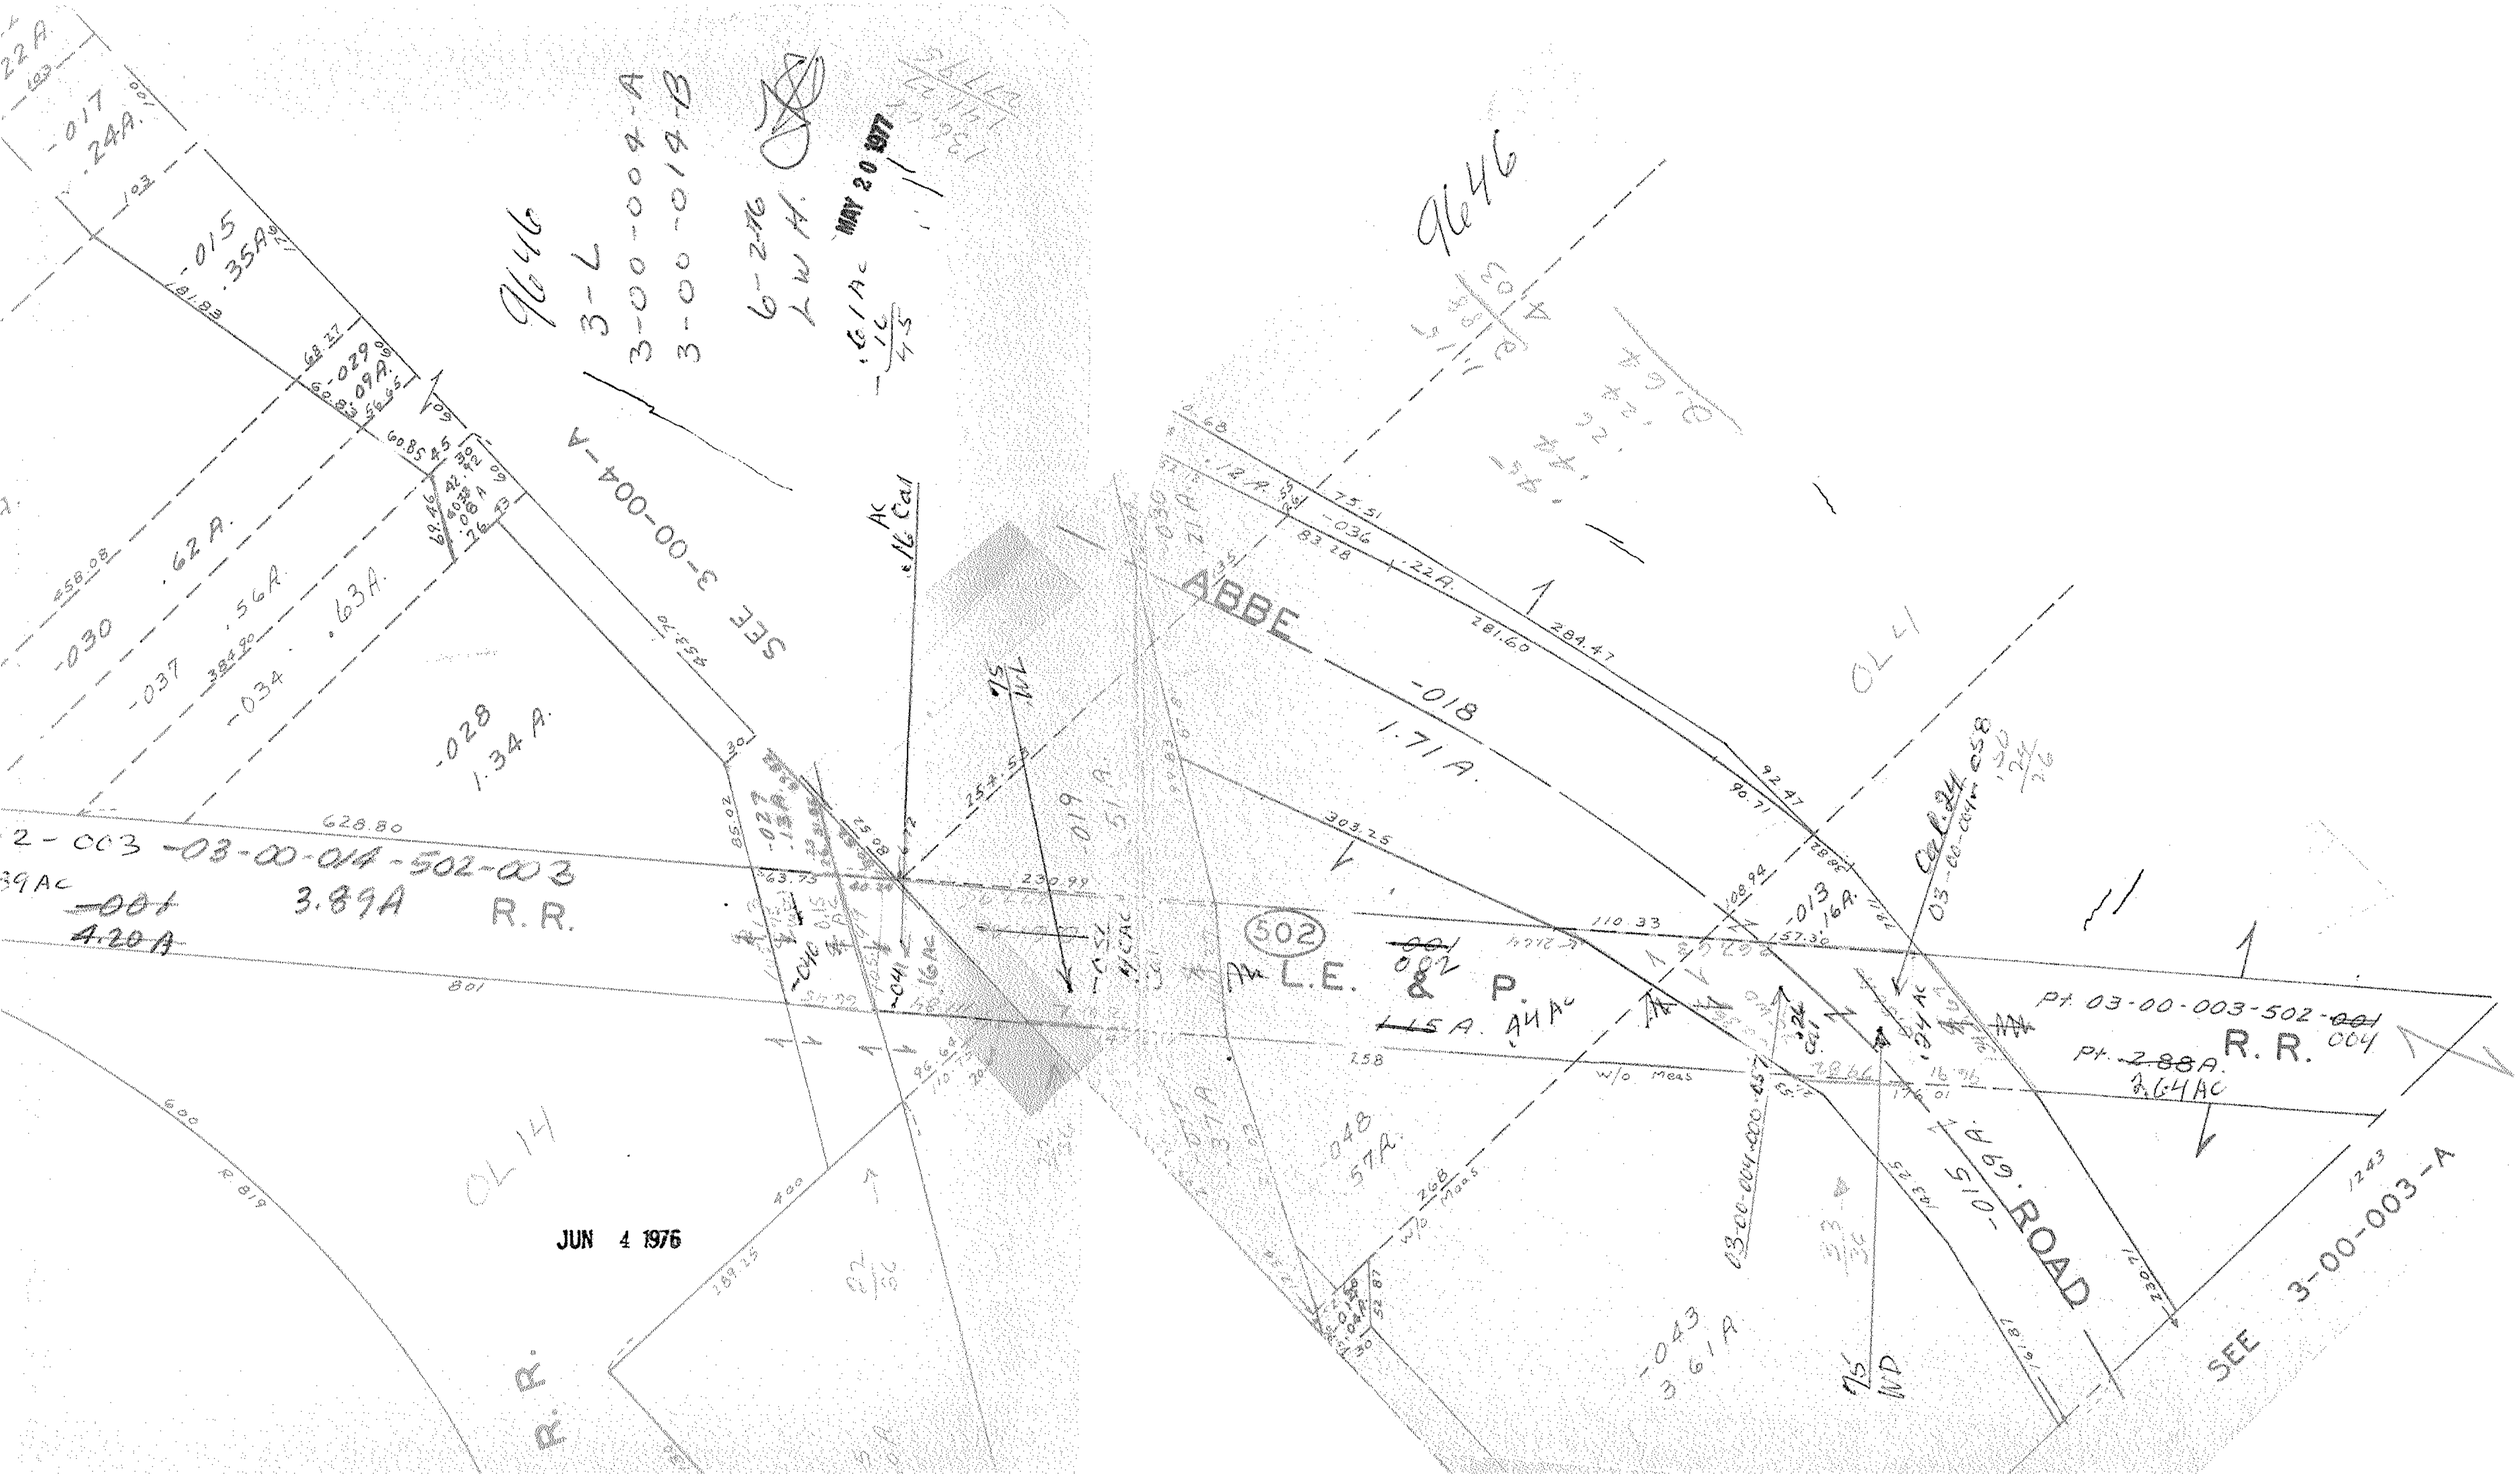

9646
3-L
3-00-004-A
3-00-014-B
6-2-76
LWH.
MAY 20 1977
SEE 3-00-004-A
-017
.24A.
-015
.35A.
-029
.09A.
-030
.62A.
-037
.56A.
-034
.63A.
-028
1.34A.
-018
1.71A.
-022A.
-036
-013
.16A.
-048
.57A.
-043
3.61A
-015
.69A.
ABBE
ROAD
OL 4
OL 14
R.R.
L.E. & P.
502
-2-003 -03-00-014-502-003
3.89A
-001
4.20A
Pt. 03-00-003-502-001
004
Pt. 2.88A.
2.64AC
SEE 3-00-003-A
JUN 4 1976