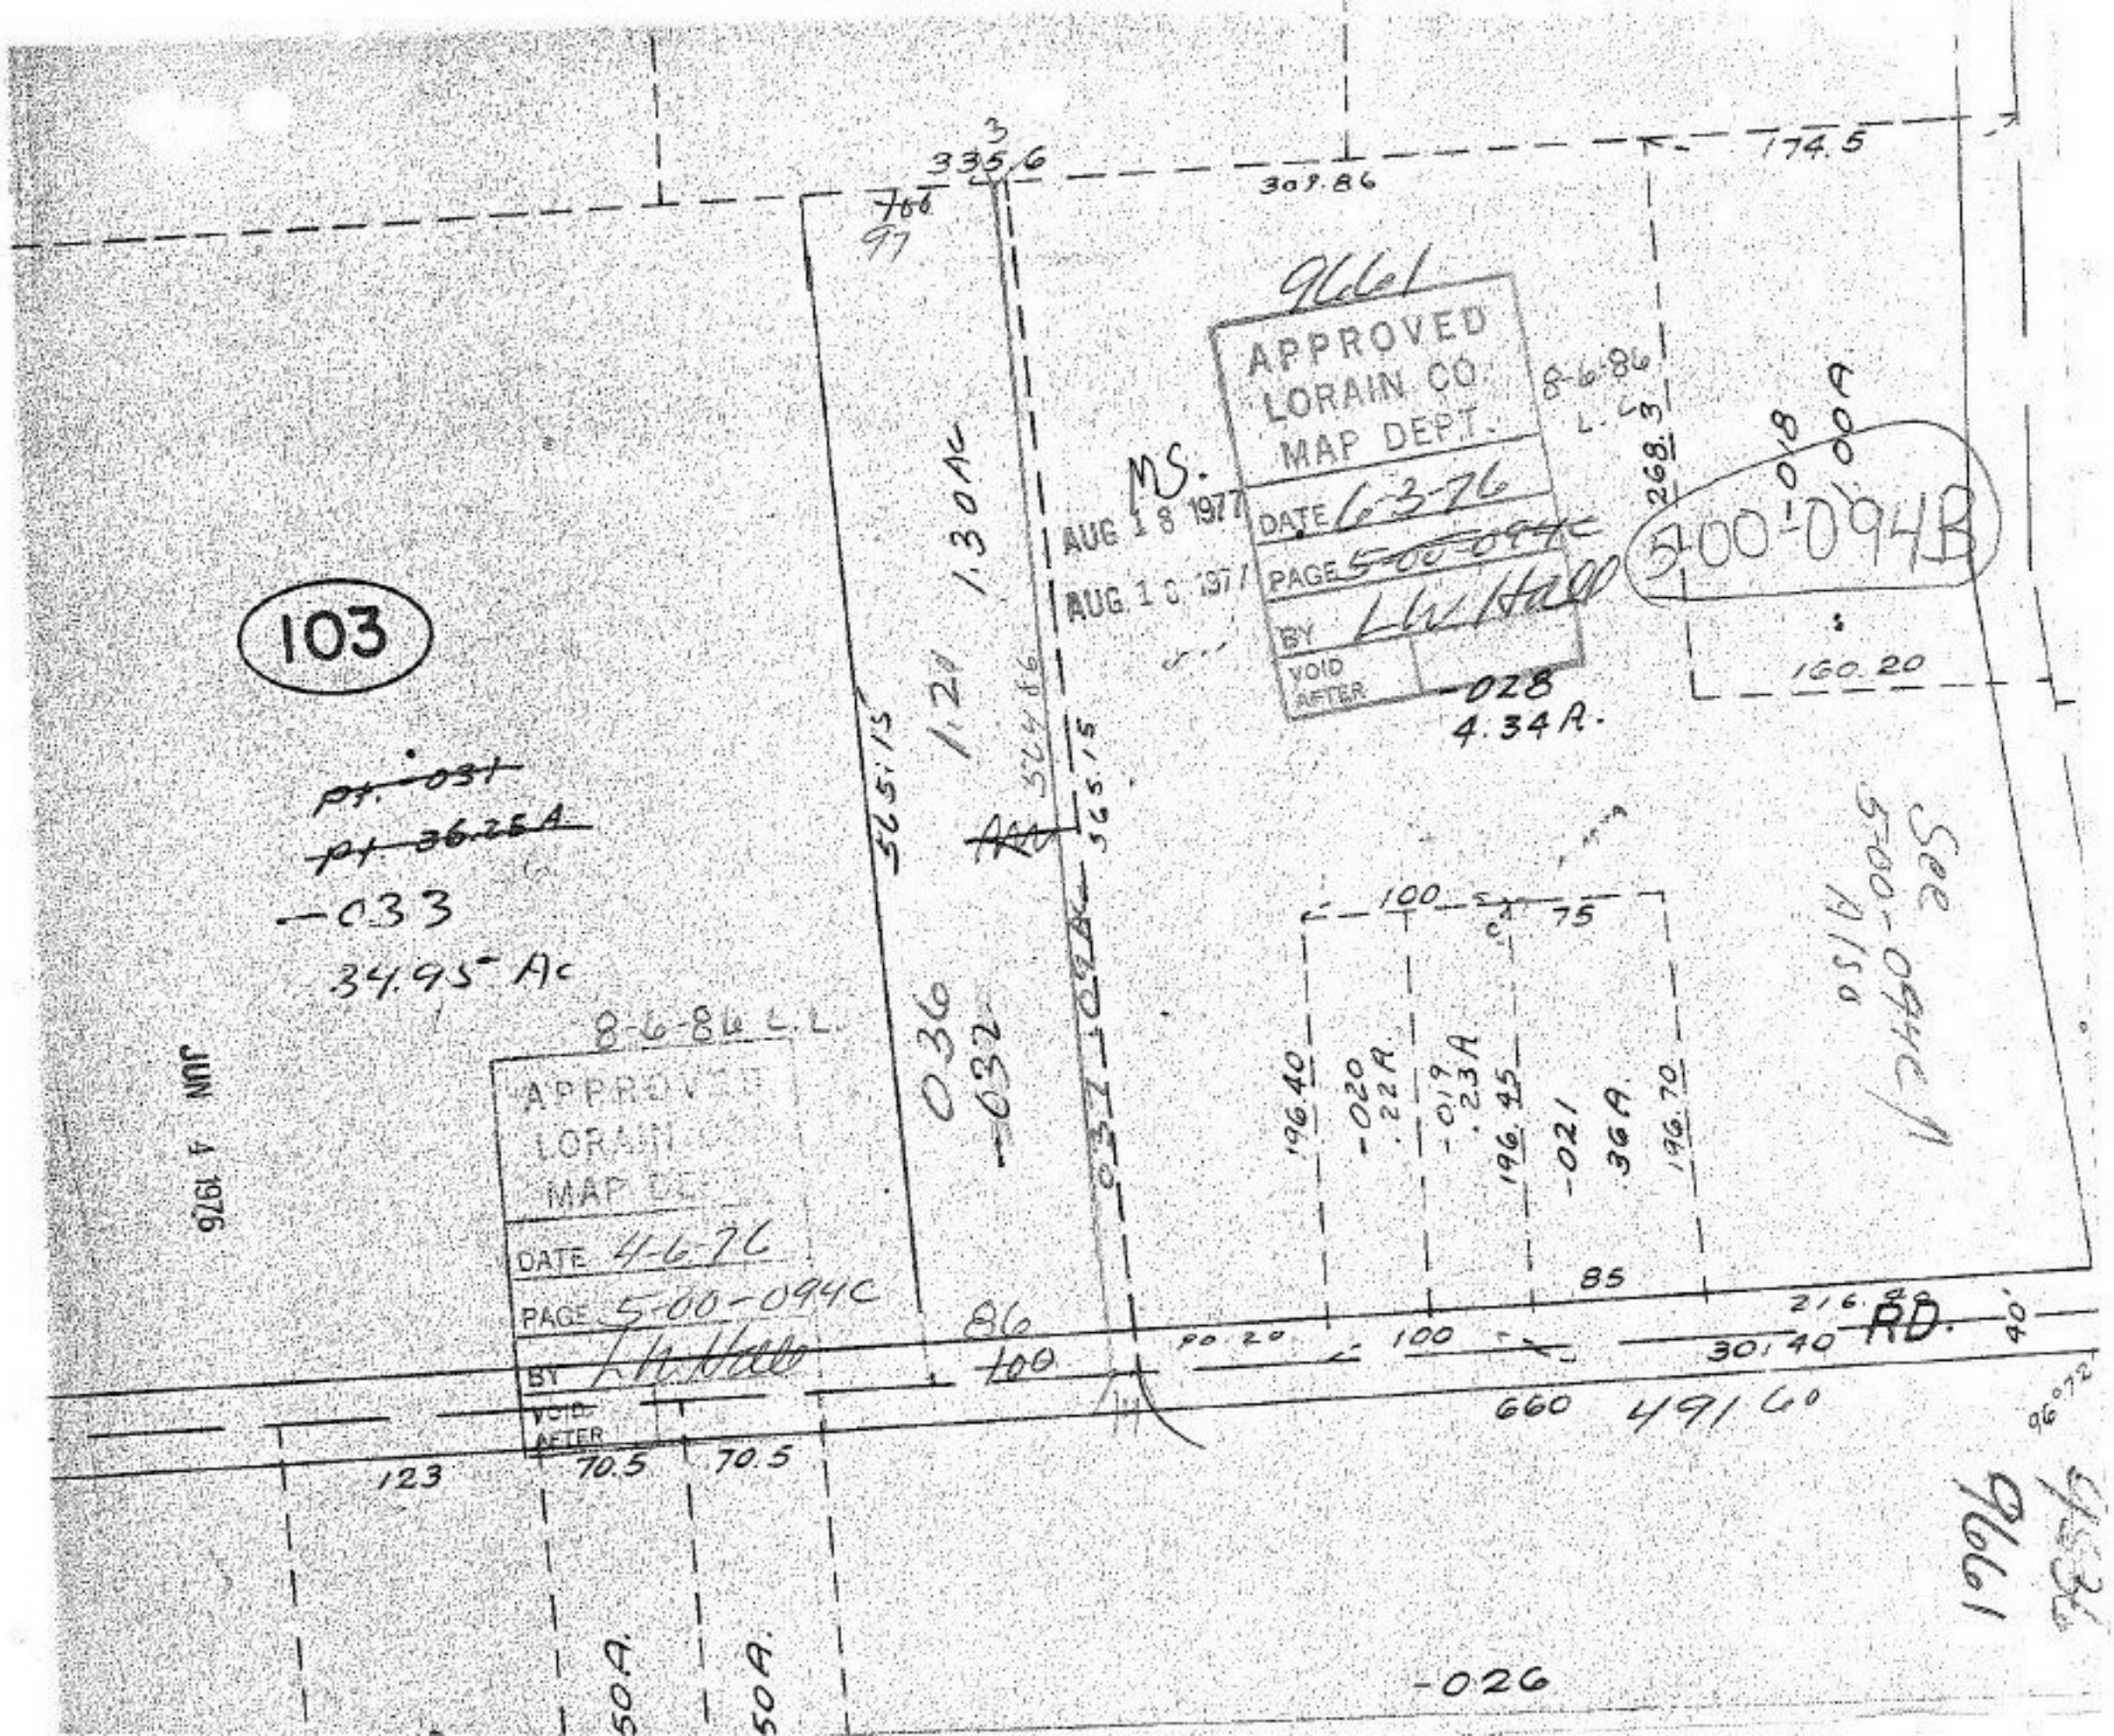
103
JUN 4 1976
~~pt. -031~~
~~pt. 36.25A~~
-033
34.95 Ac
8-6-86 L.L.
APPROVED
LORAIN CO.
MAP DEPT.
DATE 4-6-76
PAGE 5-00-094C
BY L.W. Hall
VOID AFTER
335.6
309.86
174.5
9661
APPROVED
LORAIN CO.
MAP DEPT.
DATE 6-3-76
PAGE ~~5-00-094C~~
BY L.W. Hall
VOID AFTER
MS.
AUG 18 1977
AUG 18 1977
8-6-86
L.L.
268.3
5-00-094B
160.20
-028
4.34A.
1.30 Ac
1.21
565.15
565.15
036
-032
037
100
75
196.40
-020
.22A.
-019
.23A
196.45
-021
.36A.
196.70
See 5-00-094C Also
85
86
100
90.20
100
30.40
RD.
216.80
40'
660
491.60
123
70.5
70.5
-026
50A.
50A.
96.72
9661