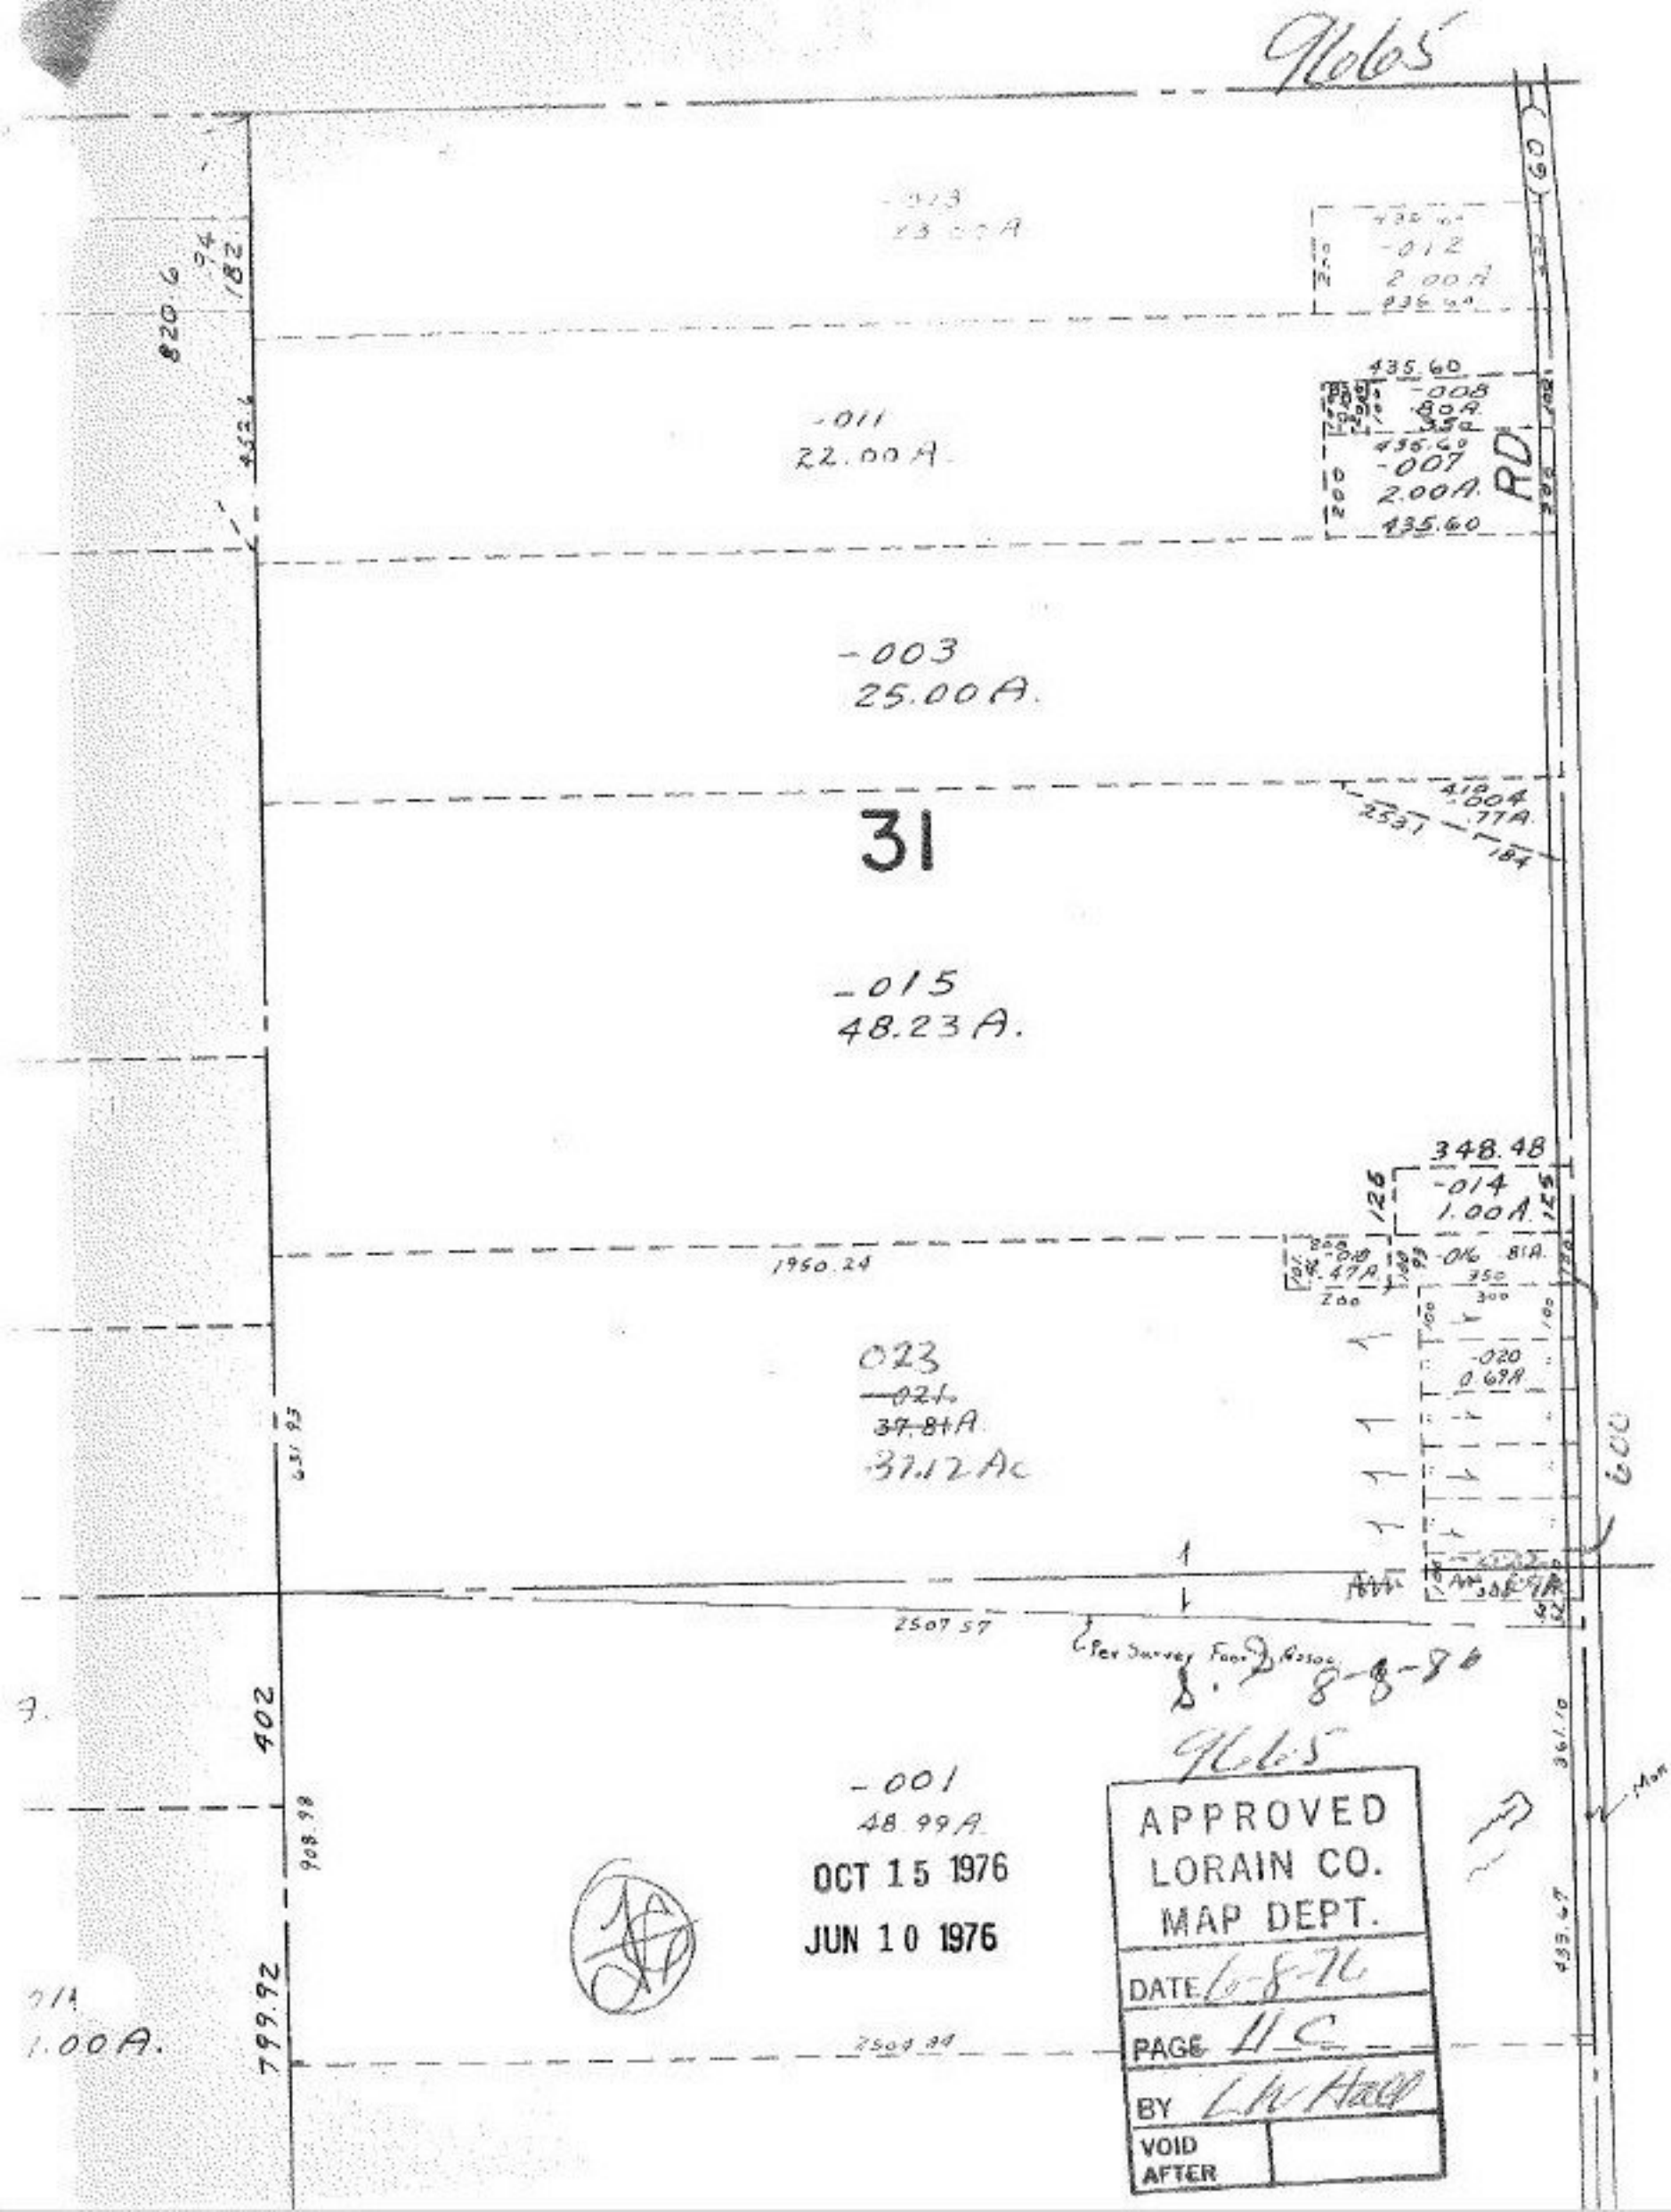

9665
-012
2.00A
435.60
-008
.80A
-007
2.00A
435.60
-011
22.00A
-003
25.00A
31
-015
48.23A
348.48
-014
1.00A
1950.24
023
37.12Ac
-020
0.69A
2507.57
Per Survey Foot Assoc.
8-8-86
9665
-001
48.99A
OCT 15 1976
JUN 10 1976
APPROVED
LORAIN CO.
MAP DEPT.
DATE 6-8-76
PAGE 11C
BY L.W. Hall
VOID AFTER