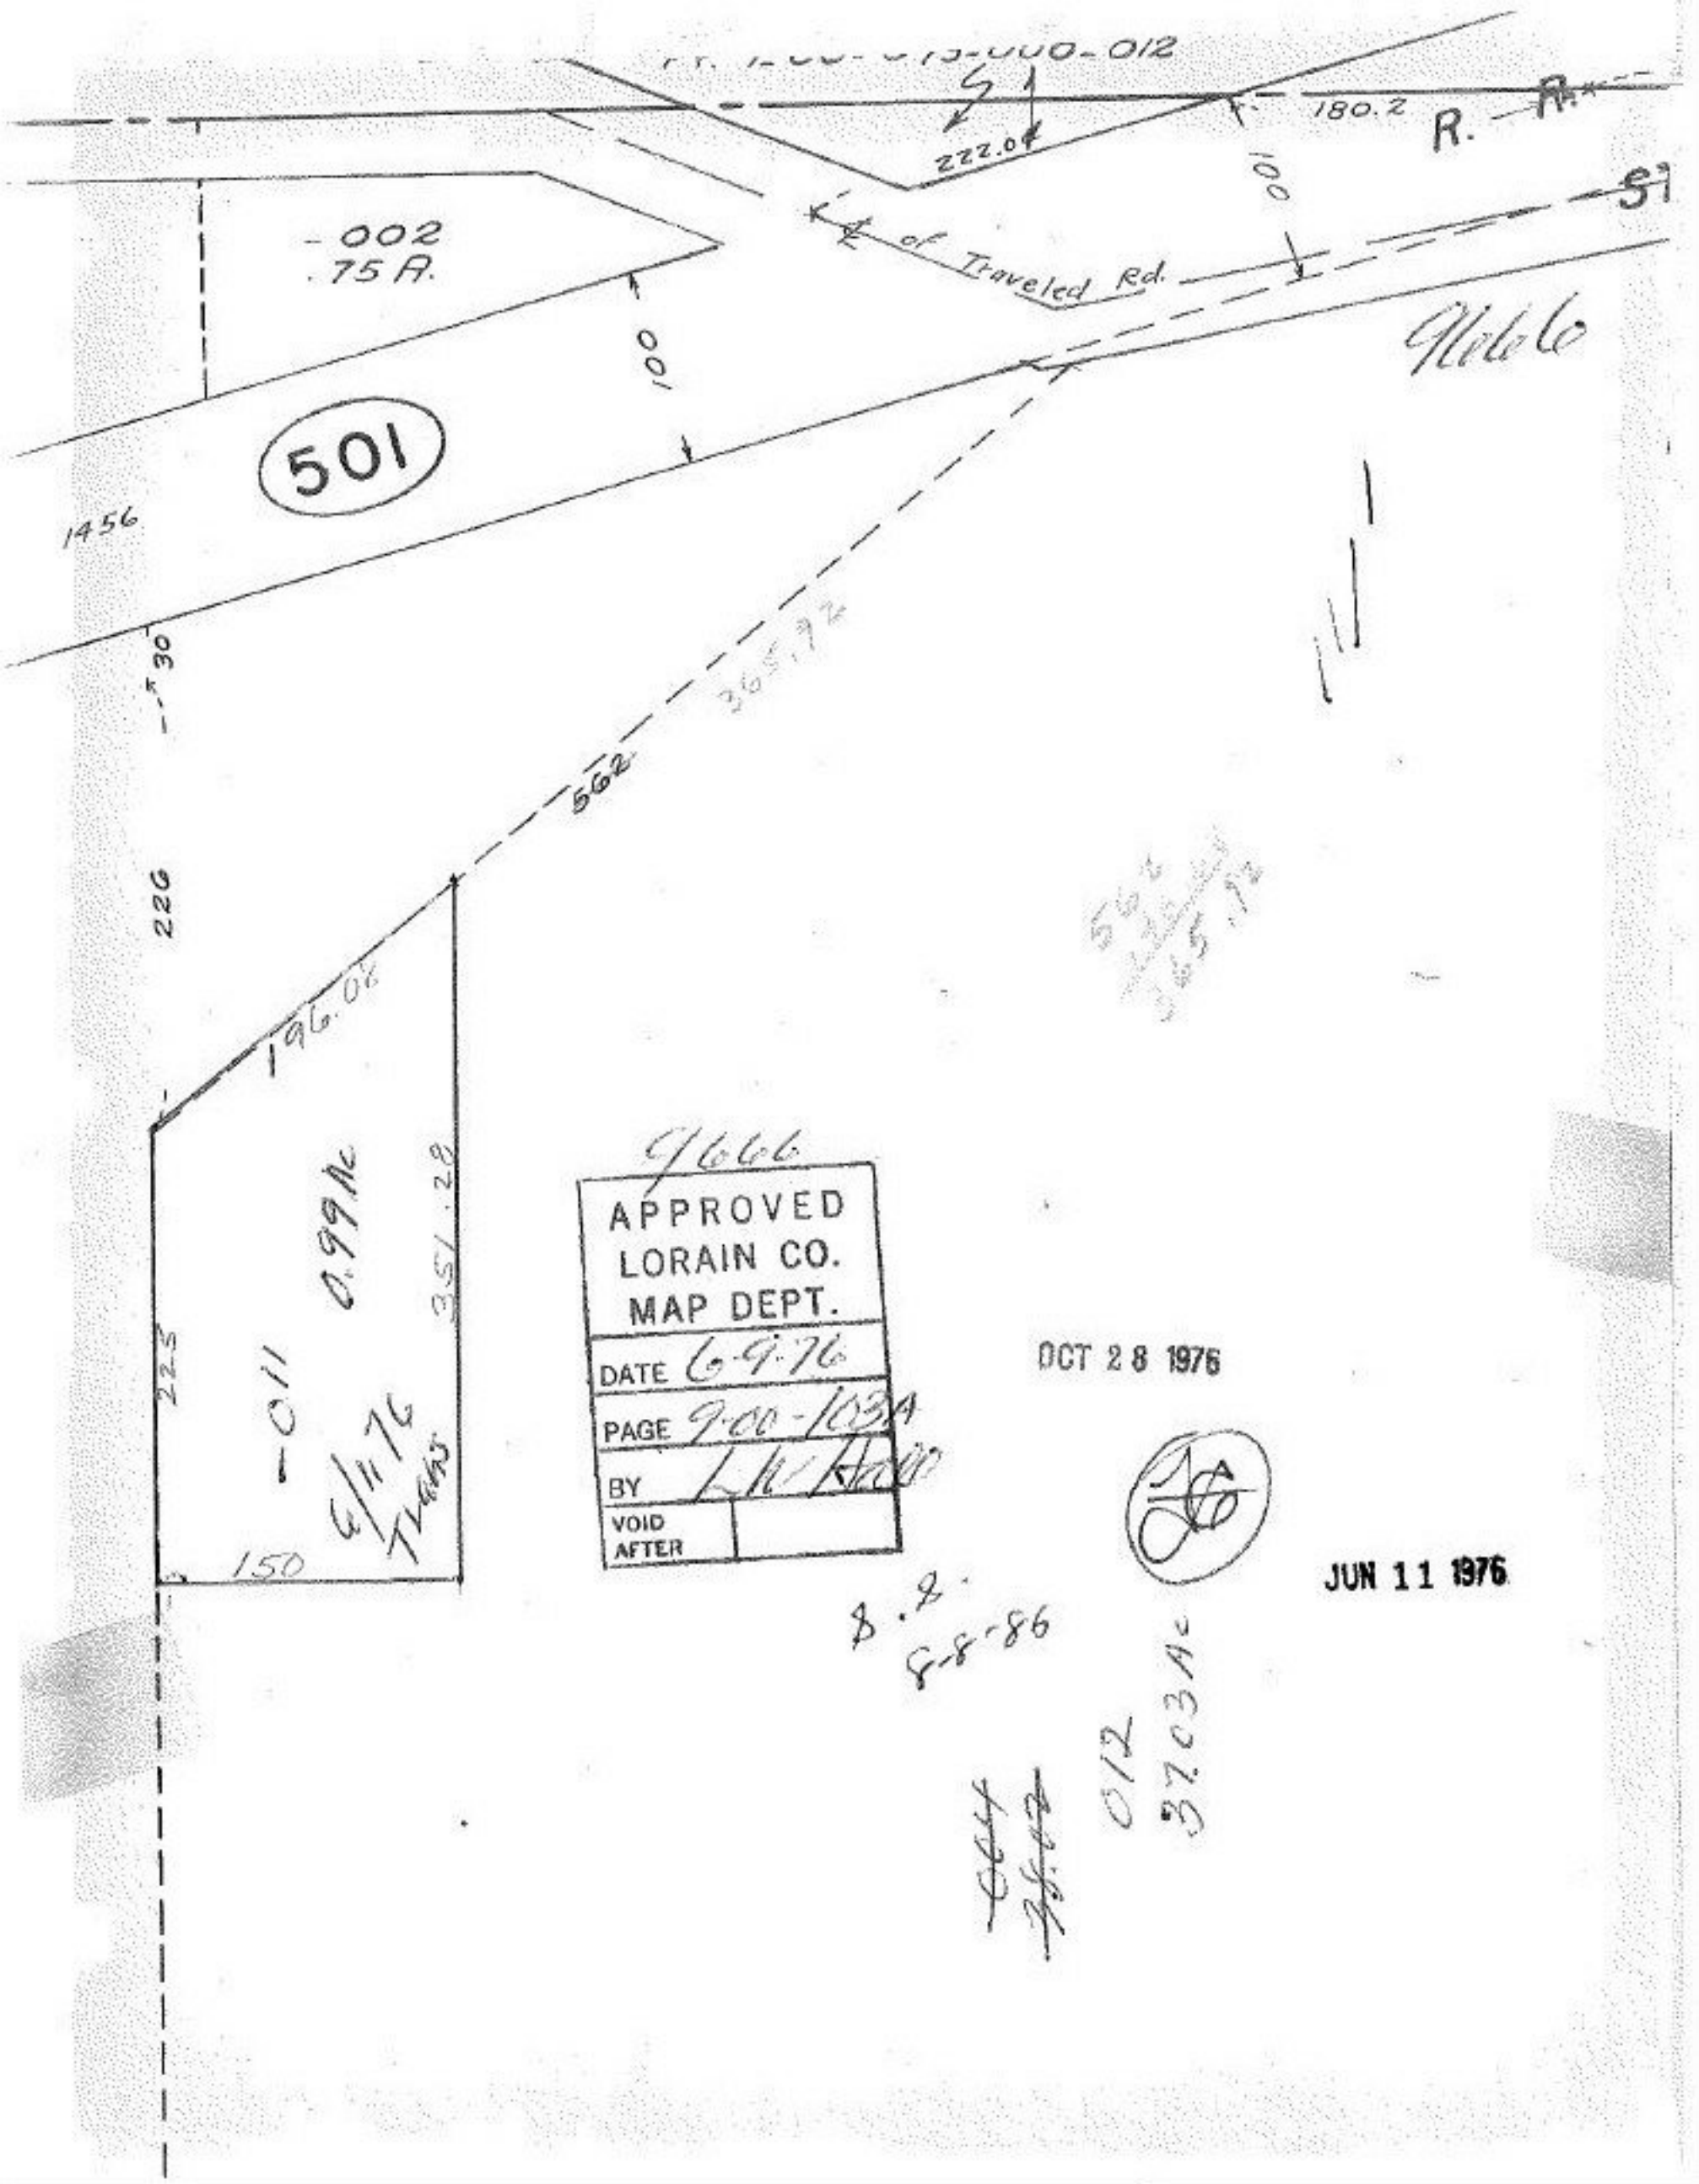

180.2
R.
222.0
100
-002
.75 A.
℄ of Traveled Rd.
100
501
1456
30
562
365.92
226
196.08
0.99 Ac
351.28
225
-011
6/11/76
150
9666
APPROVED
LORAIN CO.
MAP DEPT.
DATE 6-9-76
PAGE 9-00-103A
BY
VOID
AFTER
OCT 28 1976
JUN 11 1976
8-8-86
012
37.03 Ac