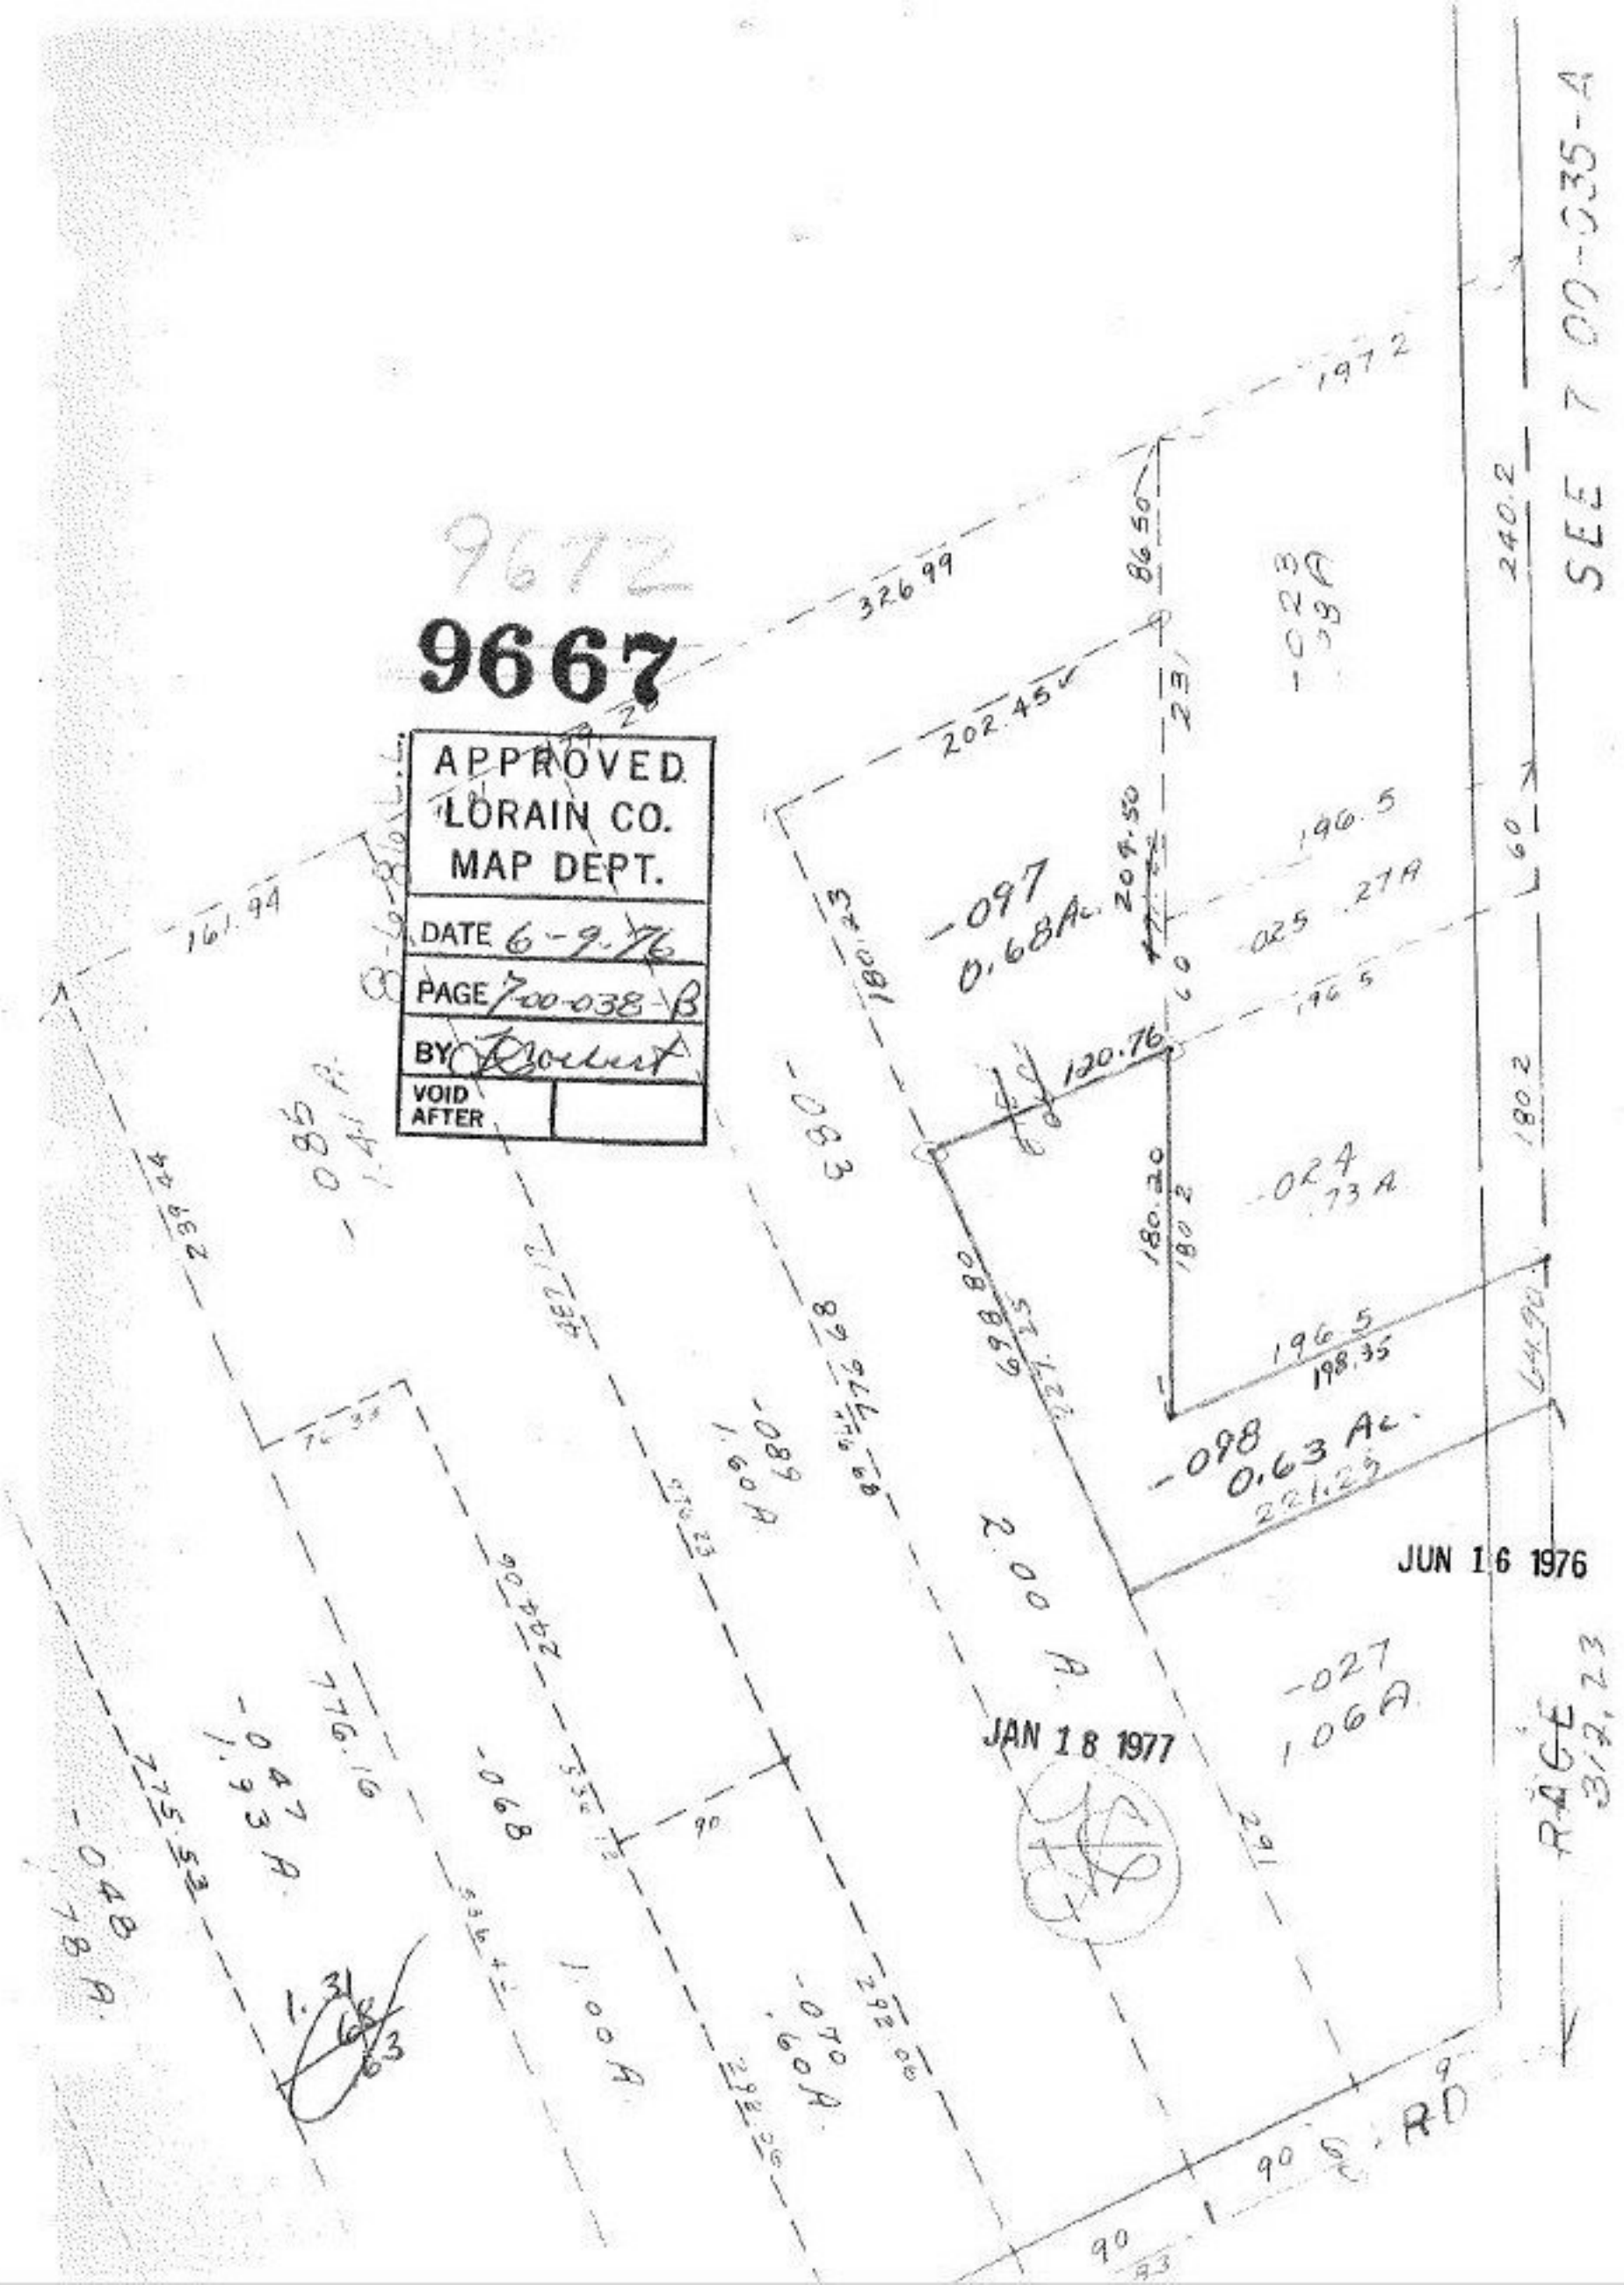
9672
9667
APPROVED
LORAIN CO.
MAP DEPT.
DATE 6-9-76
PAGE 7-00-038-B
BY
VOID AFTER
SEE 7-00-035-A
JUN 16 1976
JAN 18 1977
RAGE 312.23
-097
0.68 Ac.
-098
0.63 Ac.
-027
1.06 A.
-024
.73 A
-089
1.60 A
-068
1.00 A
-070
.60 A
-047
1.93 A
-048
.78 A
-085
1.41 A
-083
2.00 A.
-023
.98 A
-025
.27 A
-024
.73 A
326.99
202.45
197.2
161.94
196.5
120.76
198.35
221.25
240.2
180.2
RD