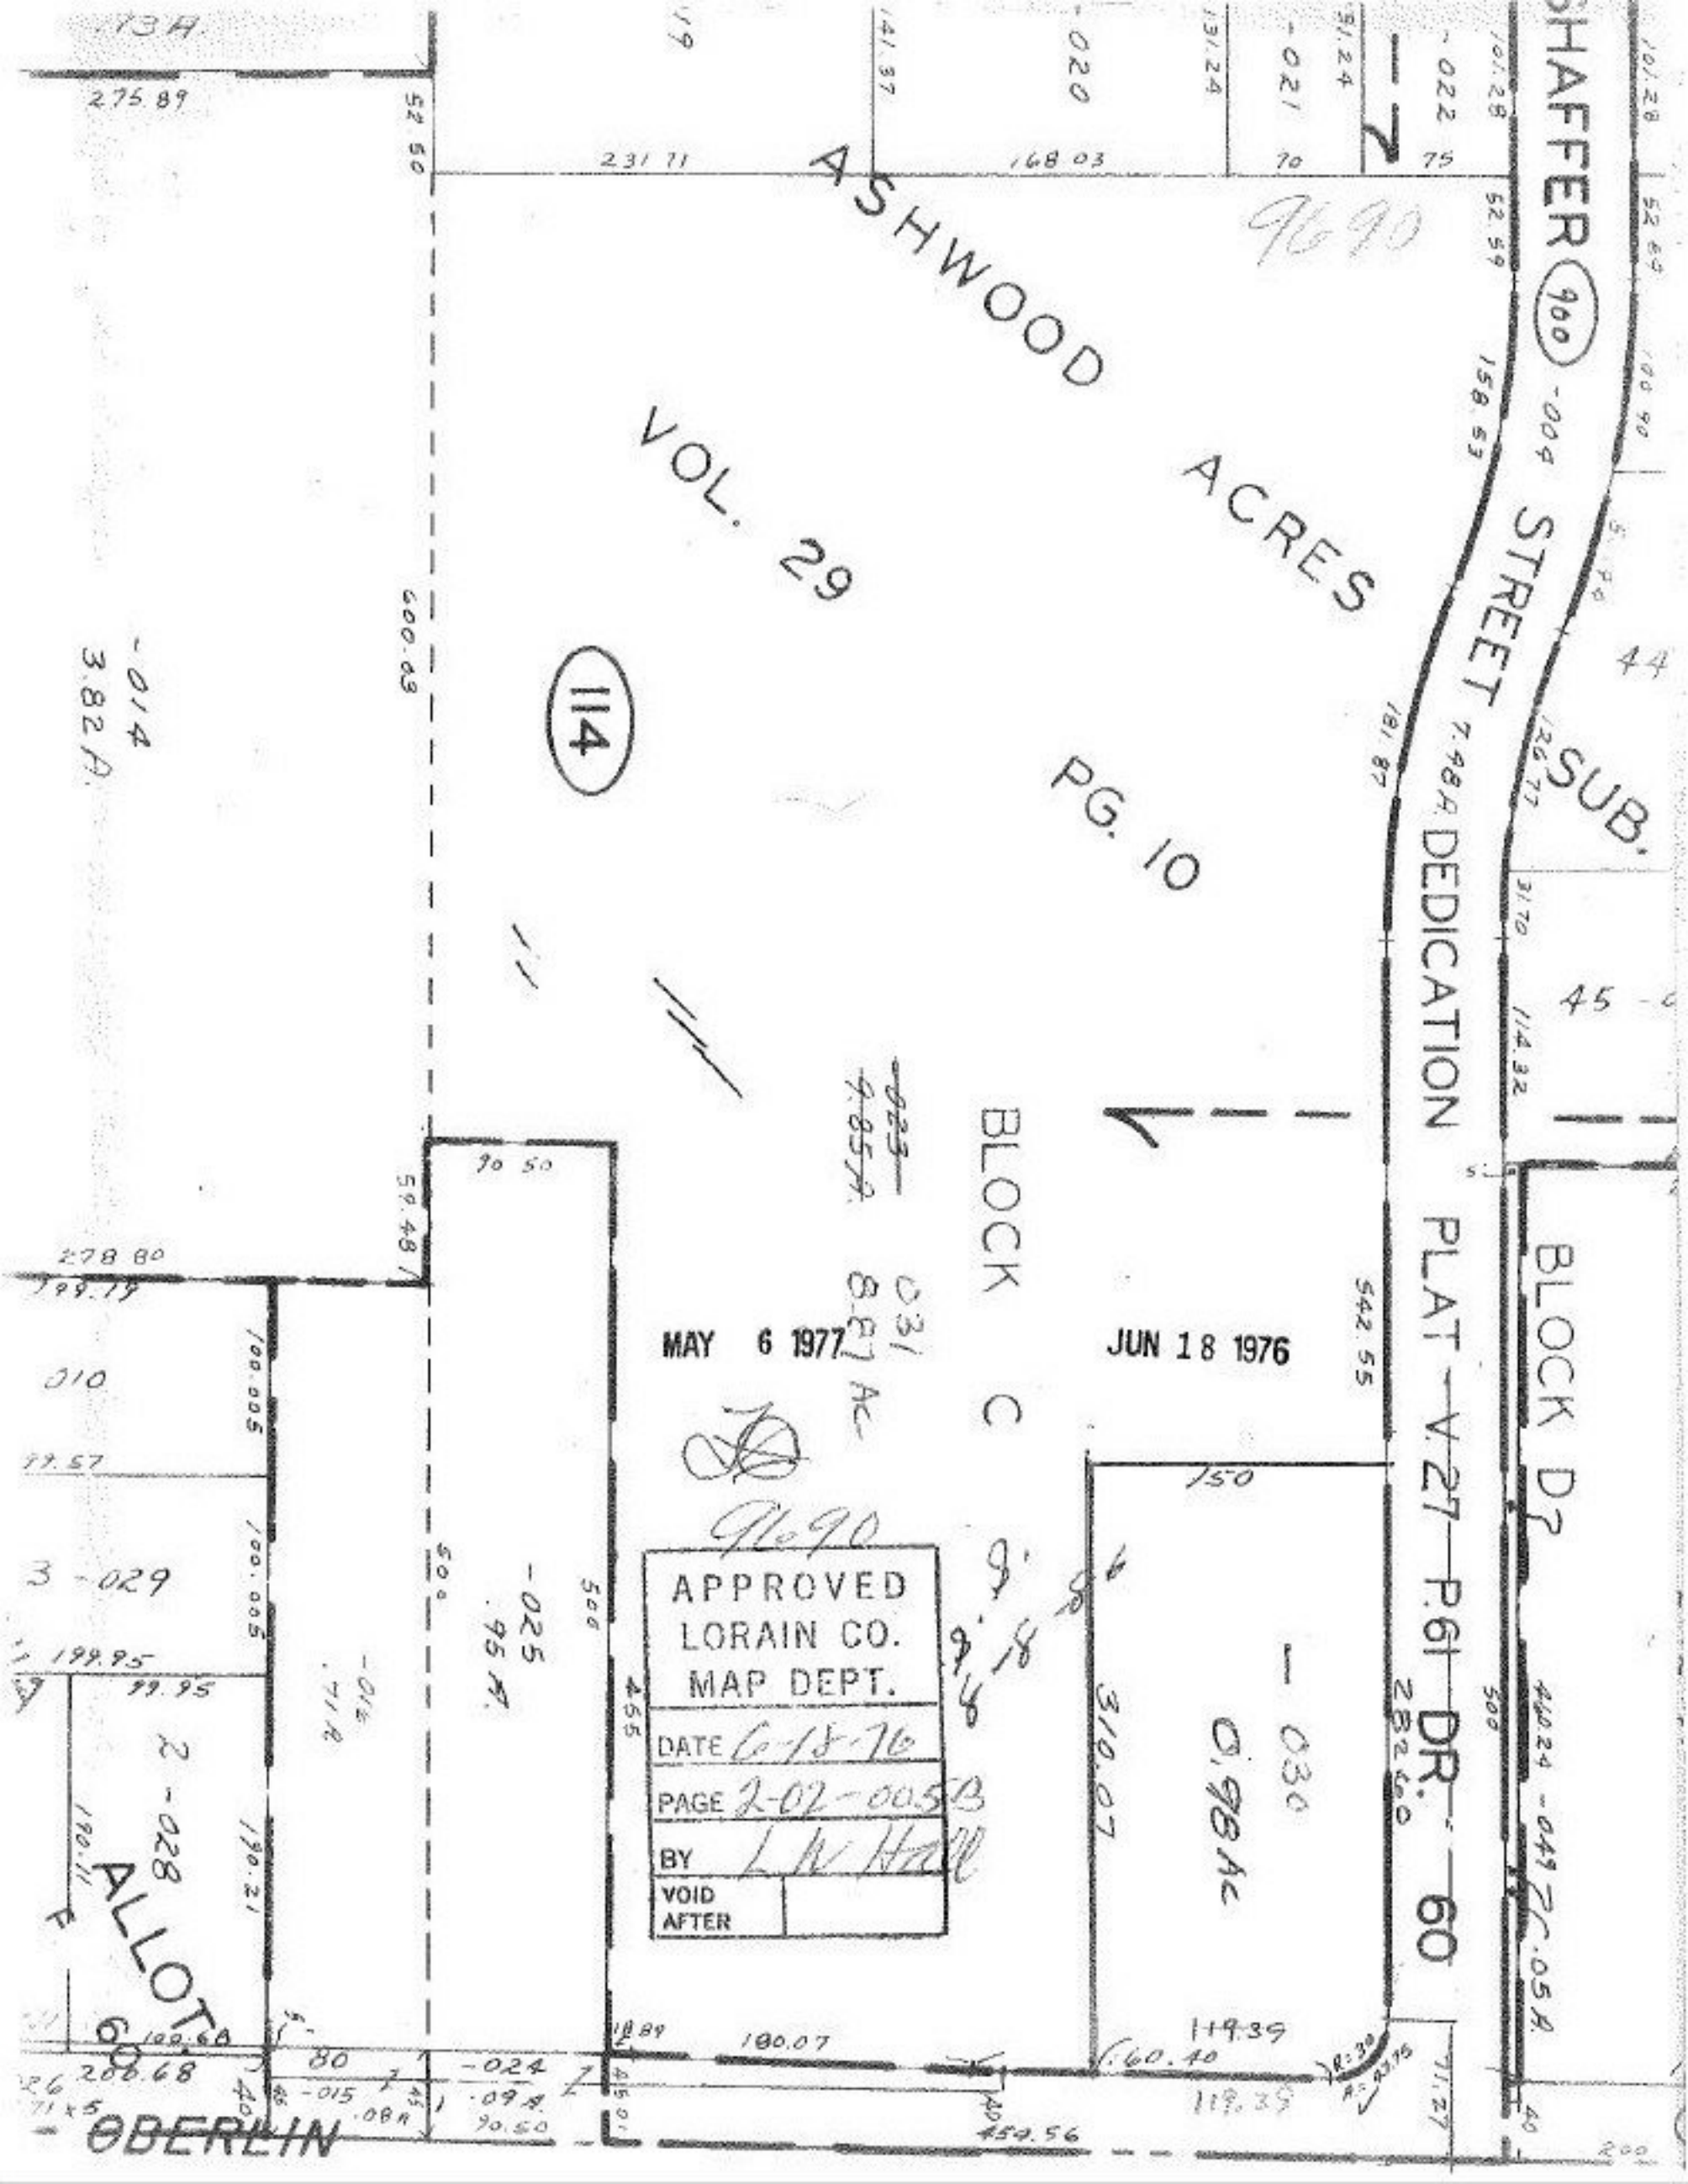

SHAFFER
900
-004
STREET
SUB.
DEDICATION PLAT V.27 P.61 DR. 60
BLOCK D
ASHWOOD ACRES
VOL. 29
PG. 10
114
BLOCK C
MAY 6 1977
JUN 18 1976
9690
APPROVED
LORAIN CO.
MAP DEPT.
DATE 6-18-76
PAGE 2-02-005B
BY L.W. Hall
VOID AFTER
ALLOT 60
OBERLIN
-014
3.82 A.
-030
0.98 Ac
-025
.95 A.
-016
.71 A.
-024
.09 A.
-015
.08 A.
-020
-021
-022
-004
-023
9.85 A.
031
8.87 Ac
3-029
2-028
-014
-049
-05 A.