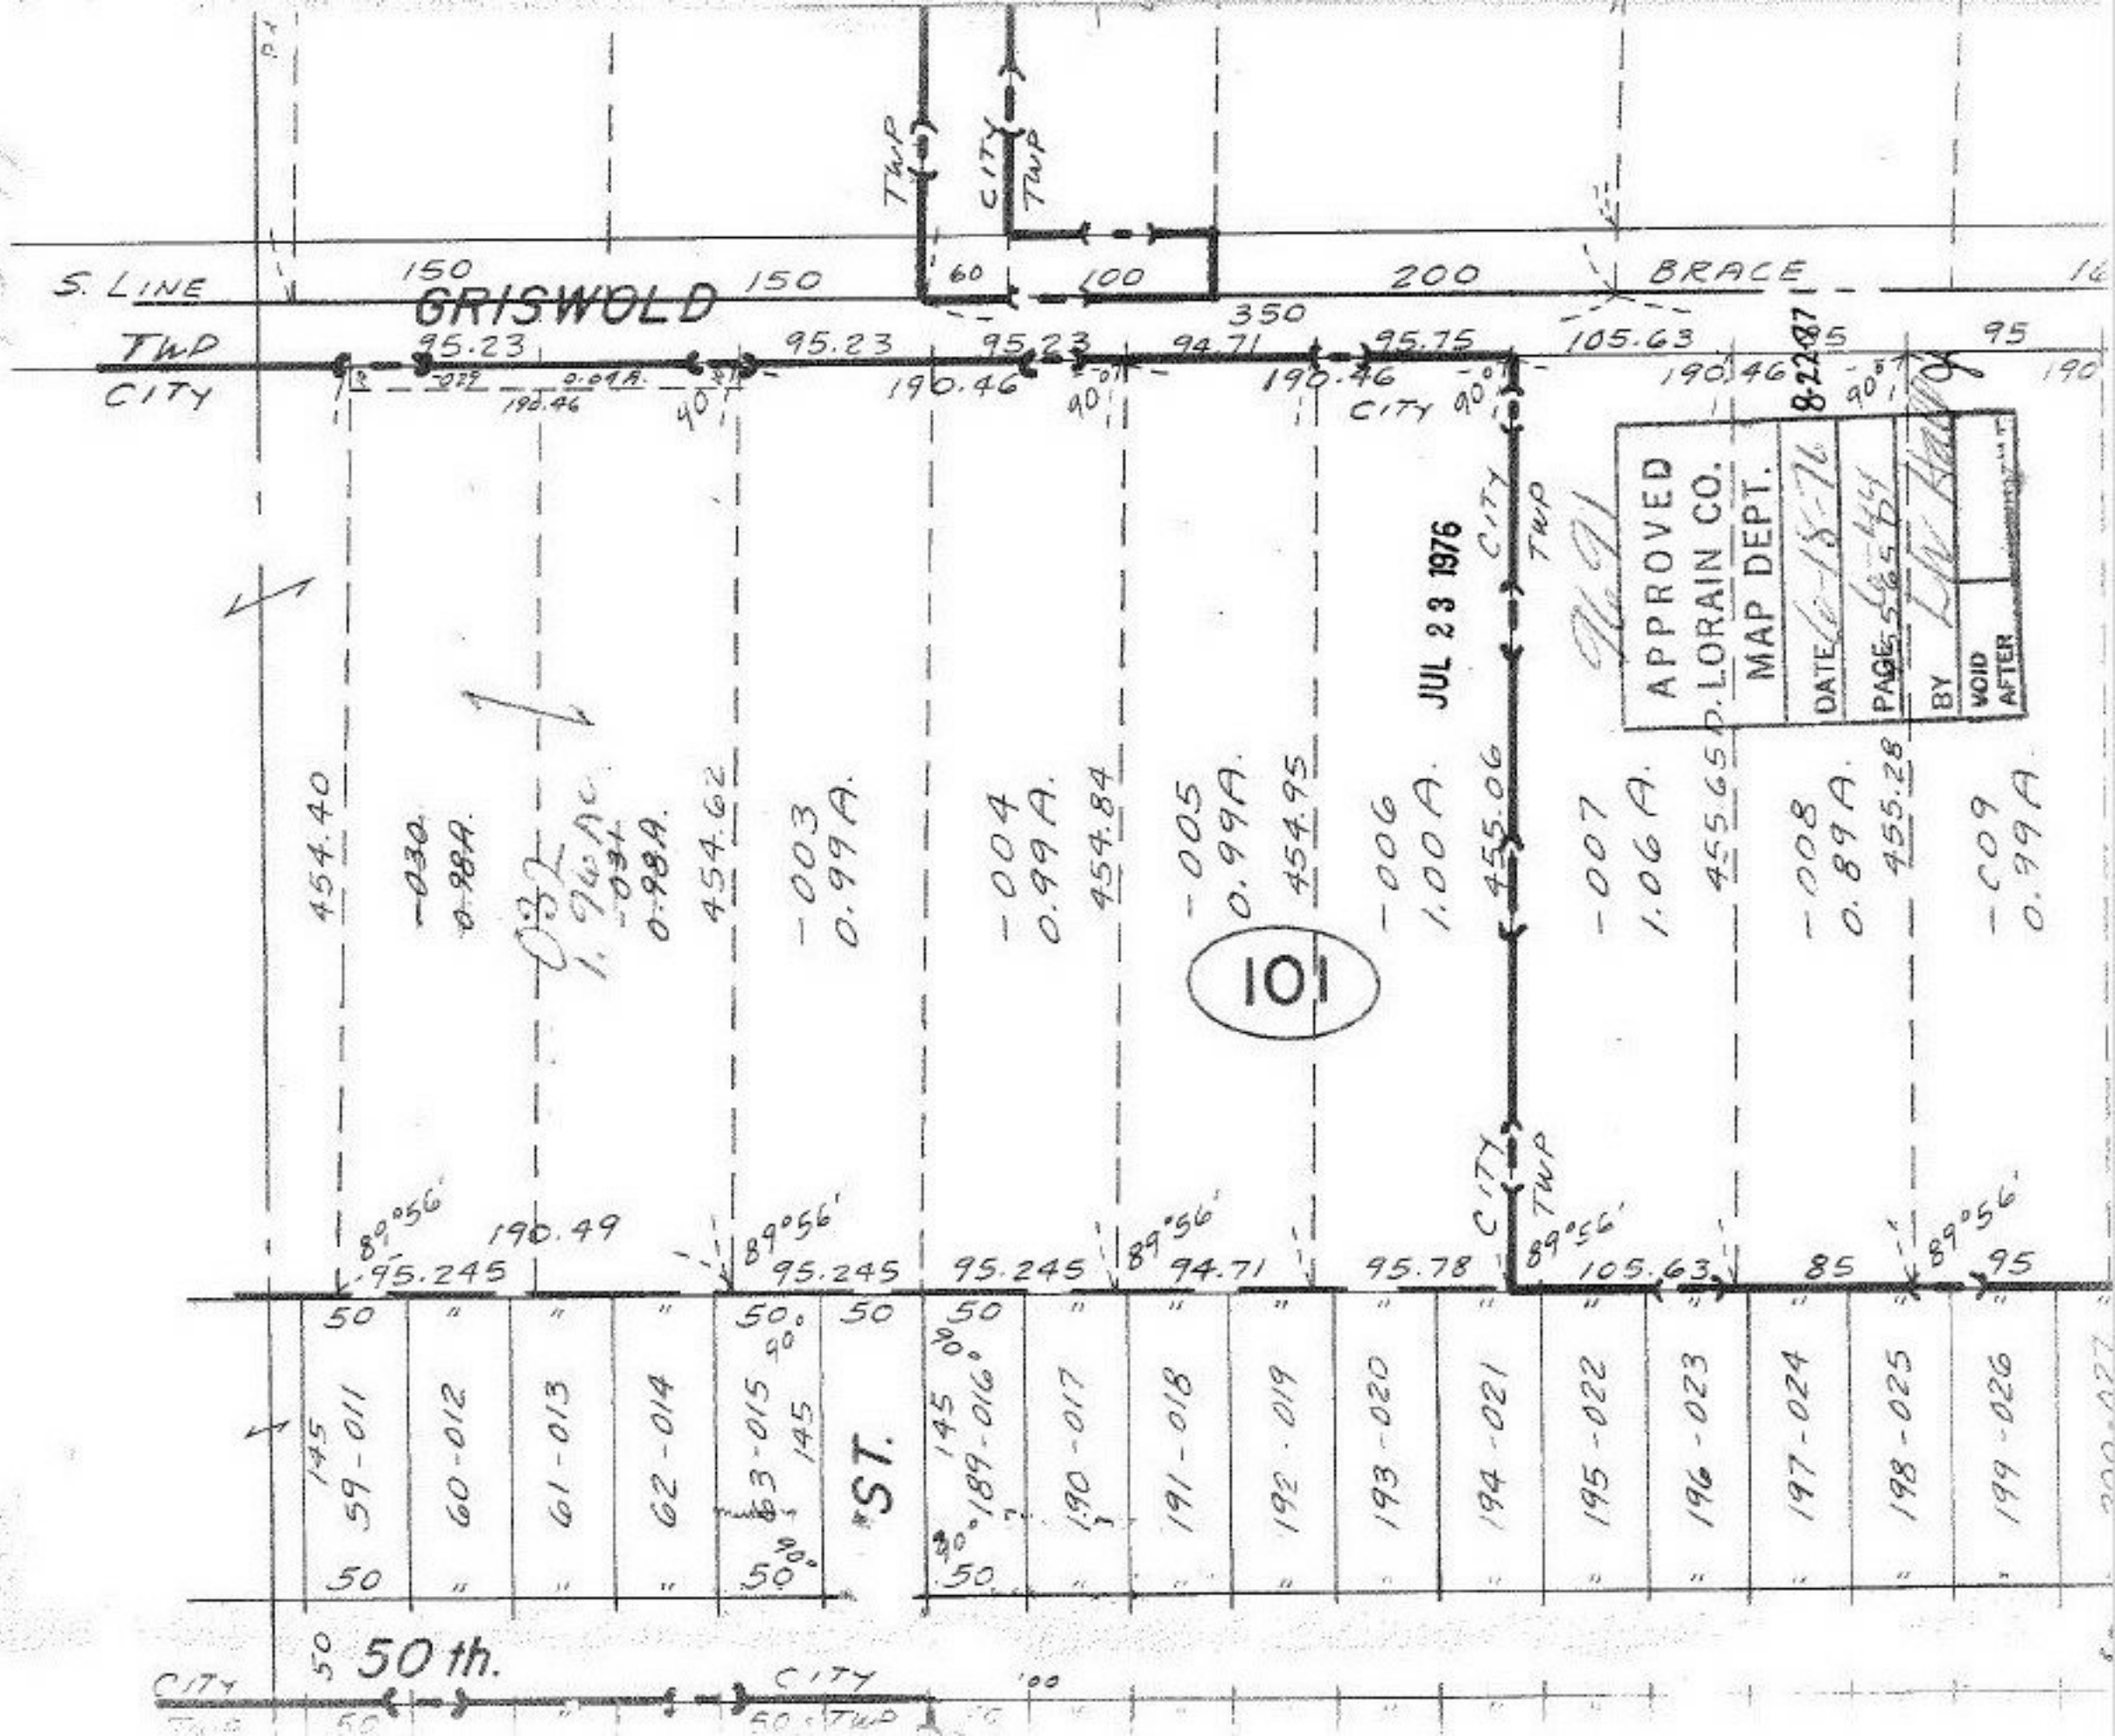

S. LINE
GRISWOLD
TWP
CITY
150
150
60
100
200
BRACE
350
95.23
95.23
95.23
94.71
95.75
105.63
190.46
190.46
190.46
190.46
95
95
190
TWP
CITY
TWP
CITY
TWP
CITY
TWP
CITY
TWP
JUL 23 1976
APPROVED
LORAIN CO.
MAP DEPT.
DATE
PAGE
BY
VOID AFTER
8-22-87
454.40
454.62
454.84
454.95
455.06
455.65
455.28
-030
0.98A.
-031
0.98A.
-003
0.99A.
-004
0.99A.
-005
0.99A.
-006
1.00A.
-007
1.06A.
-008
0.89A.
-009
0.99A.
101
89°56'
190.49
95.245
95.245
95.245
94.71
95.78
105.63
85
95
50
145
59-011
60-012
61-013
62-014
63-015
ST.
189-016
190-017
191-018
192-019
193-020
194-021
195-022
196-023
197-024
198-025
199-026
50th.
CITY
CITY
TWP