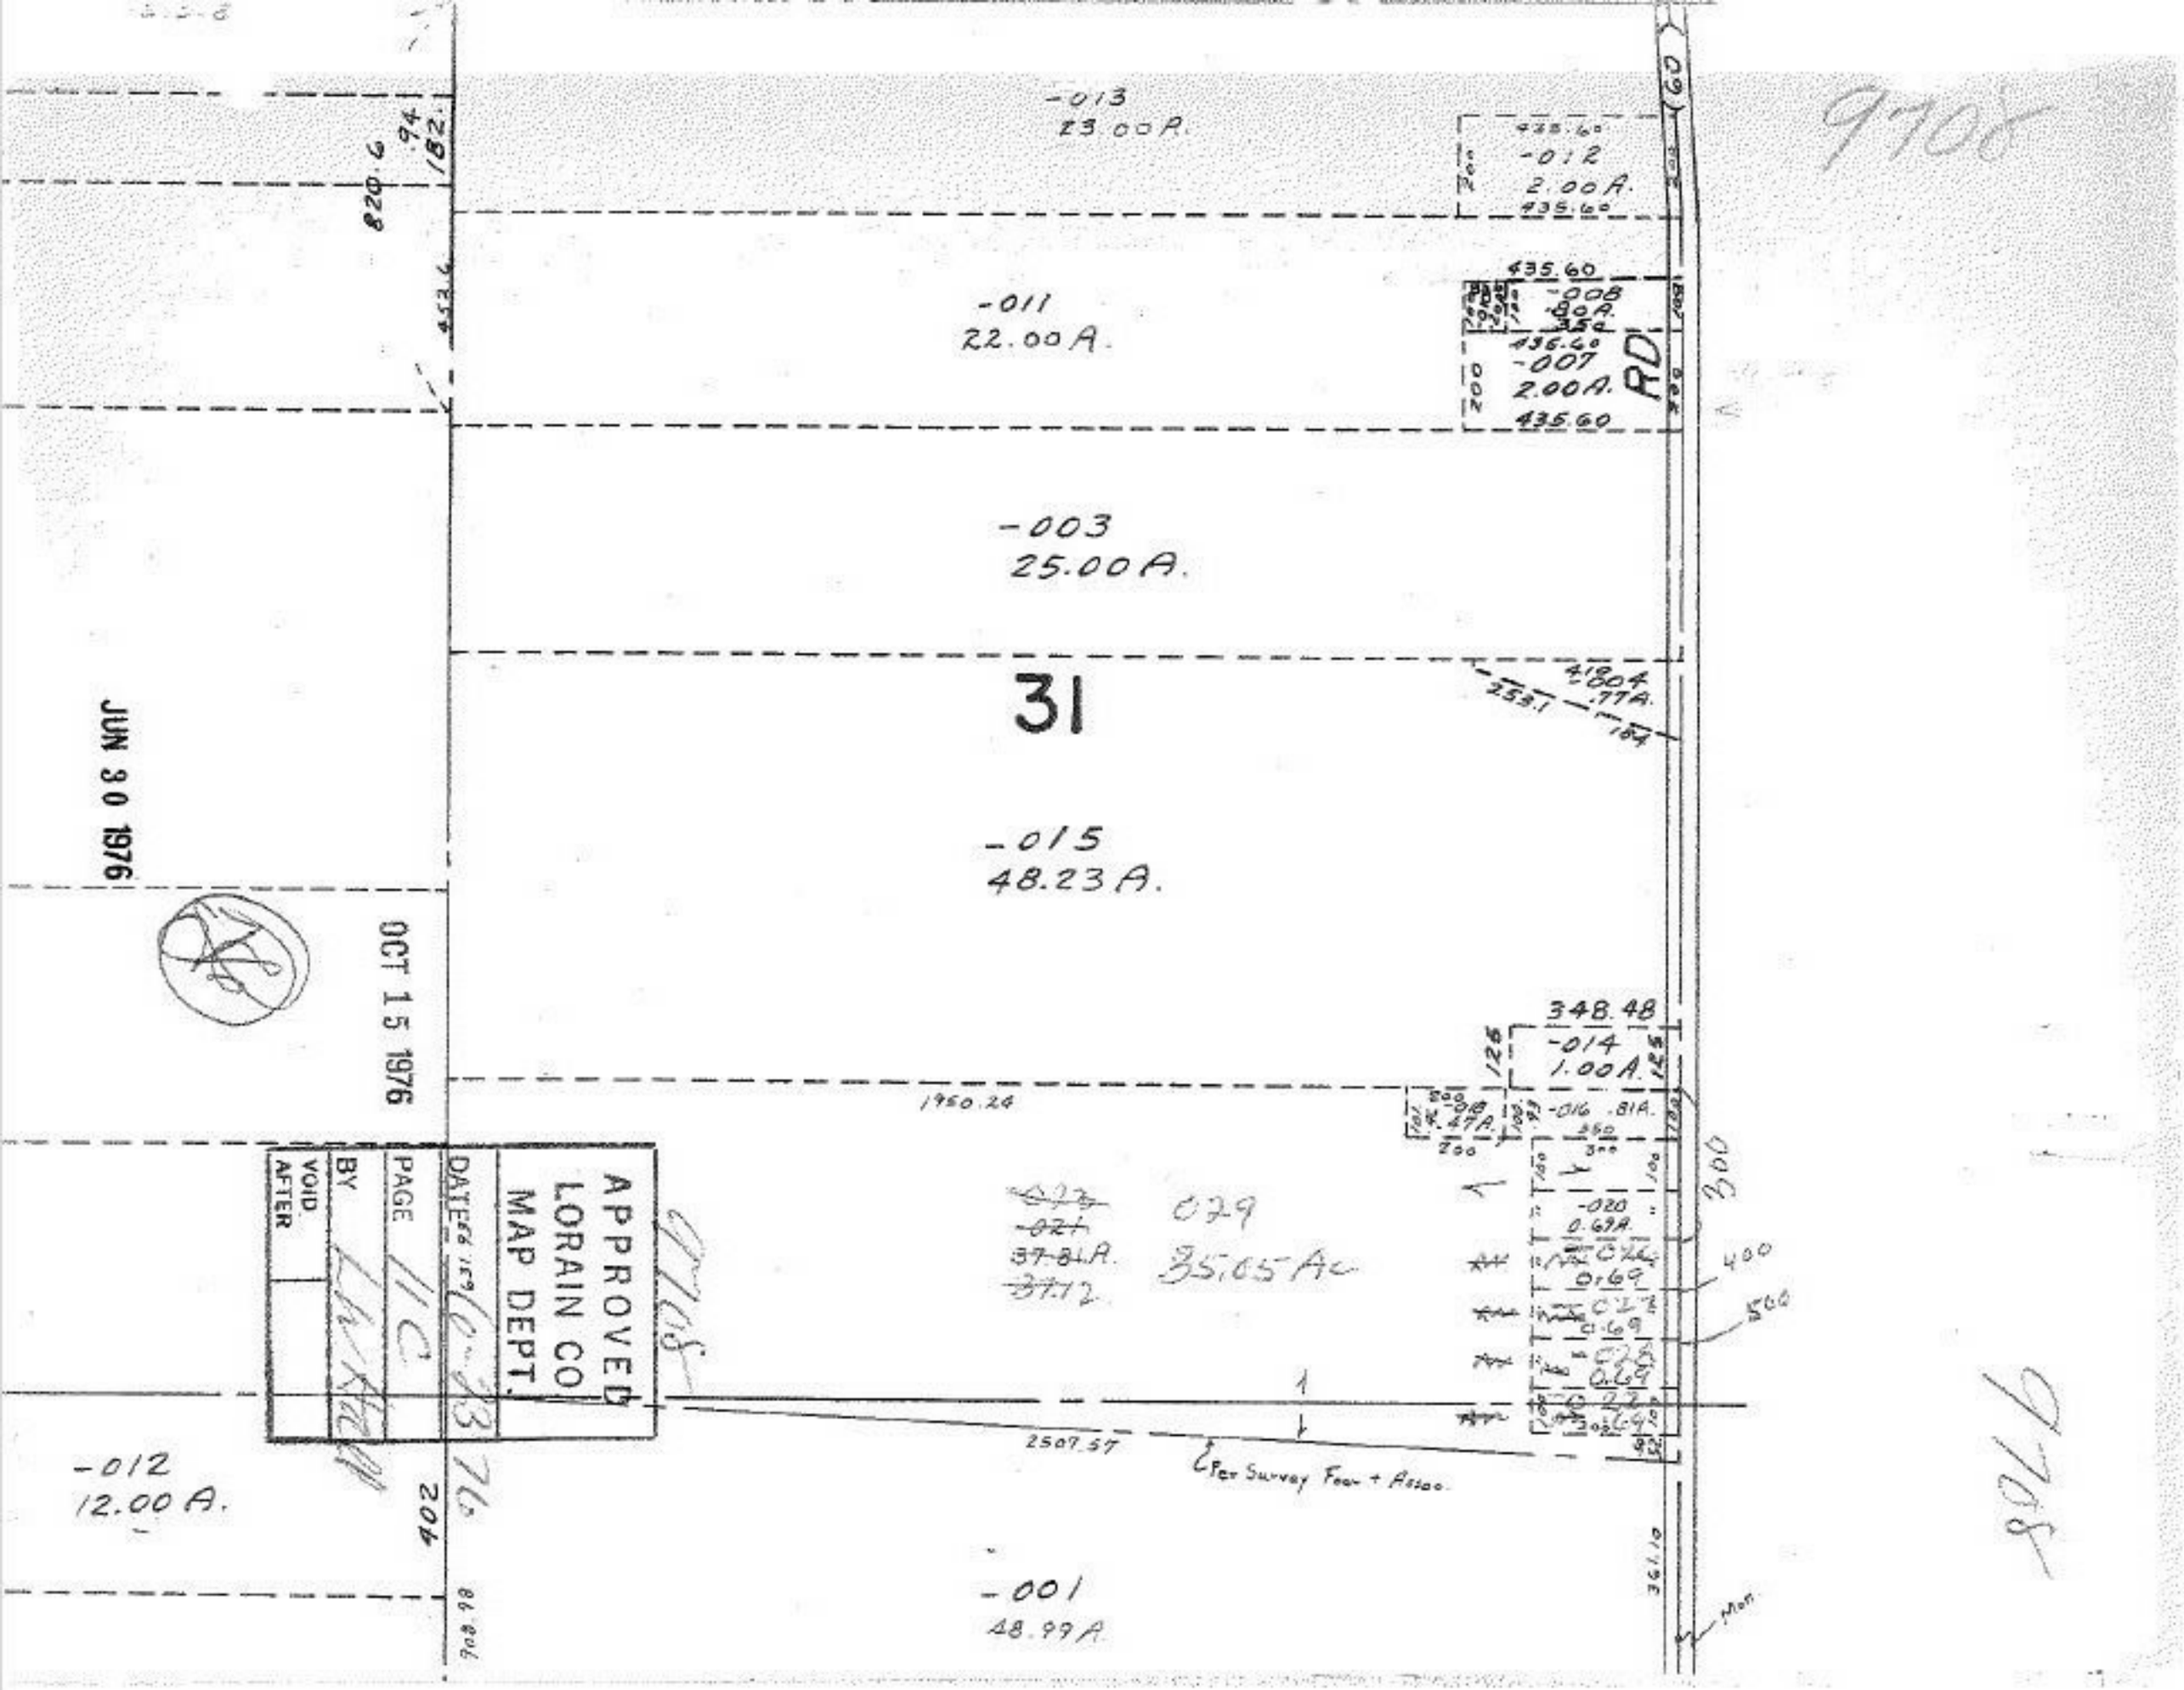

9708
-013
23.00 A.
-012
2.00 A.
435.60
-011
22.00 A.
-008
.80 A.
-007
2.00 A.
RD
-003
25.00 A.
31
-015
48.23 A.
348.48
-014
1.00 A.
1950.24
-016 .81 A.
-020
0.69 A.
029
35.05 Ac
2507.57
Per Survey Fear + Assoc.
-012
12.00 A.
-001
48.99 A.
JUN 30 1976
OCT 15 1976
APPROVED
LORAIN CO
MAP DEPT.
DATE
PAGE
BY
VOID
AFTER