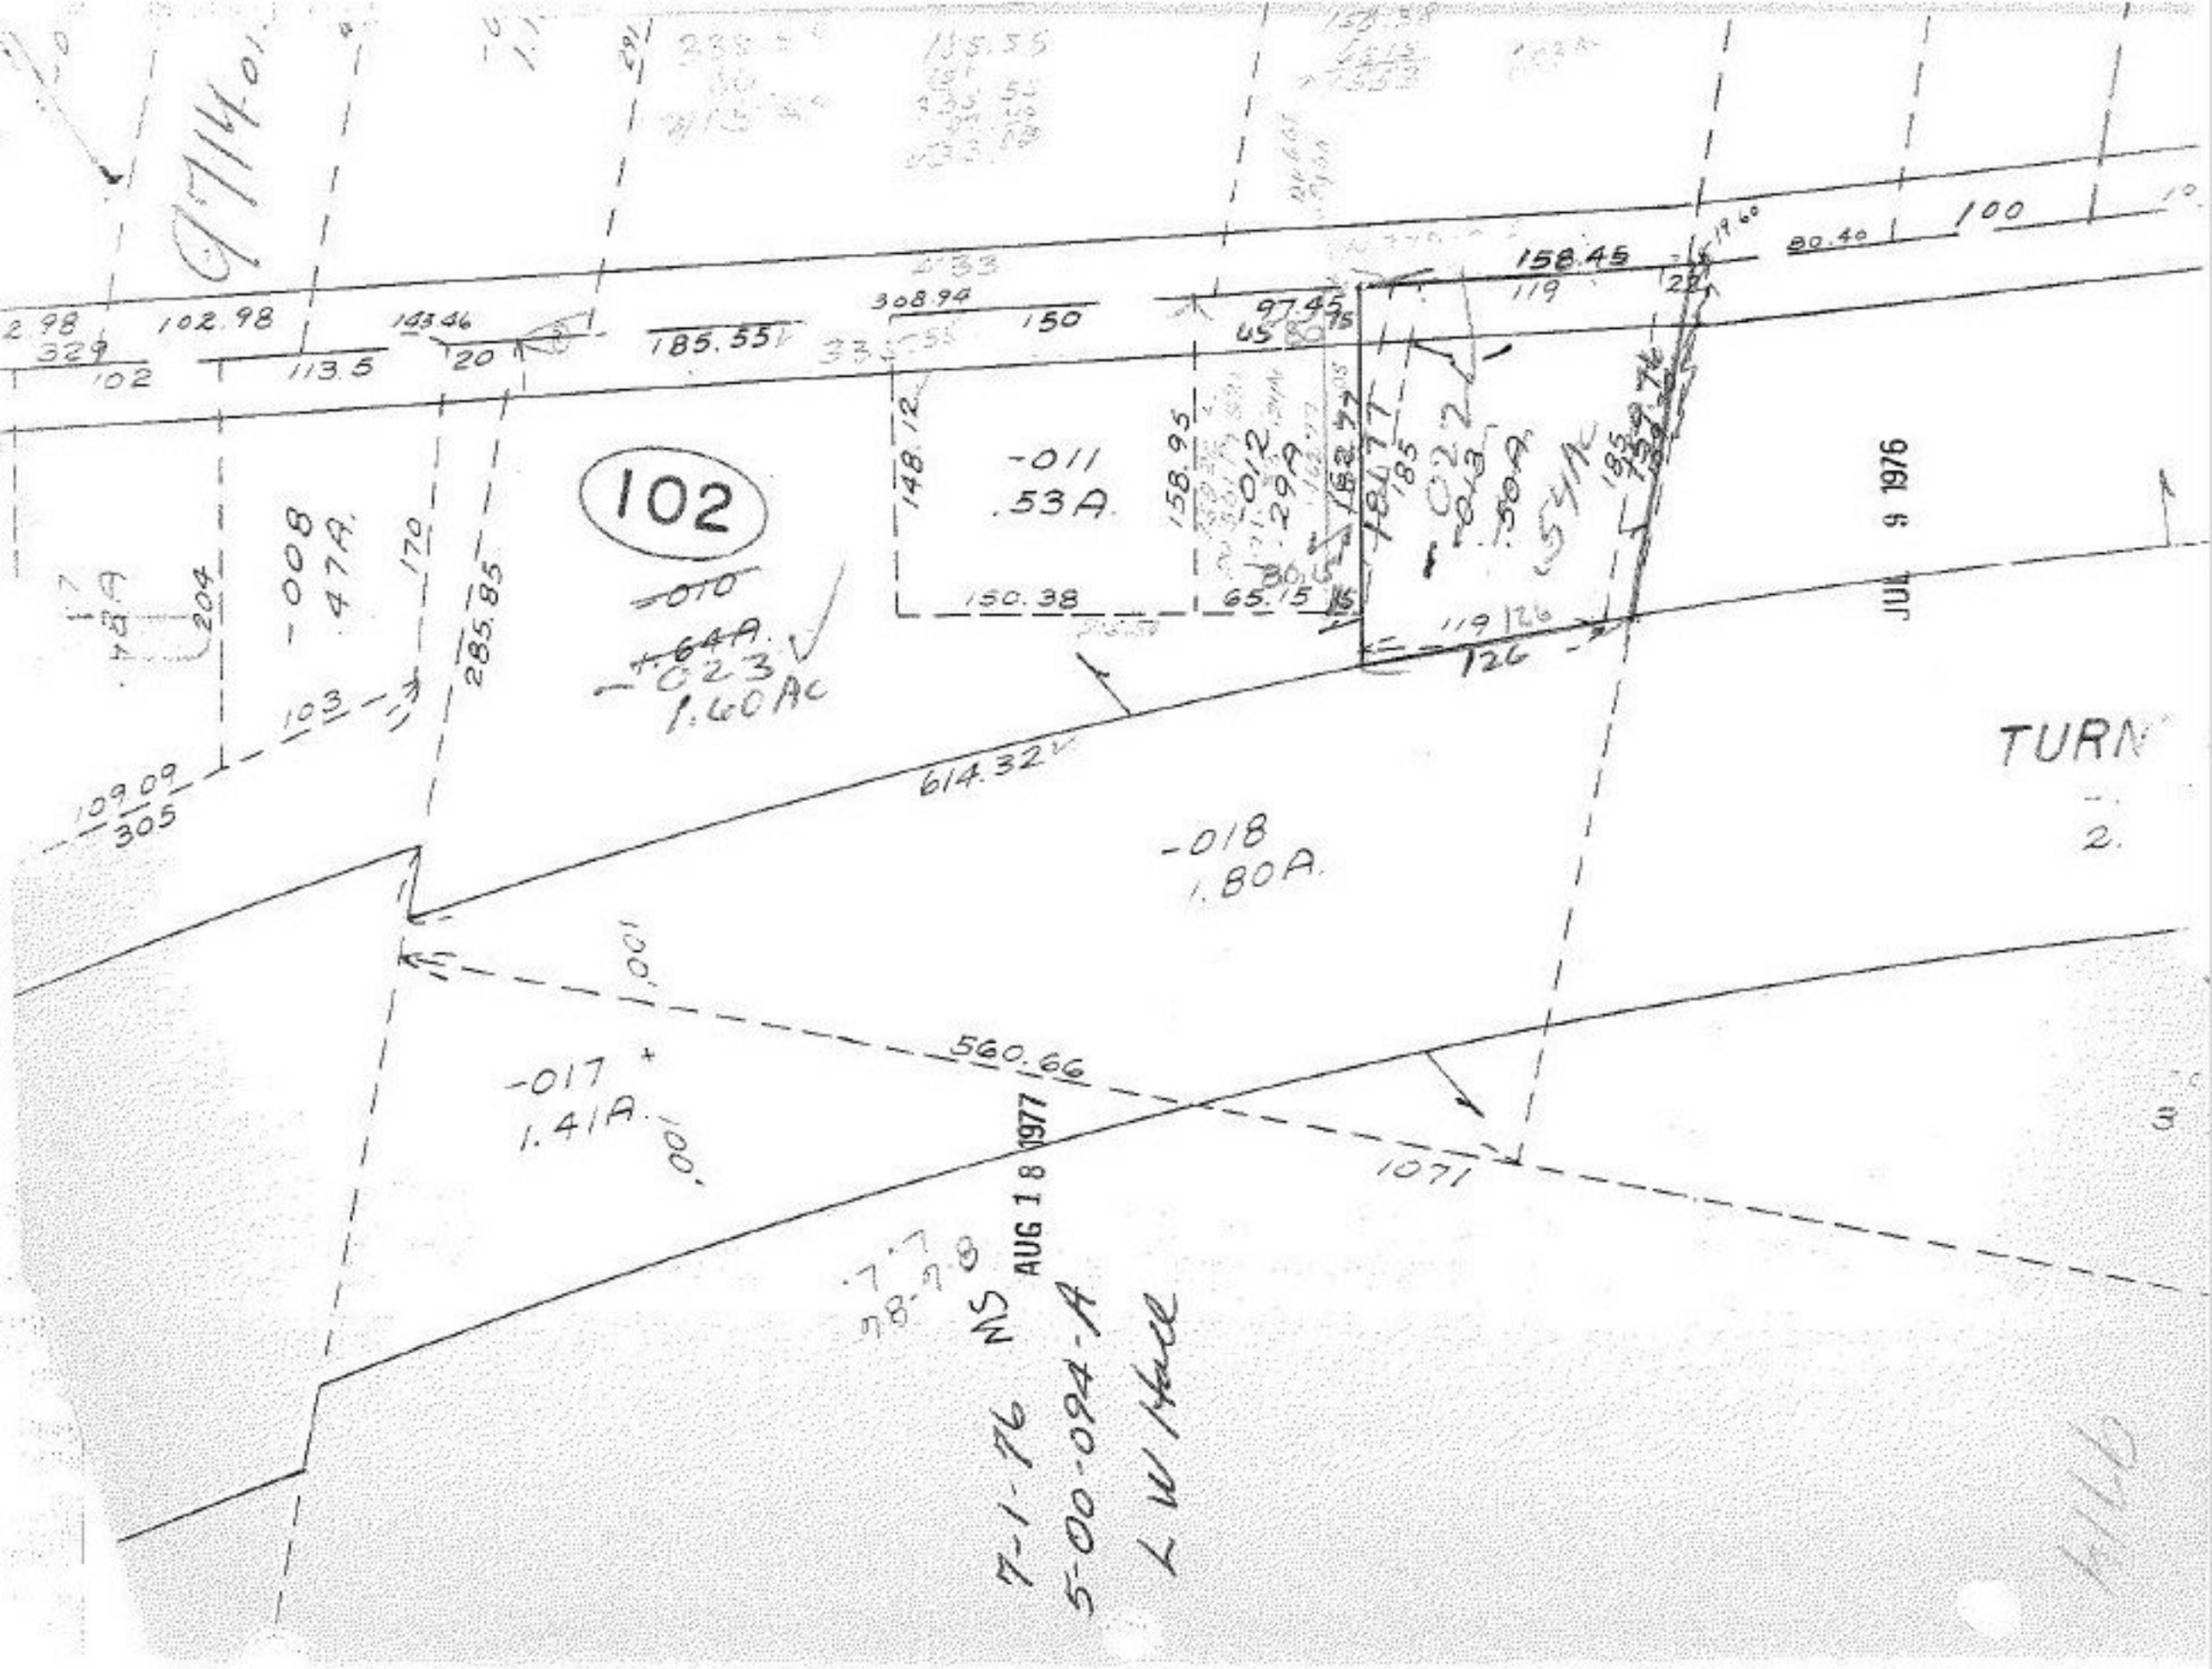

102
-011
.53A.
-008
.47A.
-010
.64A.
-023
1.60Ac
-018
1.80A.
-017
1.41A.
614.32
560.66
1071
158.45
80.40
100
102.98
113.5
185.55
308.94
150
97.45
148.12
158.95
150.38
65.15
285.85
109.09
305
103
170
204
TURN
2.
JUL 9 1976
AUG 18 1977
7-1-76 MS
5-00-094-A
L W Hall