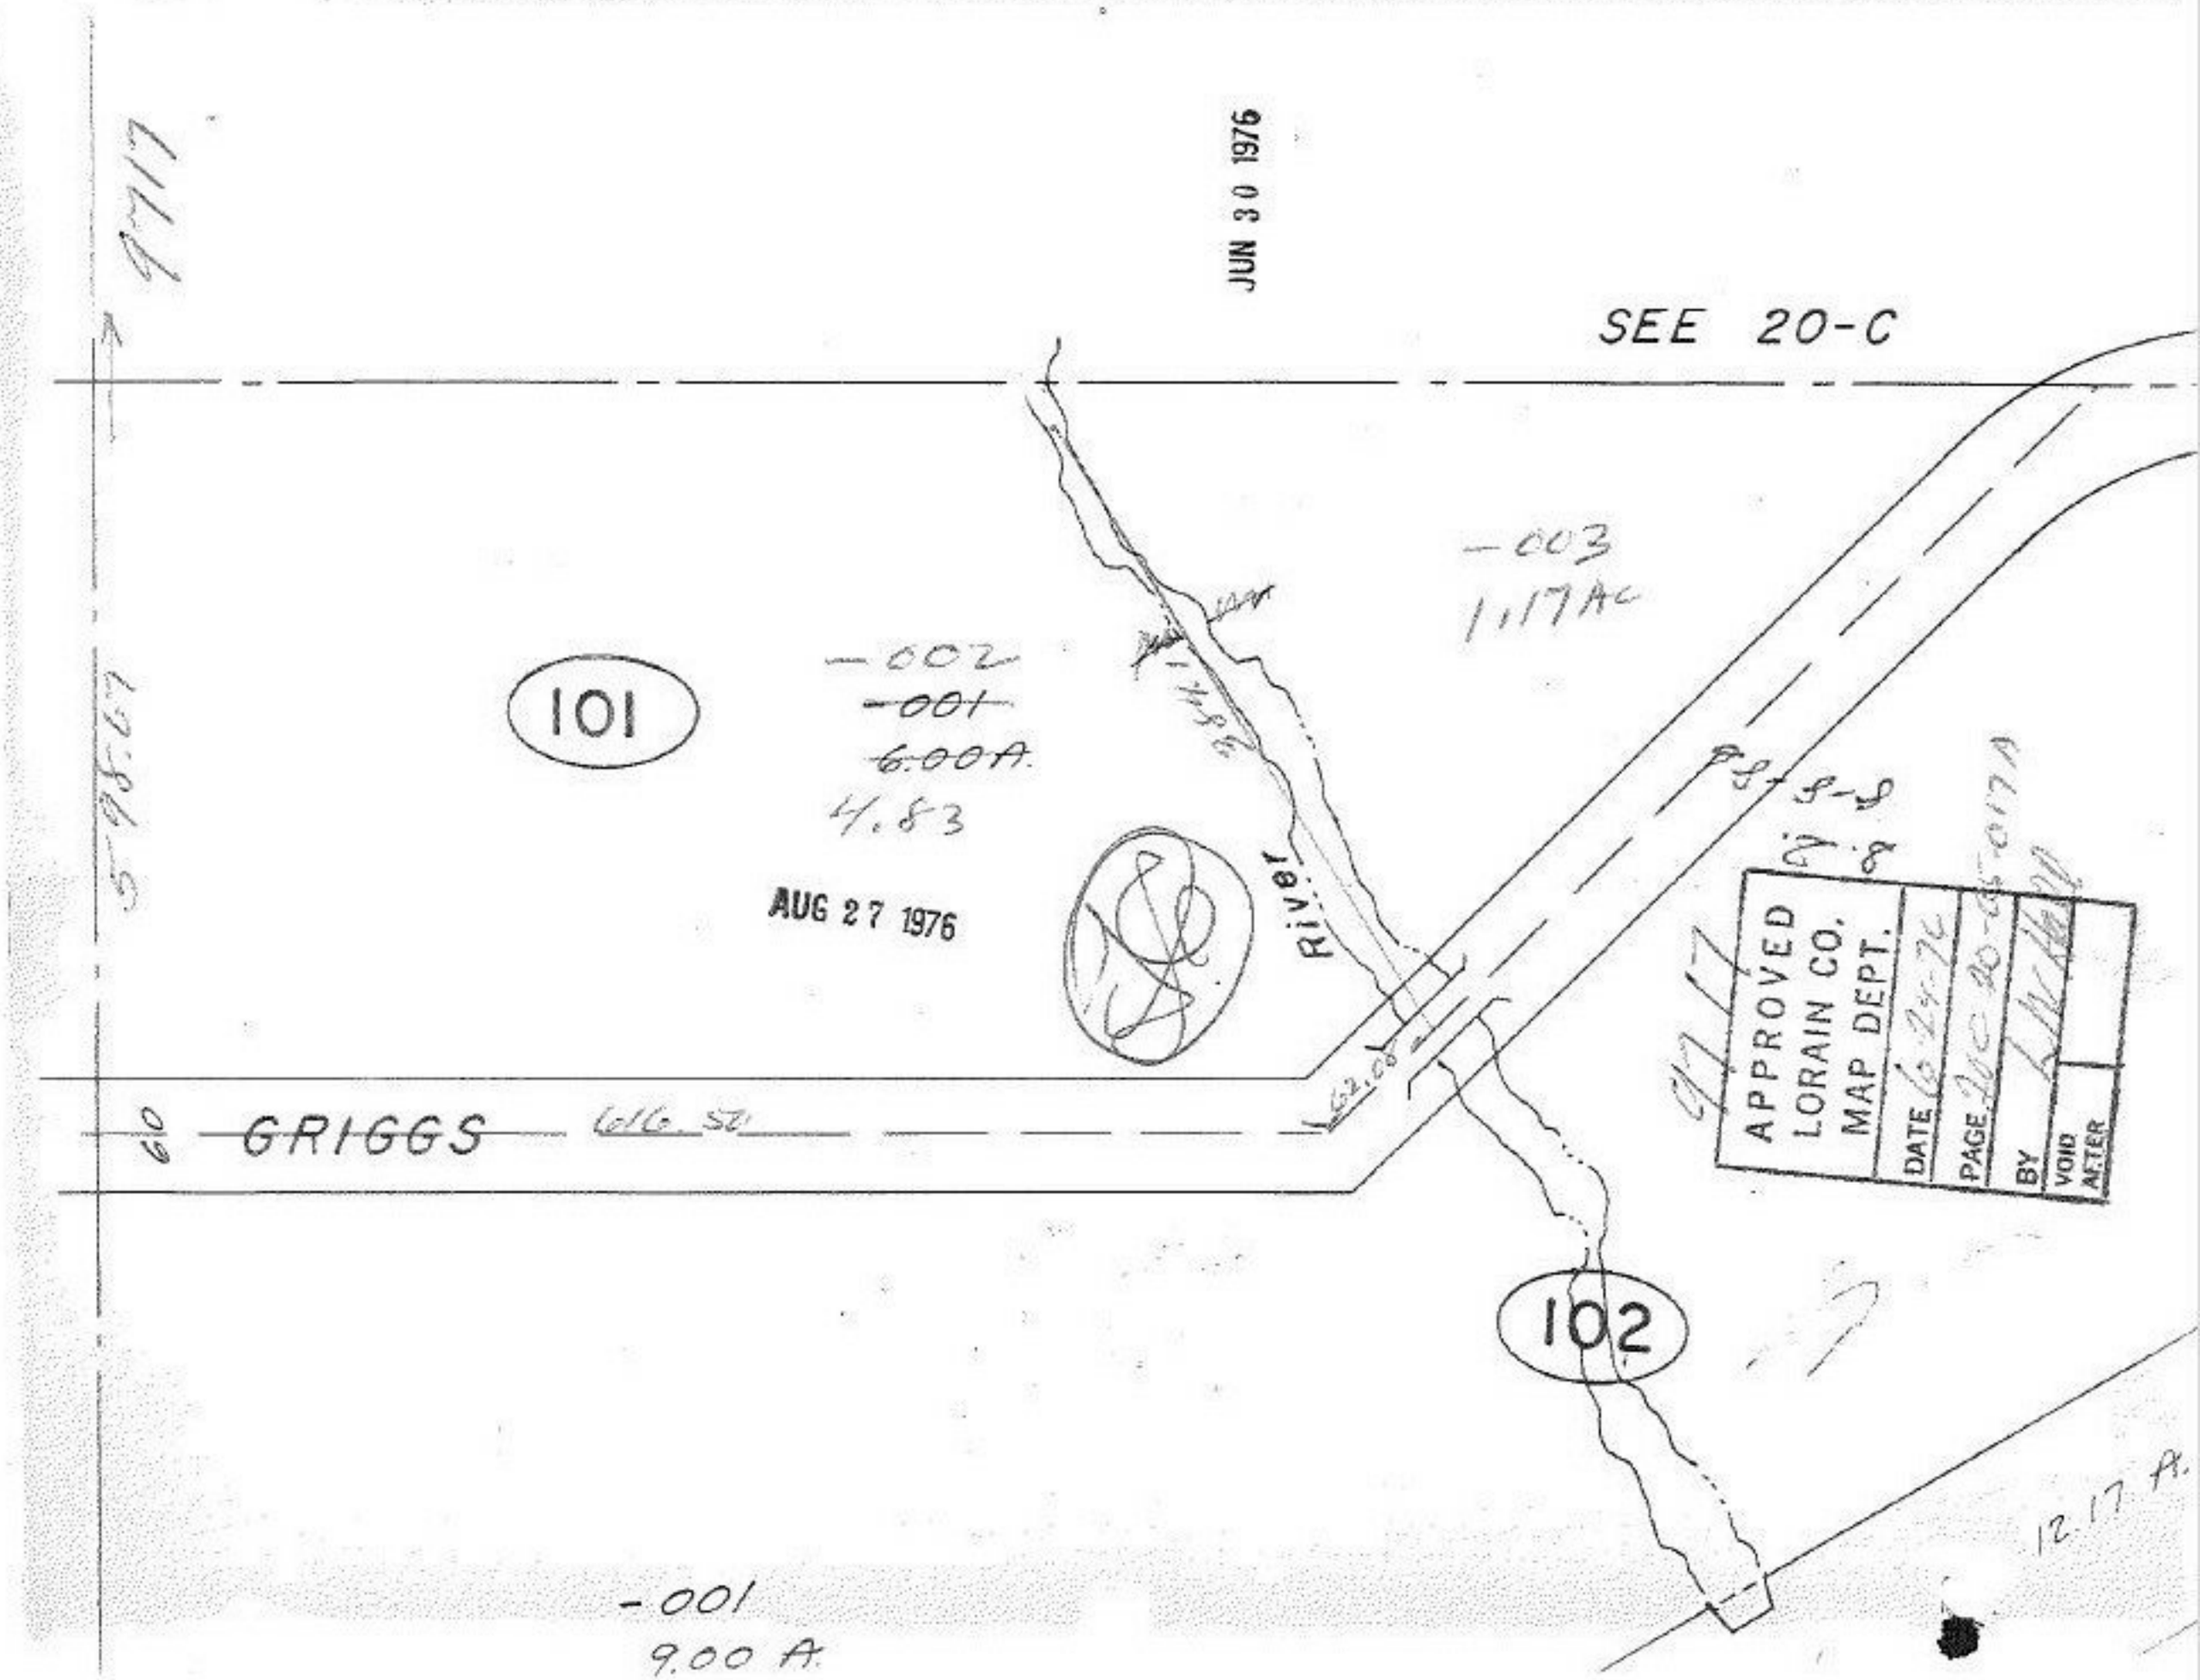

9717
JUN 30 1976
SEE 20-C
-003
1.17AC
101
-002
~~-001~~
~~6.00A.~~
4.83
AUG 27 1976
River
GRIGGS
616.50
60
102
12.17 A.
-001
9.00 A.
APPROVED
LORAIN CO.
MAP DEPT.
DATE
PAGE
BY
VOID
AFTER