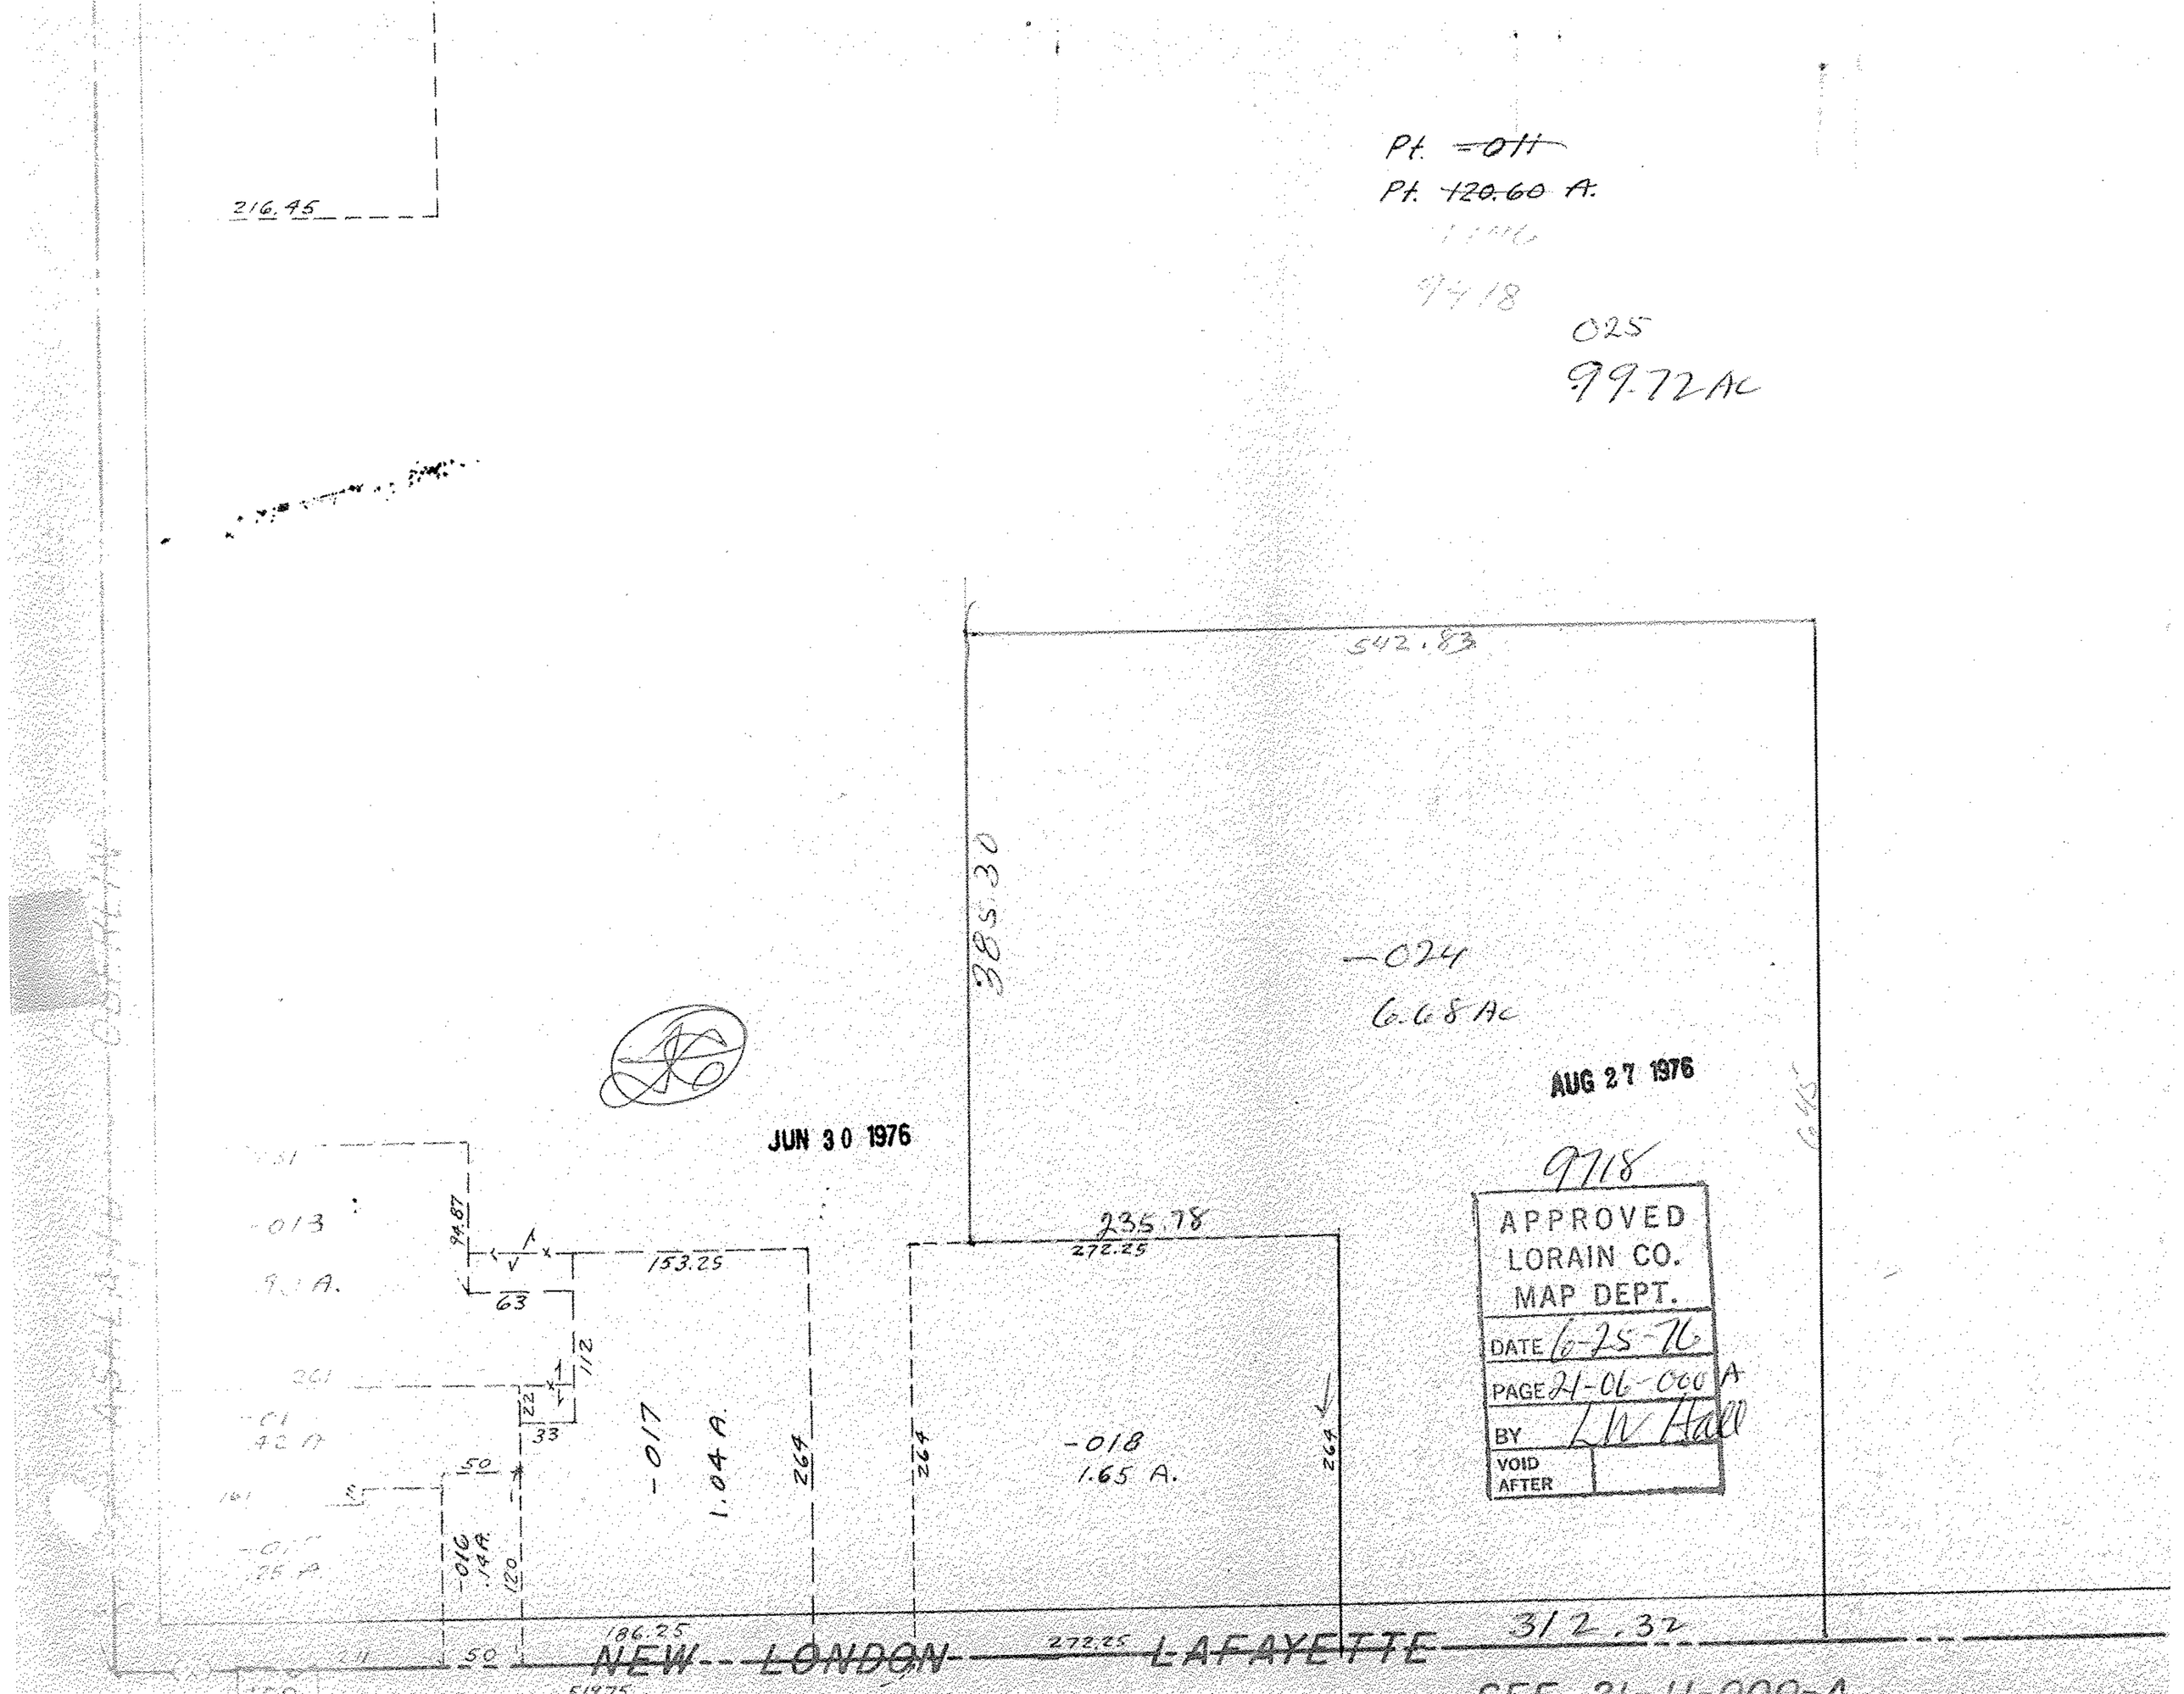

Pt. ~~-011~~
Pt. ~~120.60 A.~~
9418
025
99.72 Ac
216.45
542.83
385.30
-024
6.68 Ac
AUG 27 1976
JUN 30 1976
9718
APPROVED
LORAIN CO.
MAP DEPT.
DATE 6-25-76
PAGE 21-06-000 A
BY LW Hall
VOID AFTER
235.78
272.25
153.25
94.87
63
112
22
33
50
-017
1.04 A.
264
-018
1.65 A.
-016
.14 A.
120
186.25
272.25
312.32
NEW LONDON
LAFAYETTE