9722

JUL 6 1976

SEE 6-26

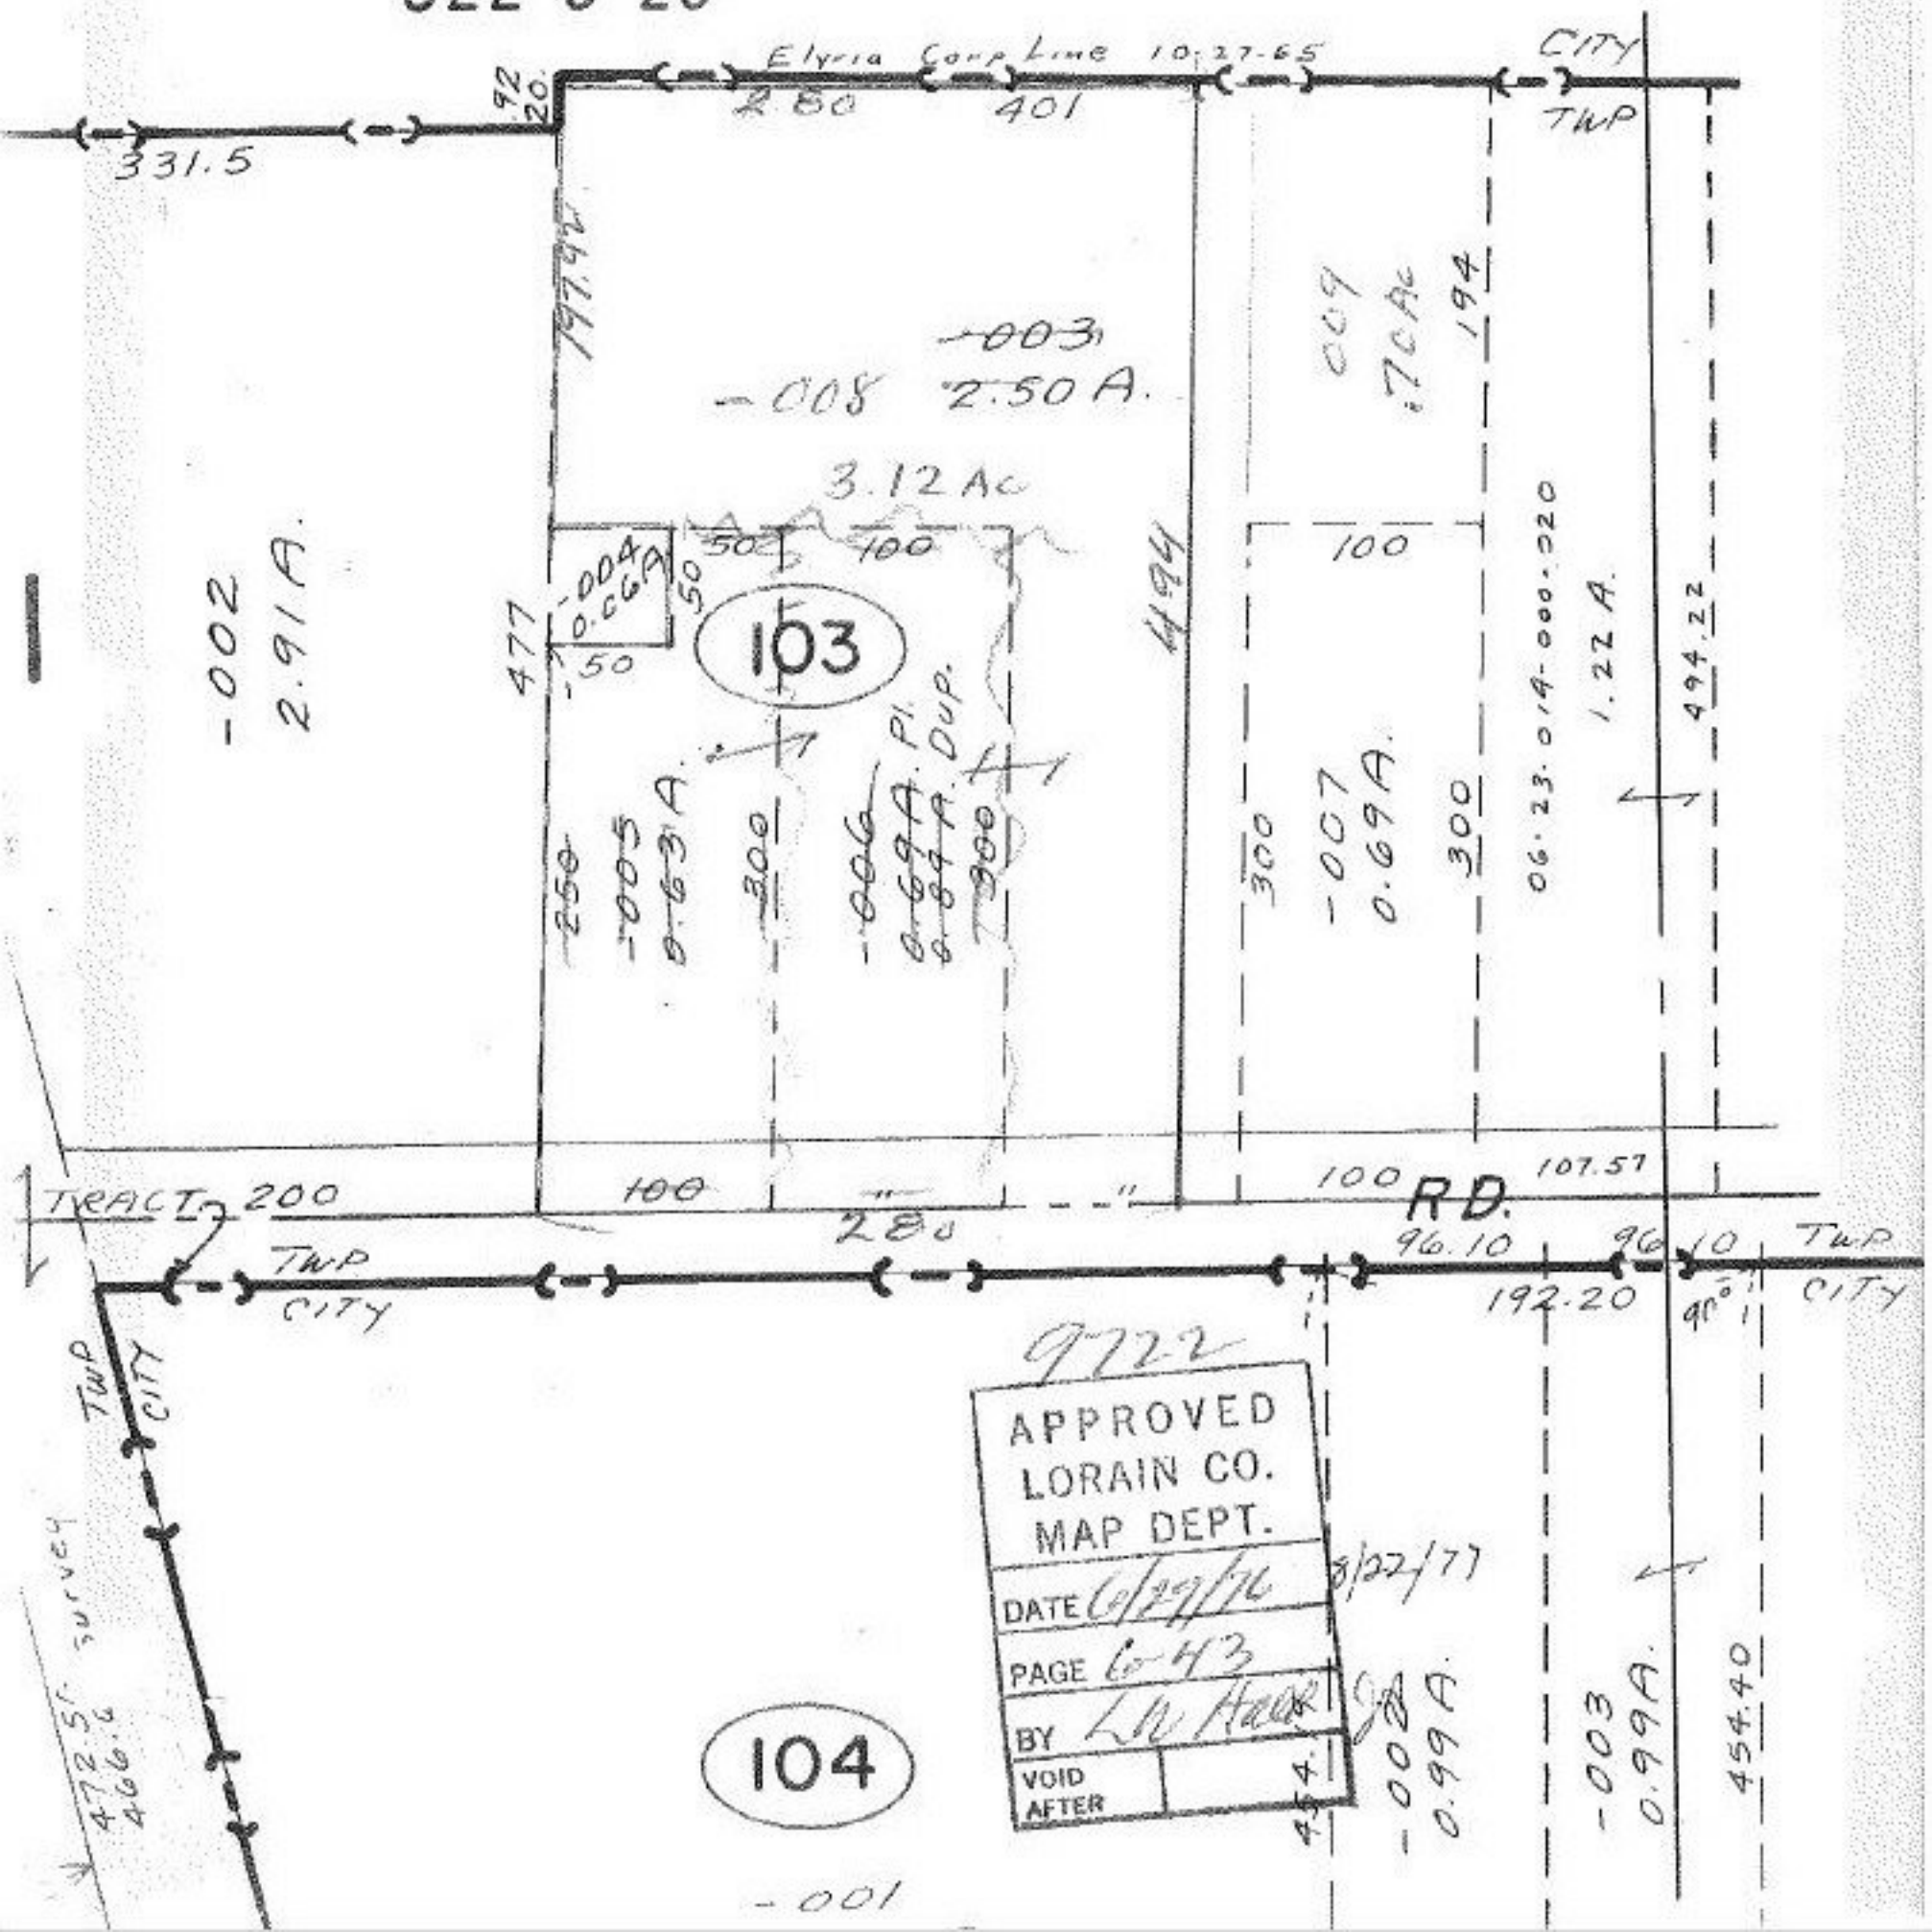

9722

APPROVED
LORAIN CO.
MAP DEPT.
DATE 6/29/76
PAGE 6-43
BY L.W. Hall
VOID AFTER

8/22/77