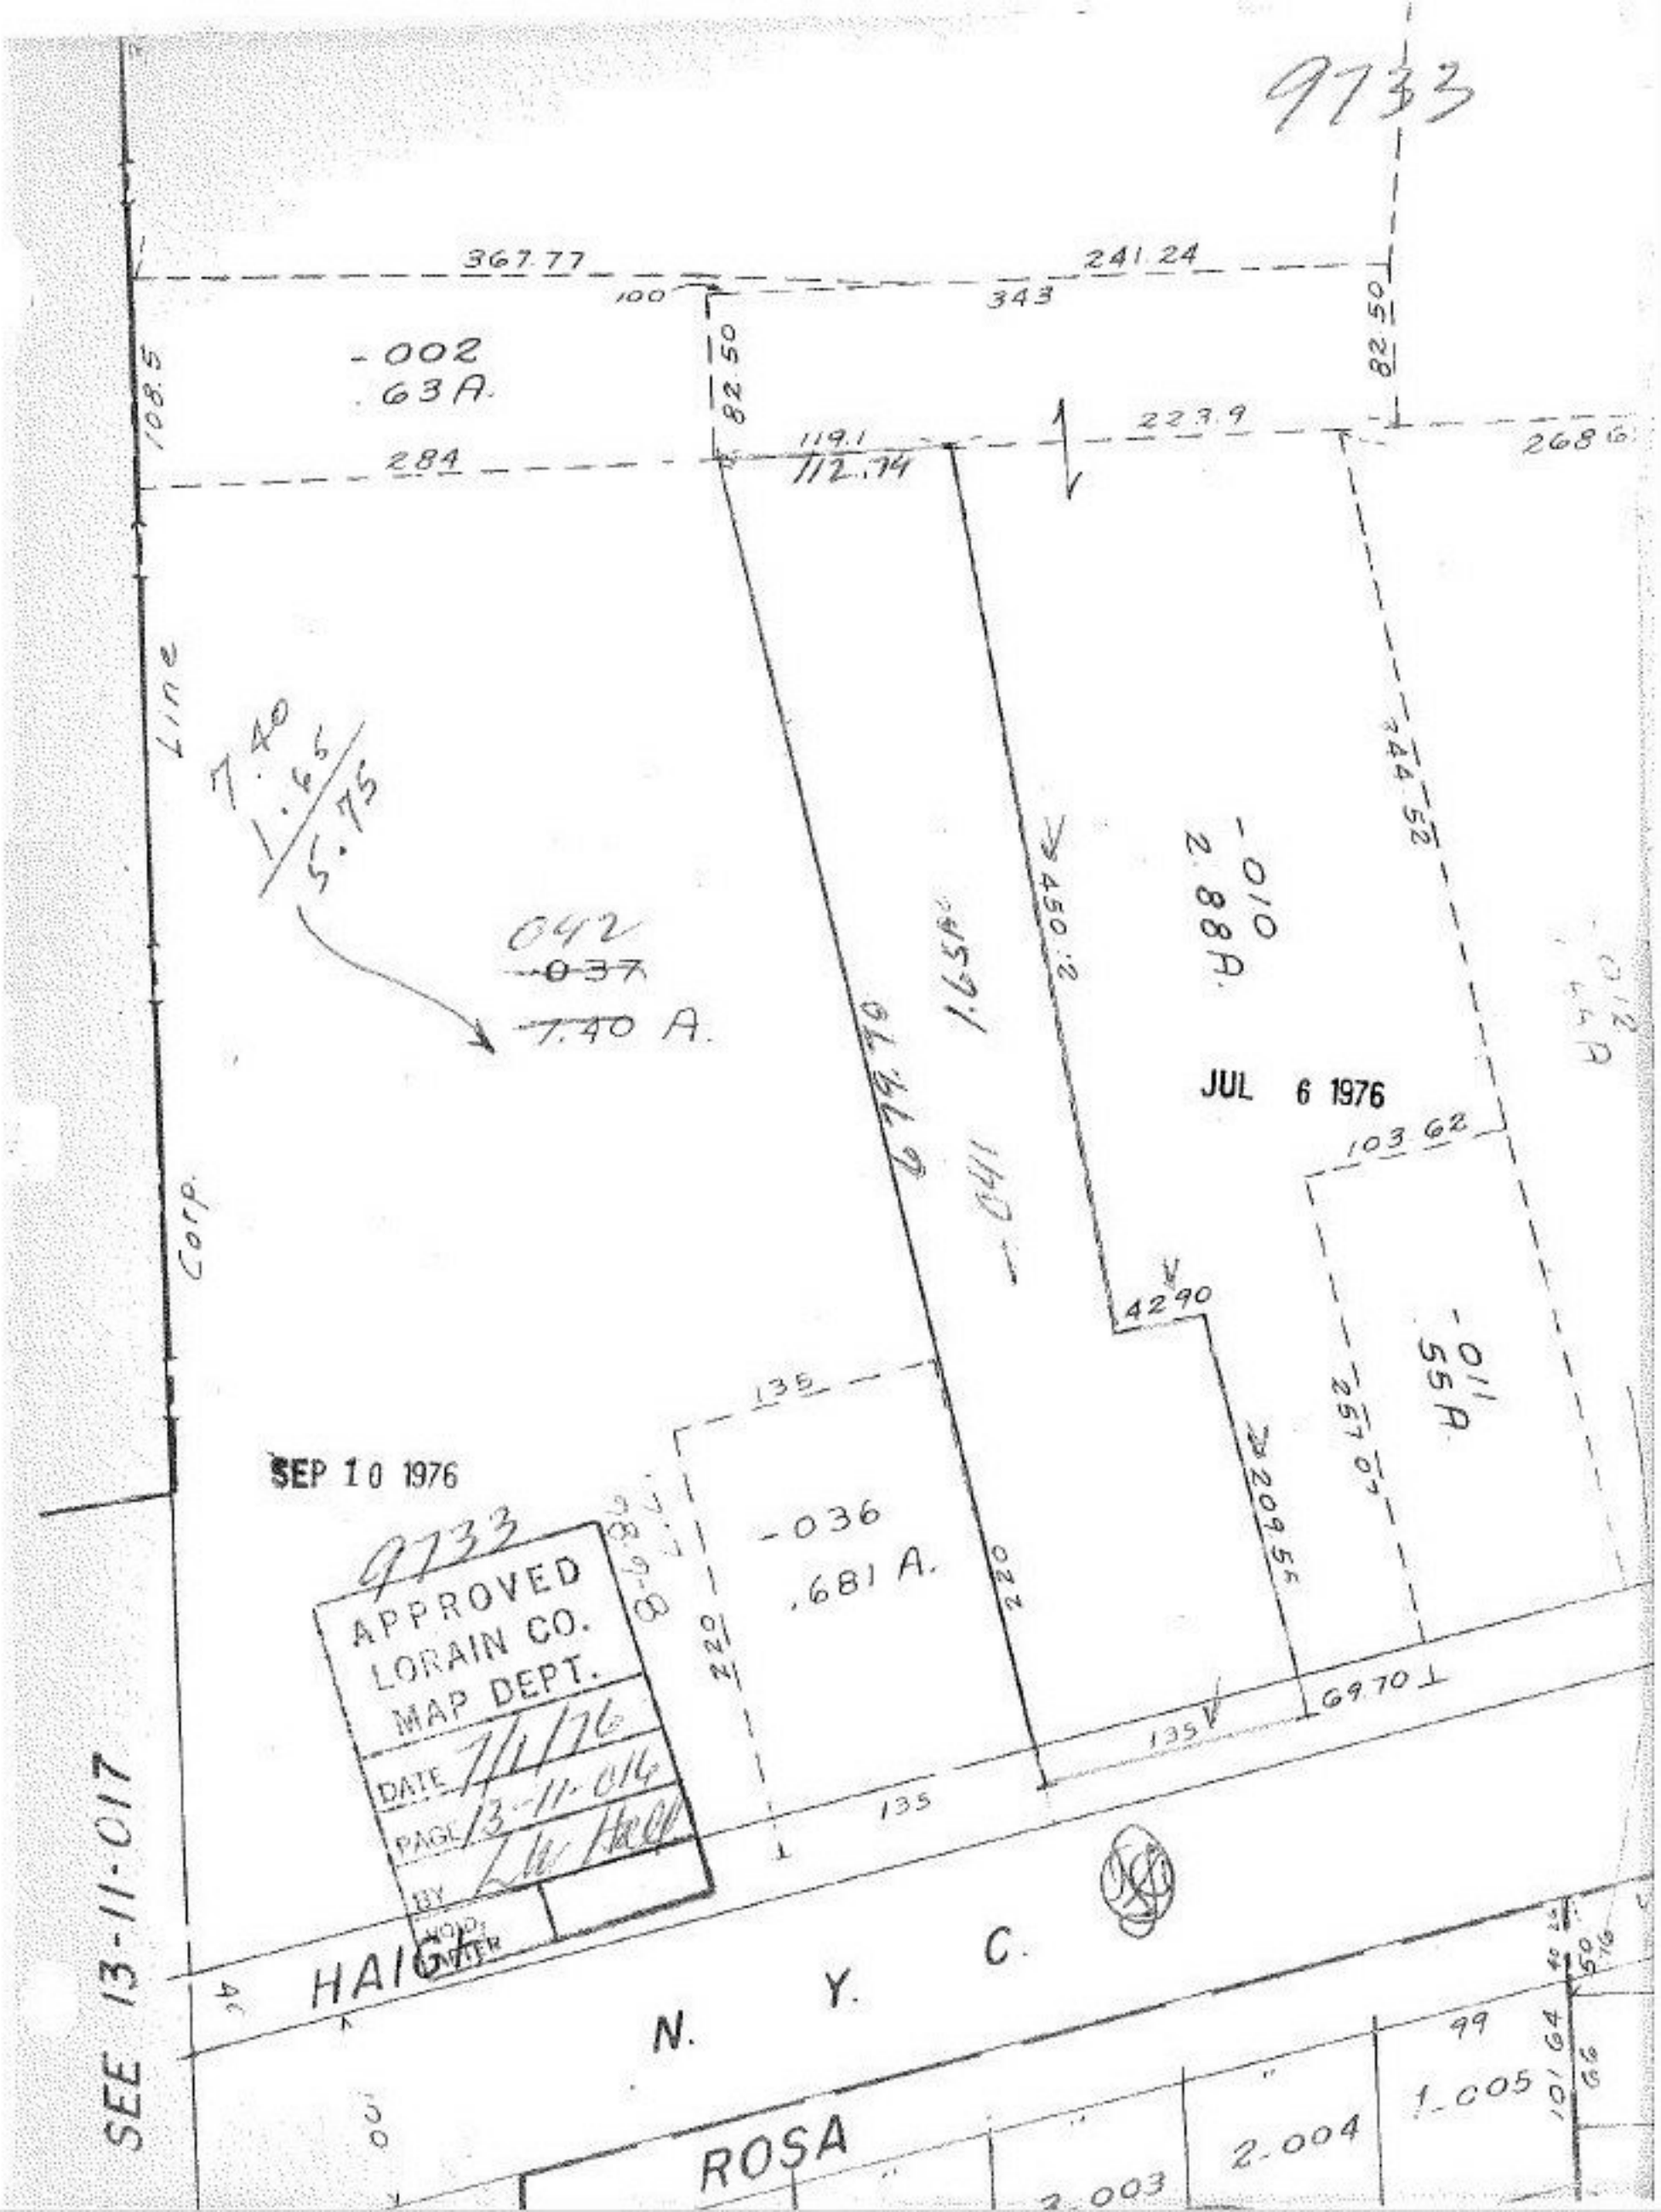
9733
367.77
241.24
100
343
82.50
82.50
108.5
-002
.63A.
284
119.1
112.74
223.9
268.6
Line
7.40
1.65
5.75
042
~~-037~~
~~7.40~~ A.
-010
2.88A.
450.2
1.65A
679.70
-041
JUL 6 1976
103.62
-011
.55A.
257.07
42.90
209.55
135
-036
.681 A.
220
220
69.70
135
135
SEP 10 1976
9733
APPROVED
LORAIN CO.
MAP DEPT.
DATE 7/1/76
PAGE 13-11-016
BY
VOID
CHECKER
SEE 13-11-017
HAIGH
N. Y. C.
ROSA
2.003
2.004
1.005
99
101.64
66
50
76